TRAFFIC ITEM AND TRAFFIC SIGN SUMMARY SHEET, NOTES AND DETAILS

MILEMARKER, STATION, OR SIGN NUMBER	SIGN LEGEND	SIGN DIMENSIONS	EXISTING SIGNS TO BE SALVAGED: REMOVE (EA.)	EXISTING SIGNS TO BE SALVAGED: RETAIN (X)	NEW AND SALVAGED SIGNS: NEW "A" (S.F.)	NEW AND SALVAGED SIGNS: NEW "B" (S.F.)	NEW AND SALVAGED SIGNS: SALV. SIGN (EA.)	NEW AND SALVAGED SIGNS: SALV. T.I.S. (S.F.)	EXISTING POSTS: RET.	EXISTING POSTS: DRILL	EXISTING POSTS: REM.	EXISTING POSTS: SALV.	NEW SIGN POSTS: NUMBER OF POSTS	FLANGED CHANNEL: 2.0 LB./FT.	FLANGED CHANNEL: 2.5 LB./FT.	FLANGED CHANNEL: 3.0 LB./FT.	TUBULAR ALUMINUM: 3.0" Ø	TUBULAR ALUMINUM: 3.0" □	TUBULAR ALUMINUM: 4.0" Ø	TUBULAR ALUMINUM: 4.0" Ø MOD.	W SHAPED STEEL: POST SIZE	W SHAPED STEEL: WEIGHT	W SHAPED STEEL: FTG. SIZE 24"	W SHAPED STEEL: FTG. SIZE 30"	REMARKS	FOR SIGN DETAIL SHEET: PLAN SHEET NUMBER	FOR SIGN DETAIL SHEET: STD. SHEET NUMBER

TRAFFIC ITEM SUMMARY

ITEM NO.	ITEM	SHEET TD 537	SHEET TD 538	SHEET TD 539	SHEET TD 540	SHEET TD 541	UNIT	RND.	TOTAL
675.10	TRAFFIC SIGNS, TYPE A	101.7	138	104.3	113.2	69.8	S.F.	3	530
675.21	TRAFFIC SIGNS, TYPE B	302				242.3	S.F.	5.7	550
675.30	FLANGED CHANNEL SIGN POSTS	371	521	322	446	210	LBS.		1870
675.32	TUBULAR ALUMINUM SIGN POSTS		106.4	136.8	152	114	LBS.	0.8	510
675.50	REMOVING SIGNS	16	19	16	20	21	EA.		92
676.10	DELINEATORS WITH STEEL POSTS						EA.		26
676.12	REMOVAL OF EXIST. DELINEATORS						EA		200
676.15	REMOVE AND REPLACE REFLECTOR UNITS (GUARDRAIL)						EA		30
676.20	DELINEATORS W/ FLEXIBLE POST						EA		30 → 13 UNITS TO BE FURNISHED WITH REFLECTOR ON BOTH SIDES.
680.20	TRAVEL INFORMATION SIGN				10		S.F.		10

SEE SHEET TD 504 FOR PROJECT SUMMARY OF QUANTITIES AND REVISION NOTE FOR LEGAL LOAD LIMIT SIGNING.

NOTES AND DETAILS

12'-6" IS EXAMPLE ONLY. ACTUAL CLEARANCE FOR SIGN IS 13'-11". COMPRESS SPACING AND/OR CHANGE TO "C" SERIES IF NECESSARY.

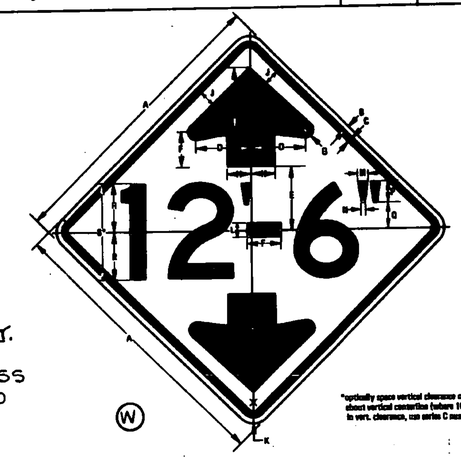

*optically space vertical clearance numerals about vertical centerline (where 10" is used in vert. clearance, use series C numerals)

SIGN	DIMENSIONS (INCHES) A	B	C	D	E	F	G	H	J	K	L	M	N	P	Q	R	S
STD. & EXPWY.	36	5/16	7/8	6-7/8	8	4-1/2	1	3	2	2-1/4	1-7/8	1-1/4	1/2	2-3/4	4	8	120

TRAFFIC SHEET NO. TD 542 SHEET ___ OF ___

DRAWN BY _____ DATE _____

CHKED BY _____ DATE _____

BERLIN - BARRE

STATEWIDE PROJ. NO. F-SFTY (85)

SHEET 96 OF 200

BRUNING S3428-3