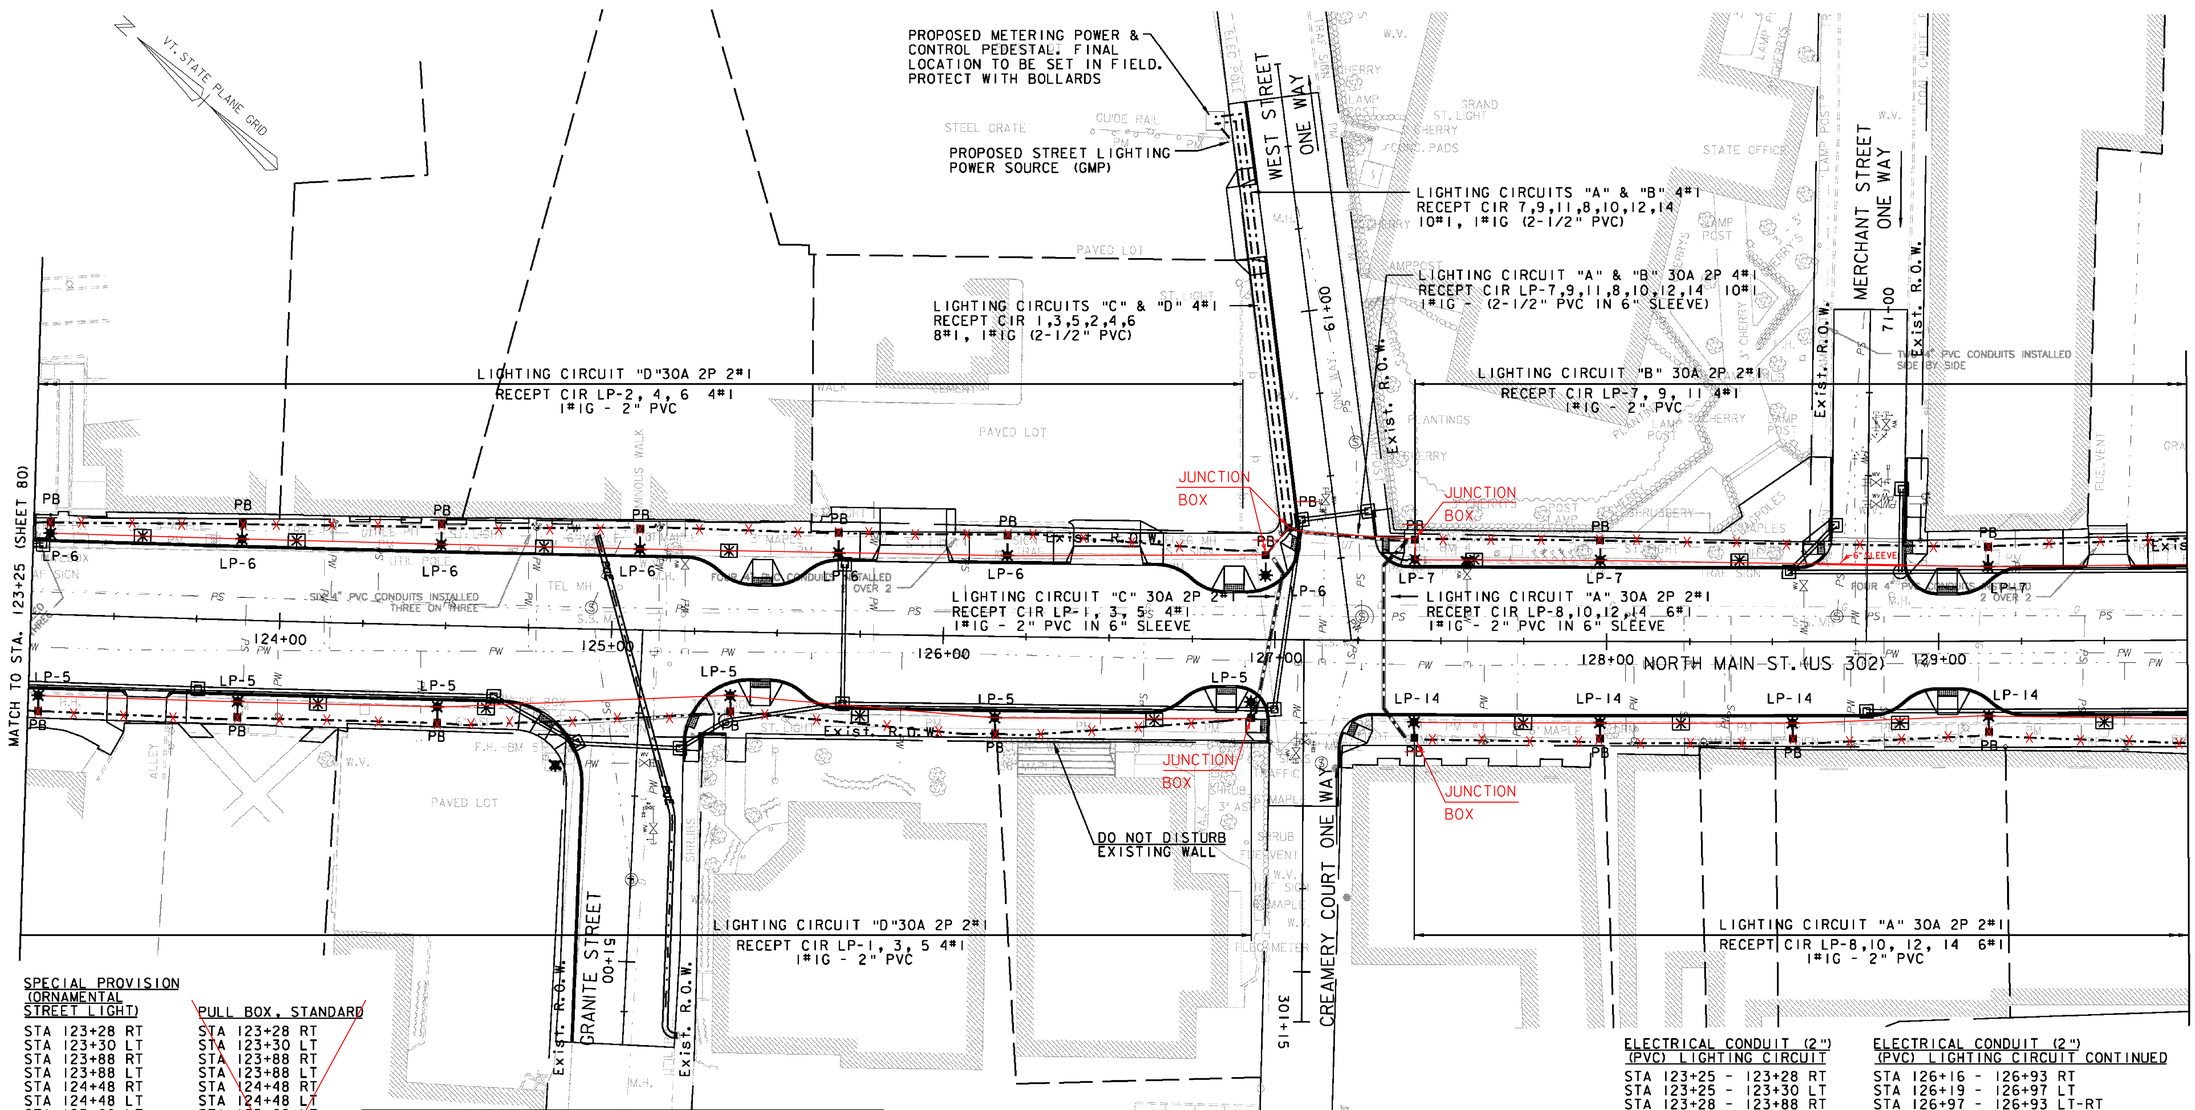

SPECIAL PROVISION (ORNAMENTAL STREET LIGHT)

STA 123+28 RT
STA 123+30 LT
STA 123+88 RT
STA 123+88 LT
STA 124+48 RT
STA 124+48 LT
STA 125+08 LT
STA 125+36 RT
STA 125+68 LT
STA 126+16 RT
STA 126+19 LT
STA 126+93 RT
STA 126+97 LT
STA 127+42 RT
STA 127+42 LT
STA 127+98 RT
STA 127+98 LT
STA 128+56 RT
STA 129+15 RT
STA 129+15 LT

~~PULL BOX, STANDARD~~

~~STA 123+28 RT~~
~~STA 123+30 LT~~
~~STA 123+88 RT~~
~~STA 123+88 LT~~
~~STA 124+48 RT~~
~~STA 124+48 LT~~
~~STA 125+08 LT~~
~~STA 125+36 RT~~
~~STA 125+68 LT~~
~~STA 126+16 RT~~
~~STA 126+19 LT~~
~~STA 126+93 RT~~
~~STA 126+97 LT~~
~~STA 127+42 RT~~
~~STA 127+42 LT~~
~~STA 127+98 RT~~
~~STA 127+98 LT~~
~~STA 128+56 RT~~
~~STA 129+15 RT~~
~~STA 129+15 LT~~
~~SL STA 60+35 LT~~

LEGEND:

- PROPOSED DECIDUOUS TREE
- PROPOSED DECIDUOUS TREE WITH 4' x 5' TREE PIT
- PROPOSED SMALL DECIDUOUS SHADE TREE
- PROPOSED LIGHTING CONDUIT
- PROPOSED LIGHTING CONDUIT & SLEEVE
- PB PROPOSED PULLBOX
- PROPOSED ORNAMENTAL STREET LIGHT
- PROPOSED SIGNAL POLE WITH LUMINAIRE
- PROPOSED FAIRPOINT DUCT BANK CONDUIT

ELECTRICAL CONDUIT (2.5") (PVC) - LIGHTING CIRCUIT

STA 126+97 LT - SL STA 60+36 LT
STA 127+42 LT - SL STA 60+36 LT
SL STA 60+36 - 61+60 LT
SL STA 60+36 - 61+60 LT

BOLLARDS

SL STA 61+60 LT (4)

ELECTRICAL CONDUIT SLEEVE (6") (PVC)

STA 124+82 - 125+26 RT
STA 126+96 - 126+99 RT-LT
STA 127+04 - 127+40 LT
STA 127+39 - 127+40 LT-RT
STA 128+66 - 128+91 LT

JUNCTION ~~PULL BOX, STANDARD~~

1 SL STA 60+36 LT
2 } LOCATED @
3 } WEST ST. INTERSECTION
4 }

ELECTRICAL CONDUIT (2") (PVC) LIGHTING CIRCUIT

STA 123+25 - 123+28 RT
STA 123+25 - 123+30 LT
STA 123+28 - 123+88 RT
STA 123+30 - 123+88 LT
STA 123+88 - 124+48 RT
STA 123+88 - 124+48 LT
STA 124+48 - 125+08 LT
STA 124+48 - 125+36 RT
STA 125+08 - 125+68 LT
STA 125+36 - 126+16 RT
STA 125+68 - 126+19 LT

ELECTRICAL CONDUIT (2") (PVC) LIGHTING CIRCUIT CONTINUED

STA 126+16 - 126+93 RT
STA 126+19 - 126+97 LT
STA 126+97 - 126+93 LT-RT
STA 127+42 - 127+42 LT-RT
STA 127+42 - 127+98 RT
STA 127+42 - 127+98 LT
STA 127+98 - 128+56 RT
STA 127+98 - 129+15 LT
STA 128+56 - 129+15 RT
STA 129+15 - 129+75 LT
STA 129+15 - 129+75 RT

NOTES:

1. THESE PLANS DEPICT ACTUAL PROPOSED STREET LIGHT LOCATIONS, WHEREAS PULLBOX AND CONDUIT LOCATIONS ARE SCHEMATIC AND ARE INTENDED TO SHOW REQUIRED CONNECTIONS, WITH FINAL POSITIONS TO BE SET IN FIELD.

20 0 20 40
FEET

VHB Vanasse Hangen Brustlin, Inc.

PROJECT NAME:	BARRE CITY
PROJECT NUMBER:	FEGC F 026-1(34) C/2
FILE NAME: z85b010bdr_lt_C2	PLOT DATE: 3/9/2011
PROJECT LEADER: G. BAKOS	DRAWN BY: D. PECK
DESIGNED BY: D. PECK	CHECKED BY:
STREET LIGHTING PLAN #3	SHEET 81 OF 339