

LETTER OR SYMBOL

STA 138+19 RT ("ONLY")
 STA 138+38 RT (RIGHT ARROW)
 STA 138+39 RT (LEFT ARROW)
 STA 139+83 LT (RIGHT ARROW)
 STA 139+84 RT (LEFT ARROW)
 STA 500+65 LT (RIGHT ARROW)
 SL STA 500+78 RT (LEFT/THRU)
 SL STA 501+05 LT ("ONLY")
 SL STA 501+45 LT (RIGHT ARROW)
 SL STA 501+45 RT (LEFT/THRU)
 SL STA 600+52 LT (LEFT ARROW)
 SL STA 600+92 LT ("ONLY")
 SL STA 601+36 RT (RIGHT ARROW)
 SL STA 601+38 LT (LEFT ARROW)
 SL STA 601+87 RT ("ONLY")
 SL STA 602+39 RT (RIGHT ARROW)
 SL STA 603+52 RT (LEFT ARROW)
 SL STA 700+74 CL (LEFT ARROW)
 SL STA 701+42 CL ("ONLY")

ERECTING SALVAGED SIGNS


STA 138+35 RT (5 SIGNS)
 SL STA 601+22 CL (2 SIGNS)

REMOVE SIGNS (TYPE A)

STA 136+12 LT
 STA 136+50 LT
 STA 136+64 RT
 STA 137+06 RT
 STA 137+96 RT
 STA 138+35 RT (7 SIGNS)
 STA 139+85 LT (2 SIGNS)
 SL STA 600+44 CL (4 SIGNS)
 SL STA 601+00 CL (5 SIGNS)
 SL STA 602+56 RT (3 SIGNS)

24 INCH STOP BAR

STA 138+43 RT
 STA 138+52 - 138+62 RT
 STA 138+75 RT
 STA 139+77 LT-RT
 SL STA 500+59 RT
 SL STA 600+47 LT
 SL STA 602+45 - 602+46 RT
 SL STA 603+36 LT
 SL STA 603+46 RT
 SL STA 700+52 LT
 SL STA 700+68 LT-RT

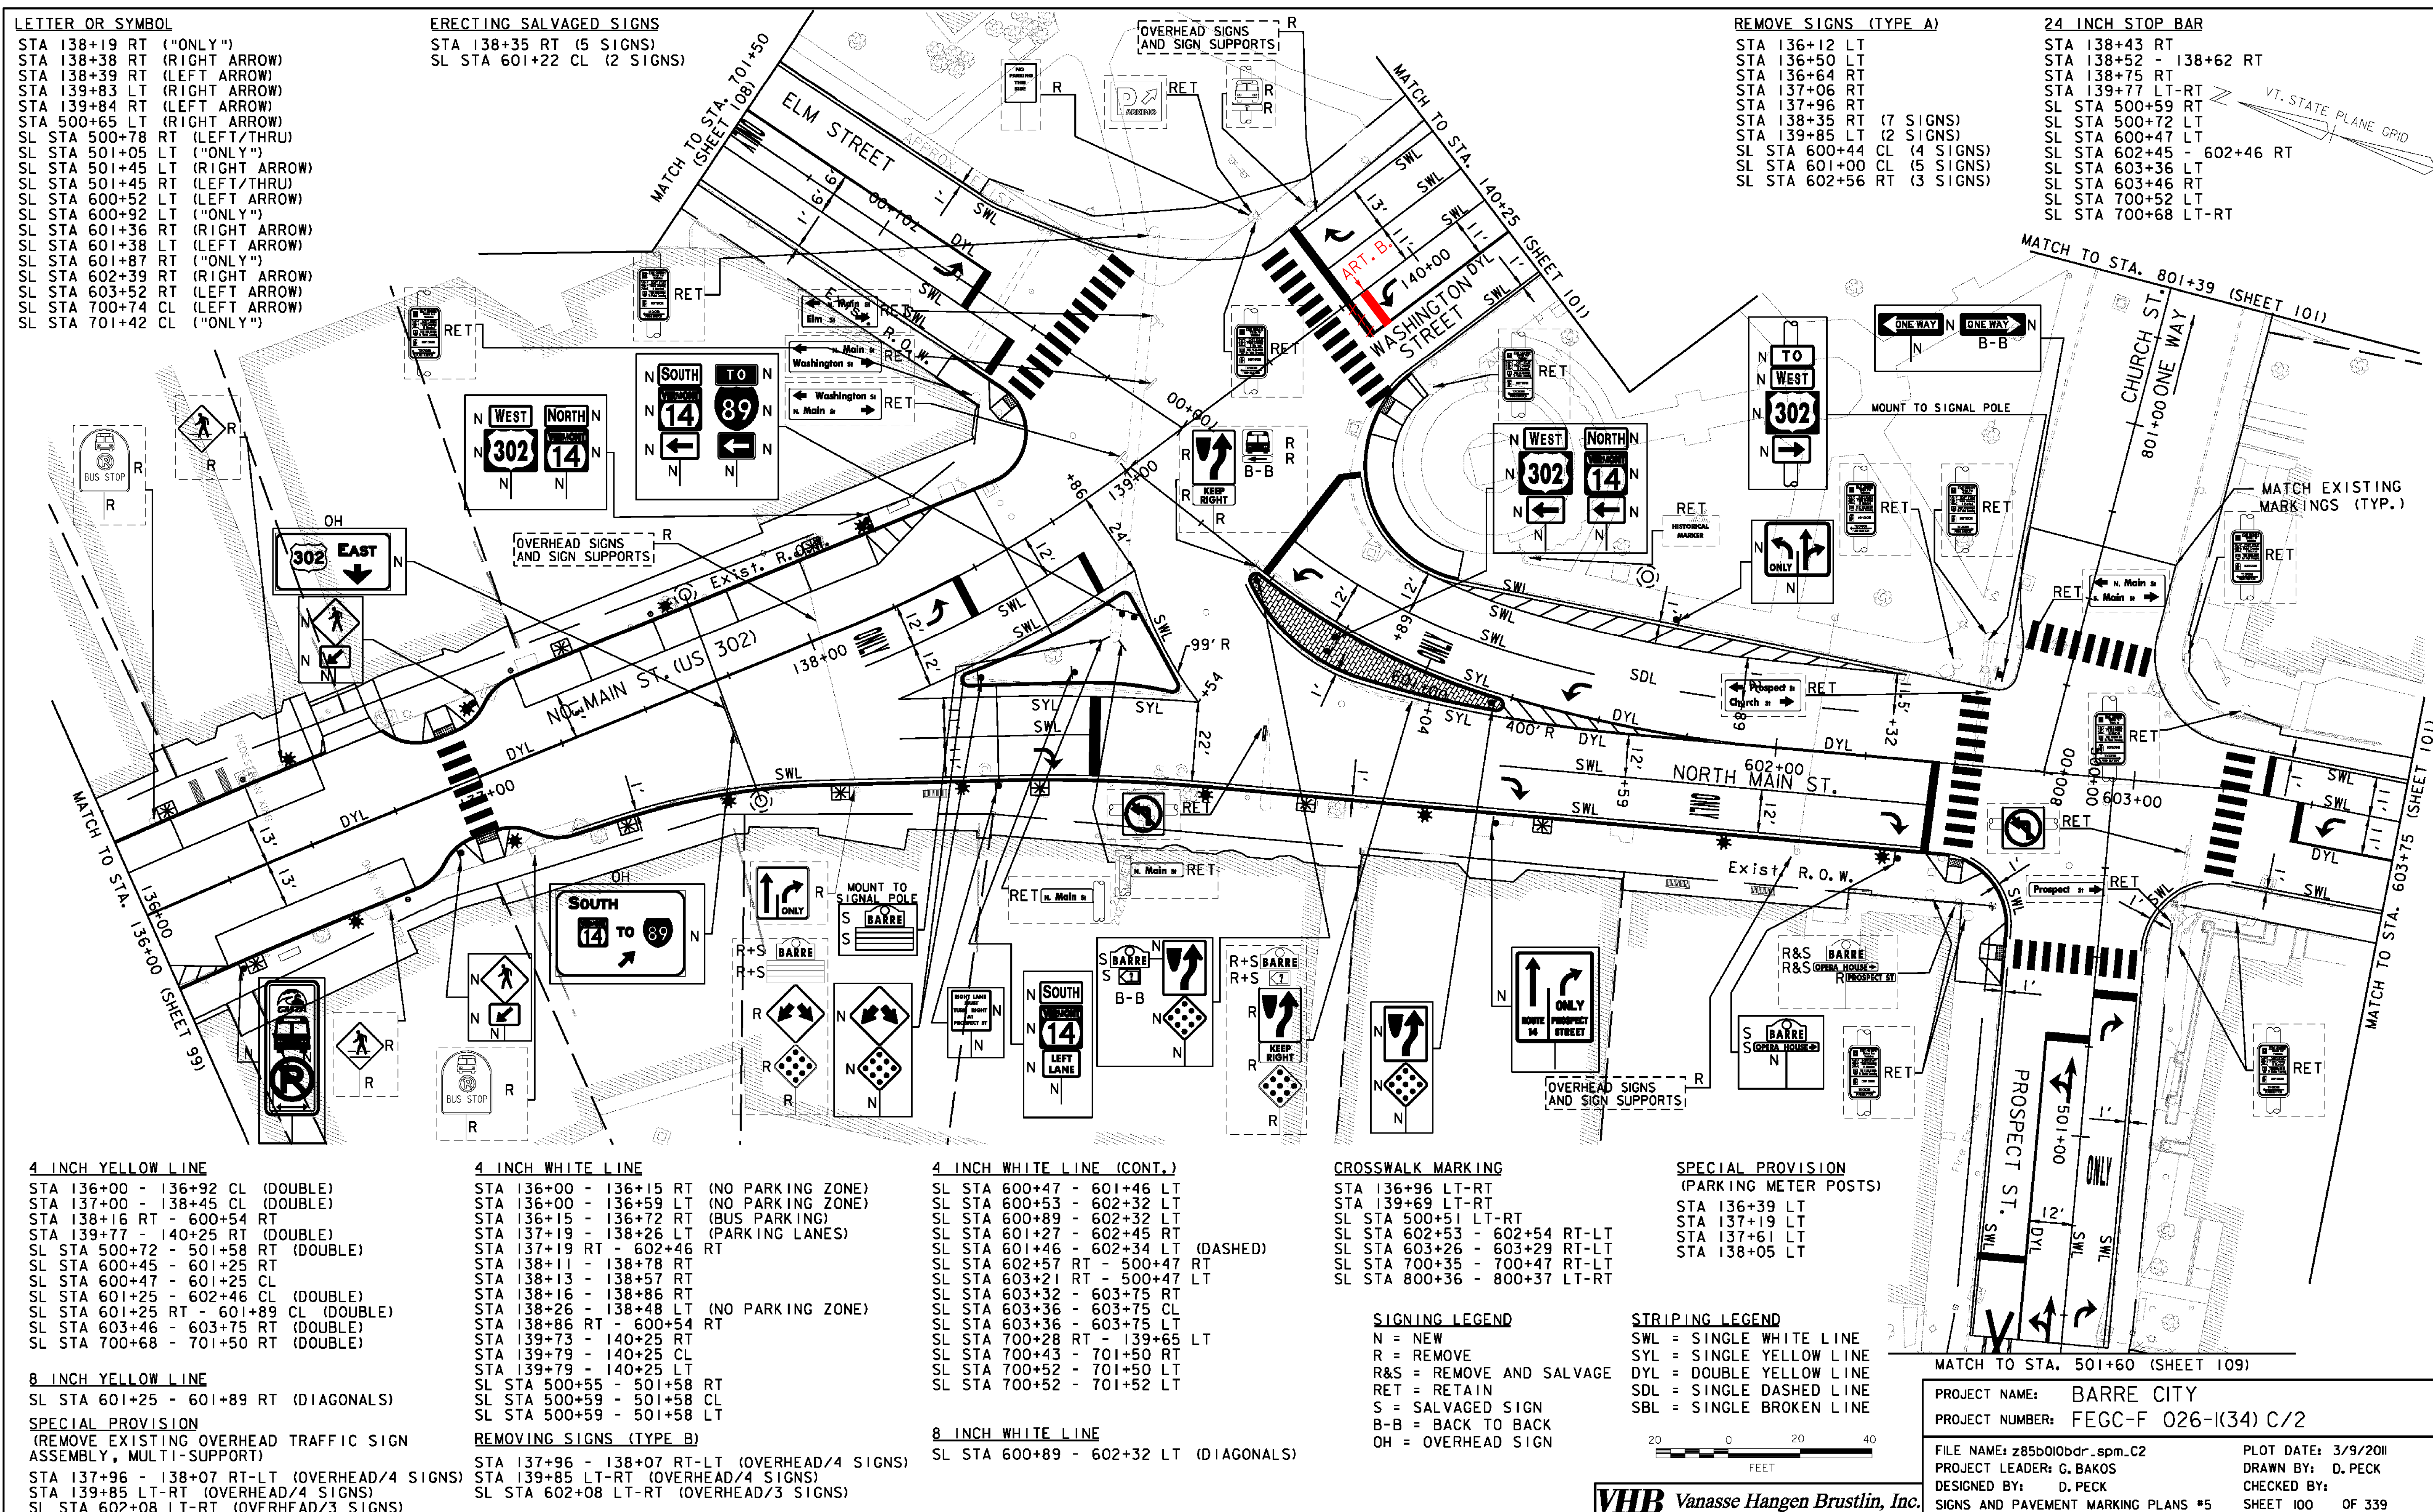

4 INCH YELLOW LINE

STA 136+00 - 136+92 CL (DOUBLE)
 STA 137+00 - 138+45 CL (DOUBLE)
 STA 138+16 RT - 600+54 RT
 STA 139+77 - 140+25 RT (DOUBLE)
 SL STA 500+72 - 501+58 RT (DOUBLE)
 SL STA 600+45 - 601+25 RT
 SL STA 600+47 - 601+25 CL
 SL STA 601+25 - 602+46 CL (DOUBLE)
 SL STA 601+25 RT - 601+89 CL (DOUBLE)
 SL STA 603+46 - 603+75 RT (DOUBLE)
 SL STA 700+68 - 701+50 RT (DOUBLE)

8 INCH YELLOW LINE

SL STA 601+25 - 601+89 RT (DIAGONALS)

SPECIAL PROVISION

(REMOVE EXISTING OVERHEAD TRAFFIC SIGN ASSEMBLY, MULTI-SUPPORT)

STA 137+96 - 138+07 RT-LT (OVERHEAD/4 SIGNS)
 STA 139+85 LT-RT (OVERHEAD/4 SIGNS)
 SL STA 602+08 LT-RT (OVERHEAD/3 SIGNS)

4 INCH WHITE LINE

STA 136+00 - 136+15 RT (NO PARKING ZONE)
 STA 136+00 - 136+59 LT (NO PARKING ZONE)
 STA 136+15 - 136+72 RT (BUS PARKING)
 STA 137+19 - 138+26 LT (PARKING LANES)
 STA 137+19 RT - 602+46 RT
 STA 138+11 - 138+78 RT
 STA 138+13 - 138+57 RT
 STA 138+16 - 138+86 RT
 STA 138+26 - 138+48 LT (NO PARKING ZONE)
 STA 138+86 RT - 600+54 RT
 STA 139+73 - 140+25 RT
 STA 139+79 - 140+25 CL
 STA 139+79 - 140+25 LT
 SL STA 500+55 - 501+58 RT
 SL STA 500+59 - 501+58 CL
 SL STA 500+59 - 501+58 LT

REMOVING SIGNS (TYPE B)

STA 137+96 - 138+07 RT-LT (OVERHEAD/4 SIGNS)
 STA 139+85 LT-RT (OVERHEAD/4 SIGNS)
 SL STA 602+08 LT-RT (OVERHEAD/3 SIGNS)

4 INCH WHITE LINE (CONT.)

SL STA 600+47 - 601+46 LT
 SL STA 600+53 - 602+32 LT
 SL STA 600+89 - 602+32 LT
 SL STA 601+27 - 602+45 RT
 SL STA 601+46 - 602+34 LT (DASHED)
 SL STA 602+57 RT - 500+47 RT
 SL STA 603+21 RT - 500+47 LT
 SL STA 603+32 - 603+75 RT
 SL STA 603+36 - 603+75 CL
 SL STA 603+36 - 603+75 LT
 SL STA 700+28 RT - 139+65 LT
 SL STA 700+43 - 701+50 RT
 SL STA 700+52 - 701+50 LT
 SL STA 700+52 - 701+52 LT

8 INCH WHITE LINE

SL STA 600+89 - 602+32 LT (DIAGONALS)

CROSSWALK MARKING

STA 136+96 LT-RT
 STA 139+69 LT-RT
 SL STA 500+51 LT-RT
 SL STA 602+53 - 602+54 RT-LT
 SL STA 603+26 - 603+29 RT-LT
 SL STA 700+35 - 700+47 RT-LT
 SL STA 800+36 - 800+37 LT-RT

SIGNING LEGEND

N = NEW
 R = REMOVE
 R&S = REMOVE AND SALVAGE
 RET = RETAIN
 S = SALVAGED SIGN
 B-B = BACK TO BACK
 OH = OVERHEAD SIGN

STRIPING LEGEND

SWL = SINGLE WHITE LINE
 SYL = SINGLE YELLOW LINE
 DYL = DOUBLE YELLOW LINE
 SDL = SINGLE DASHED LINE
 SBL = SINGLE BROKEN LINE

SPECIAL PROVISION

(PARKING METER POSTS)
 STA 136+39 LT
 STA 137+19 LT
 STA 137+61 LT
 STA 138+05 LT

20 0 20 40
 FEET

VHB Vanasse Hangen Brustlin, Inc.

PROJECT NAME: BARRE CITY
 PROJECT NUMBER: FECC-F 026-1(34) C/2

FILE NAME: z85b010bdr_spm.C2
 PROJECT LEADER: G. BAKOS
 DESIGNED BY: D. PECK
 SIGNS AND PAVEMENT MARKING PLANS #5

PLOT DATE: 3/9/2011
 DRAWN BY: D. PECK
 CHECKED BY:
 SHEET 100 OF 339