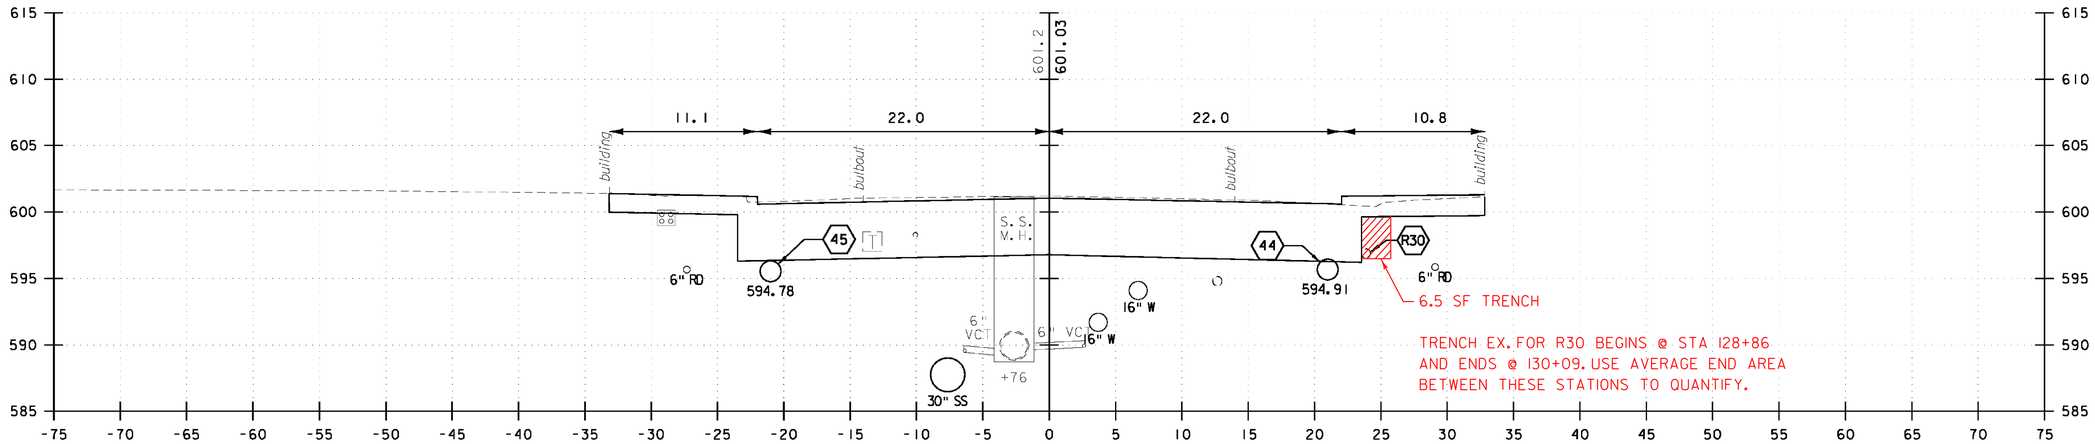

129+00

SAND BORROW ~ 1.50' X 47.0'= 70.5 SF
SUBBASE ~ 2.00' X 47.0'= 94.0 SF

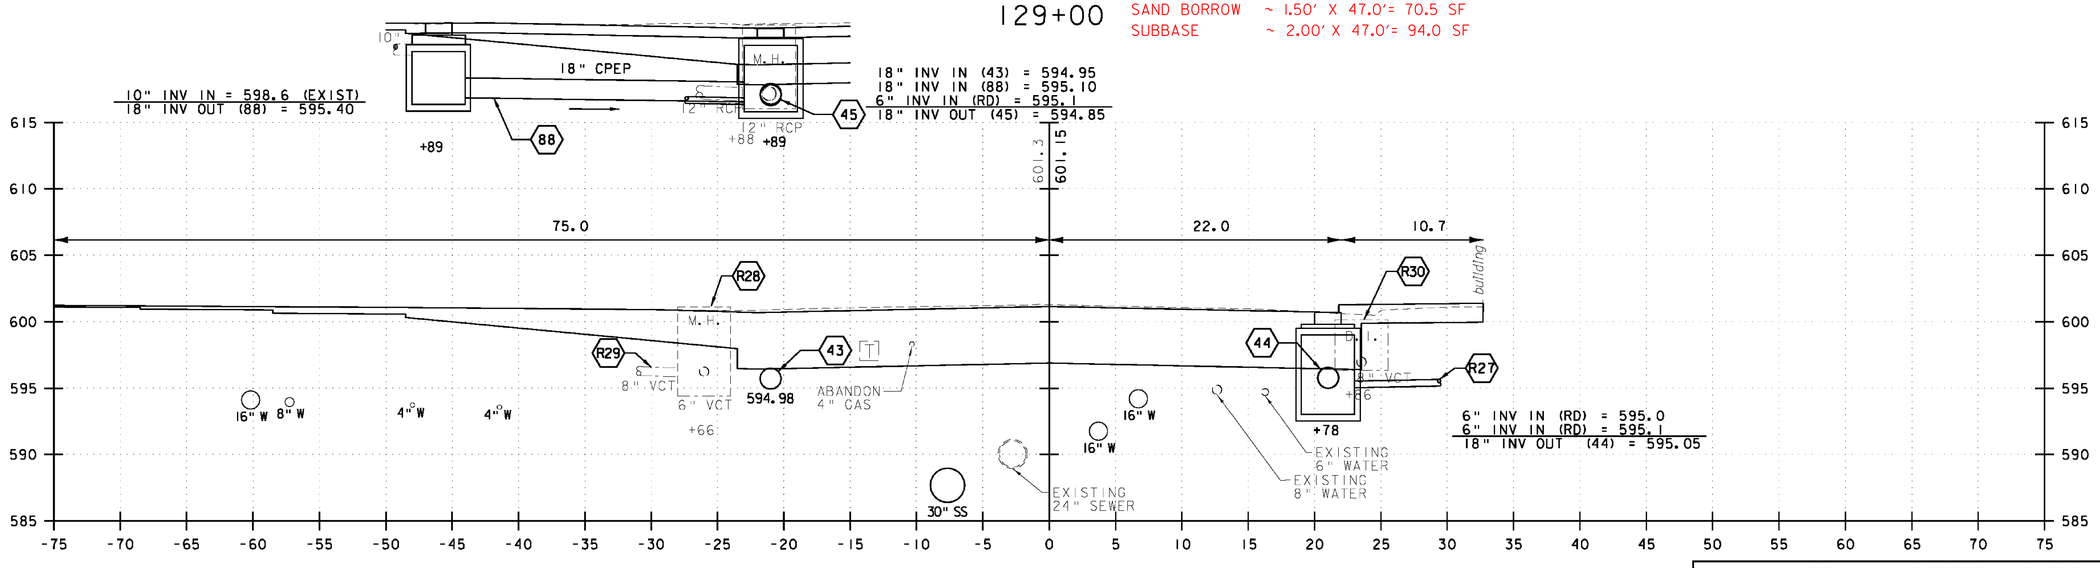

128+79

5 0 5 10
FEET

VHB Vanasse Hangen Brustlin, Inc.

NORTH MAIN STREET (US 302)

PROJECT NAME: BARRE CITY
PROJECT NUMBER: FEGC F 026-1(34) C/2

FILE NAME: 85b010_xsl_Cut_C2
PROJECT LEADER: G. BAKOS
DESIGNED BY: DMP / MDS
CROSS SECTIONS

PLOT DATE: 3/9/2011
DRAWN BY: DMP / JAR
CHECKED BY:
SHEET 260 OF 339