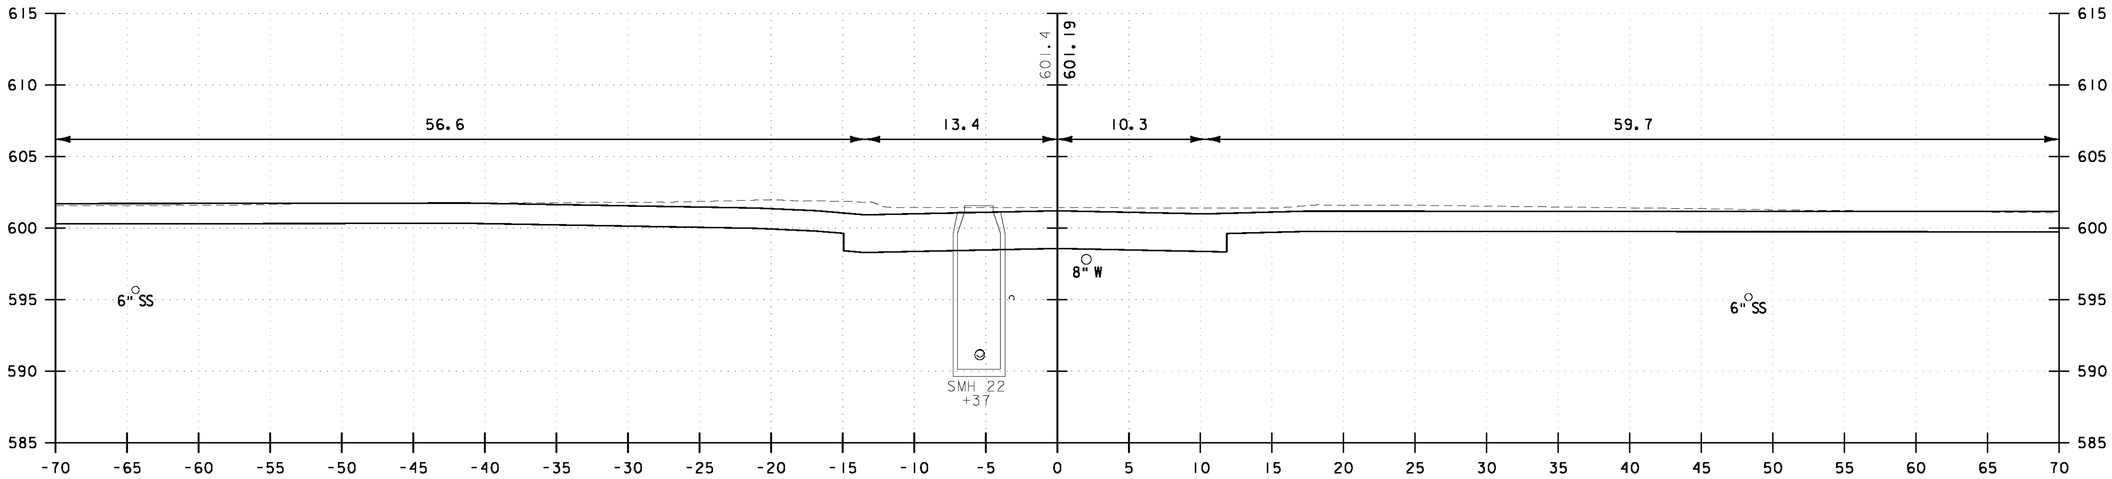

300+25

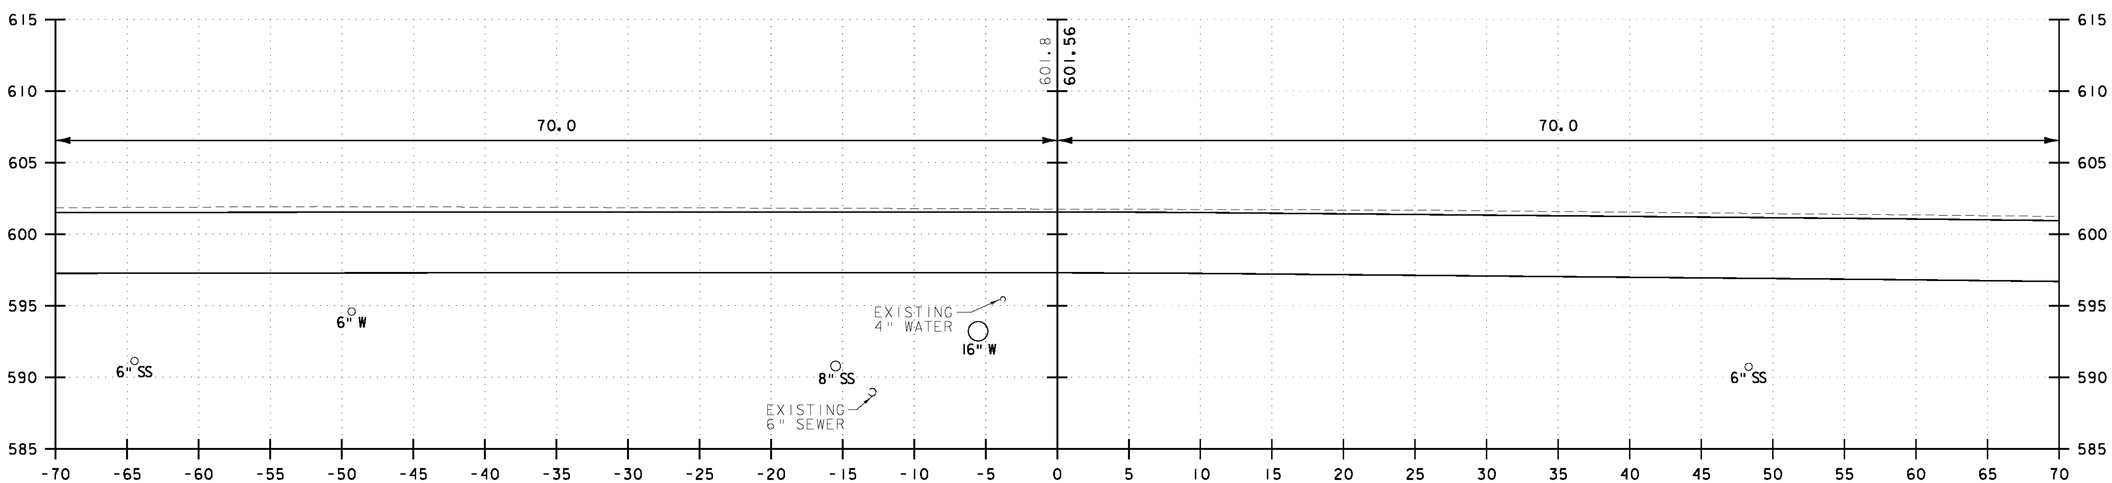

300+00

5 0 5 10
FEET

VHB Vanasse Hangen Brustlin, Inc.

CREAMERY COURT

PROJECT NAME: BARRE CITY
PROJECT NUMBER: FEGC F 026-1(34) C/2

FILE NAME: 85b010_xs2_Cut_C2
PROJECT LEADER: G. BAKOS
DESIGNED BY: DMP / MDS
CROSS SECTIONS

PLOT DATE: 3/9/2011
DRAWN BY: DMP / JAR
CHECKED BY:
SHEET 299 OF 339