

**LETTER OR SYMBOL**

STA 138+19 RT ("ONLY")  
 STA 138+38 RT (RIGHT ARROW)  
 STA 138+39 RT (LEFT ARROW)  
 STA 139+83 LT (RIGHT ARROW)  
 STA 139+84 RT (LEFT ARROW)  
 STA 500+65 LT (RIGHT ARROW)  
 SL STA 500+78 RT (LEFT/THRU)  
 SL STA 501+05 LT ("ONLY")  
 SL STA 501+45 LT (RIGHT ARROW)  
 SL STA 501+45 RT (LEFT/THRU)  
 SL STA 600+52 LT (LEFT ARROW)  
 SL STA 600+92 LT ("ONLY")  
 SL STA 601+36 RT (RIGHT ARROW)  
 SL STA 601+38 LT (LEFT ARROW)  
 SL STA 601+87 RT ("ONLY")  
 SL STA 602+39 RT (RIGHT ARROW)  
 SL STA 603+52 RT (LEFT ARROW)  
 SL STA 700+74 CL (LEFT ARROW)  
 SL STA 701+42 CL ("ONLY")

**ERECTING SALVAGED SIGNS**


STA 138+35 RT (5 SIGNS)  
 SL STA 601+22 CL (2 SIGNS)

**REMOVE SIGNS (TYPE A)**

STA 136+12 LT  
 STA 136+50 LT  
 STA 136+64 RT  
 STA 137+06 RT  
 STA 137+96 RT  
 STA 138+35 RT (7 SIGNS)  
 STA 139+85 LT (2 SIGNS)  
 SL STA 601+00 CL (5 SIGNS)  
 SL STA 602+56 RT (3 SIGNS)

**24 INCH STOP BAR**

STA 138+43 RT  
 STA 138+52 - 138+62 RT  
 STA 138+75 RT  
 STA 139+77 LT-RT  
 SL STA 500+59 RT  
 SL STA 600+47 LT  
 SL STA 602+45 - 602+46 RT  
 SL STA 603+36 LT  
 SL STA 603+46 RT  
 SL STA 700+52 LT  
 SL STA 700+68 LT-RT

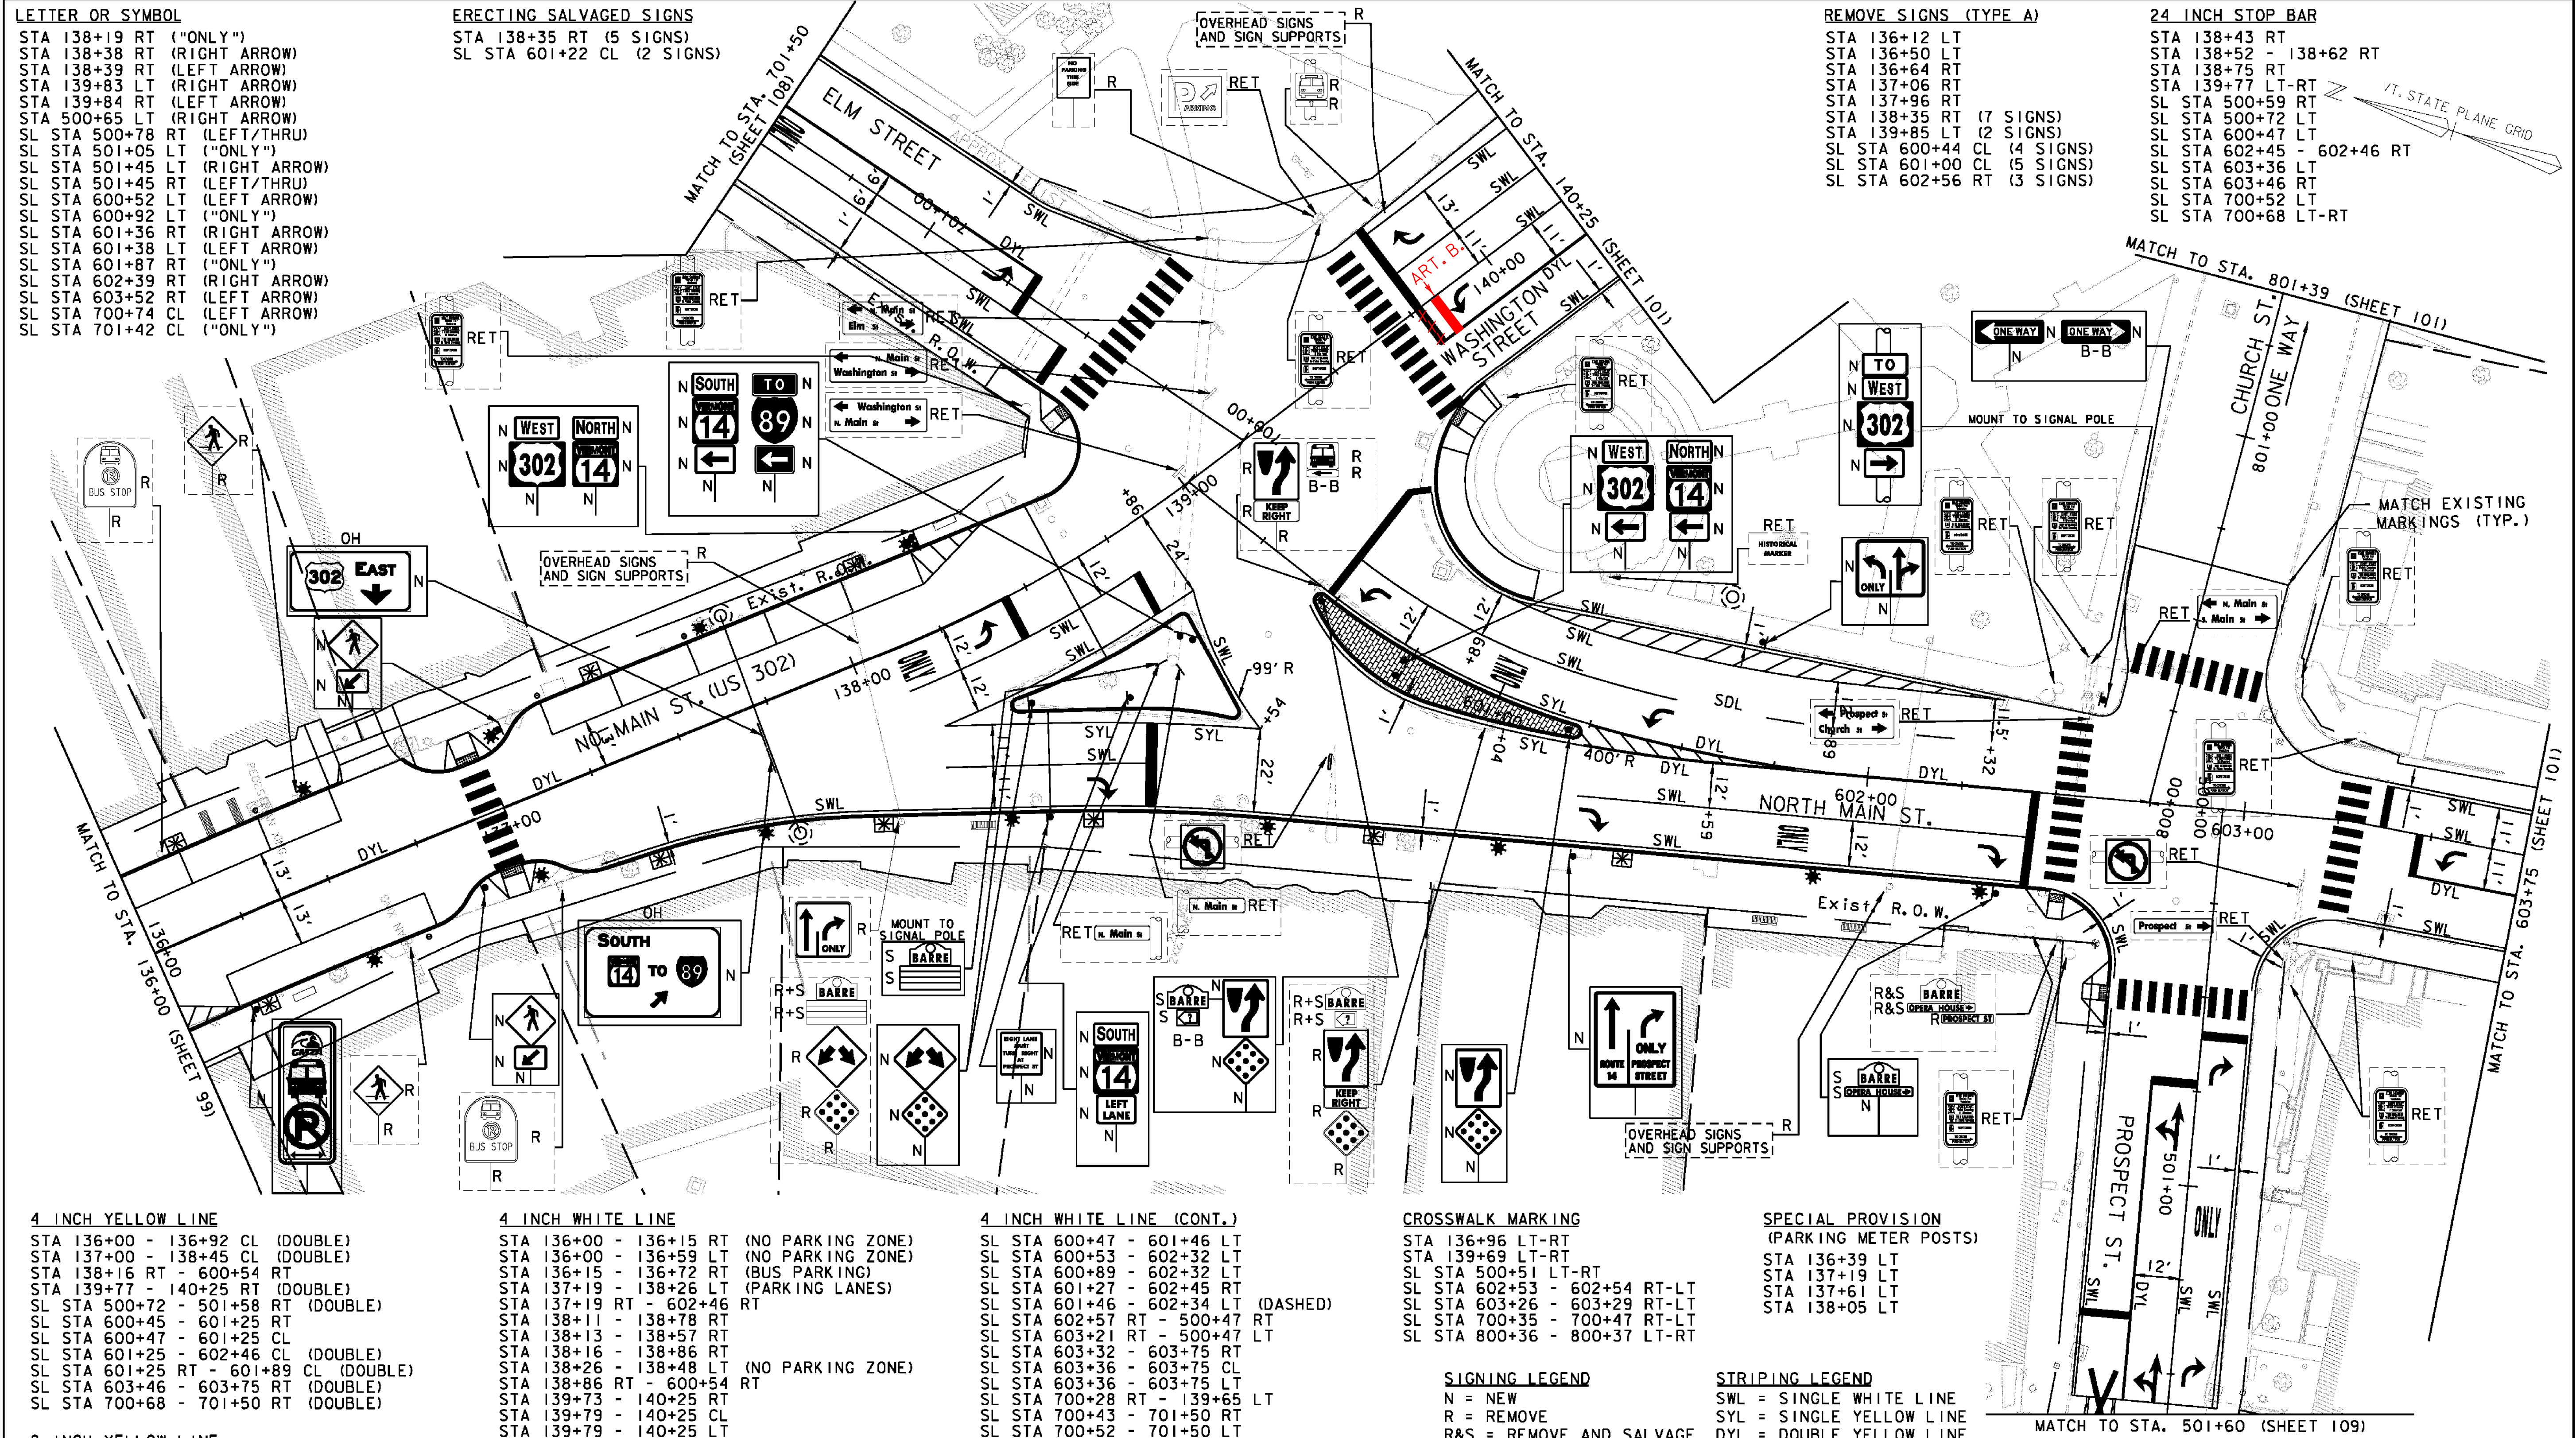

**4 INCH YELLOW LINE**  
 STA 136+00 - 136+92 CL (DOUBLE)  
 STA 137+00 - 138+45 CL (DOUBLE)  
 STA 138+16 RT - 600+54 RT  
 STA 139+77 - 140+25 RT (DOUBLE)  
 SL STA 500+72 - 501+58 RT (DOUBLE)  
 SL STA 600+45 - 601+25 RT  
 SL STA 600+47 - 601+25 CL  
 SL STA 601+25 - 602+46 CL (DOUBLE)  
 SL STA 601+25 RT - 601+89 CL (DOUBLE)  
 SL STA 603+46 - 603+75 RT (DOUBLE)  
 SL STA 700+68 - 701+50 RT (DOUBLE)

**8 INCH YELLOW LINE**  
 SL STA 601+25 - 601+89 RT (DIAGONALS)

**SPECIAL PROVISION**  
 (REMOVE EXISTING OVERHEAD TRAFFIC SIGN ASSEMBLY, MULTI-SUPPORT)  
 STA 137+96 - 138+07 RT-LT (OVERHEAD/4 SIGNS)  
 STA 139+85 LT-RT (OVERHEAD/4 SIGNS)  
 SL STA 602+08 LT-RT (OVERHEAD/3 SIGNS)

**4 INCH WHITE LINE**  
 STA 136+00 - 136+15 RT (NO PARKING ZONE)  
 STA 136+00 - 136+59 LT (NO PARKING ZONE)  
 STA 136+15 - 136+72 RT (BUS PARKING)  
 STA 137+19 - 138+26 LT (PARKING LANES)  
 STA 137+19 RT - 602+46 RT  
 STA 138+11 - 138+78 RT  
 STA 138+13 - 138+57 RT  
 STA 138+16 - 138+86 RT  
 STA 138+26 - 138+48 LT (NO PARKING ZONE)  
 STA 138+86 RT - 600+54 RT  
 STA 139+73 - 140+25 RT  
 STA 139+79 - 140+25 CL  
 STA 139+79 - 140+25 LT  
 SL STA 500+55 - 501+58 RT  
 SL STA 500+59 - 501+58 CL  
 SL STA 500+59 - 501+58 LT

**REMOVING SIGNS (TYPE B)**  
 STA 137+96 - 138+07 RT-LT (OVERHEAD/4 SIGNS)  
 STA 139+85 LT-RT (OVERHEAD/4 SIGNS)  
 SL STA 602+08 LT-RT (OVERHEAD/3 SIGNS)

**4 INCH WHITE LINE (CONT.)**  
 SL STA 600+47 - 601+46 LT  
 SL STA 600+53 - 602+32 LT  
 SL STA 600+89 - 602+32 LT  
 SL STA 601+27 - 602+45 RT  
 SL STA 601+46 - 602+34 LT (DASHED)  
 SL STA 602+57 RT - 500+47 RT  
 SL STA 603+21 RT - 500+47 LT  
 SL STA 603+32 - 603+75 RT  
 SL STA 603+36 - 603+75 CL  
 SL STA 603+36 - 603+75 LT  
 SL STA 700+28 RT - 139+65 LT  
 SL STA 700+43 - 701+50 RT  
 SL STA 700+52 - 701+50 LT  
 SL STA 700+52 - 701+52 LT


**8 INCH WHITE LINE**  
 SL STA 600+89 - 602+32 LT (DIAGONALS)

**CROSSWALK MARKING**  
 STA 136+96 LT-RT  
 STA 139+69 LT-RT  
 SL STA 500+51 LT-RT  
 SL STA 602+53 - 602+54 RT-LT  
 SL STA 603+26 - 603+29 RT-LT  
 SL STA 700+35 - 700+47 RT-LT  
 SL STA 800+36 - 800+37 RT-LT

**SIGNING LEGEND**  
 N = NEW  
 R = REMOVE  
 R&S = REMOVE AND SALVAGE  
 RET = RETAIN  
 S = SALVAGED SIGN  
 B-B = BACK TO BACK  
 OH = OVERHEAD SIGN

**SPECIAL PROVISION (PARKING METER POSTS)**  
 STA 136+39 LT  
 STA 137+19 LT  
 STA 137+61 LT  
 STA 138+05 LT

**STRIPING LEGEND**  
 SWL = SINGLE WHITE LINE  
 SYL = SINGLE YELLOW LINE  
 DYL = DOUBLE YELLOW LINE  
 SDL = SINGLE DASHED LINE  
 SBL = SINGLE BROKEN LINE

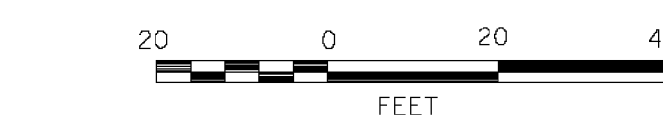

MATCH TO STA. 501+60 (SHEET 109)

PROJECT NAME: BARRE CITY  
 PROJECT NUMBER: FEGC-F 026-1(34) C/2

FILE NAME: z85b010bdr\_spm.C2  
 PROJECT LEADER: G. BAKOS  
 DESIGNED BY: D. PECK  
 SIGNS AND PAVEMENT MARKING PLANS #5

PLOT DATE: 3/9/2011  
 DRAWN BY: D. PECK  
 CHECKED BY:  
 SHEET 100 OF 339

