STATE OF VERMONT
AGENCY OF TRANSPORTATION

TRAFFIC SIGN SUMMARY SHEET

MILE MARKER, STATION, OR SIGN NUMBER	SIGN LEGEND	SIGN DIMENSIONS EA	WIDTH (IN)	HEIGHT (IN)	NEW & SALVAGED SIGNS "A"	"B"	SALV SIGN	SALV TIS	EXIST POST RETAIN	SALVAGE	NEW SIGN POSTS NO. OF POSTS	FLANGED CHANNEL LB/FT 1.12	2.0	3.0	SQUARE STEEL (IN) LB/FT 1.75 1.88	2.0 2.42	2.5 3.35	ANCHOR	SLEEVE	TUBULAR ALUMINUM Ø (IN) LB/FT 3.0 1.3	4.0 1.7	4.0 MOD 1.7	TUBULAR STEEL Ø (IN) FOUND-ATION	LB/FT 3.0 7.6	3.5 9.0	4.0 10.8	5.0 14.6	W-SHAPE STEEL FTG. SIZE 24"	30"	WEIGHT	POST SIZE	SIGN FRAME REQUIRED	REMARKS	SIGN DETAIL DETAIL ON SHEET NUMBER	STD. SHEET NUMBER
											OPTION ITEMS																								
NO. MAIN STREET																																				
115+40 ~~114+85~~, LT		1	24	12	2.00																											#2A	MOUNT SIGNS ON ONE #2A SIGN FRAME ABOVE #2 FRAME SEE VAOT STD E-123	SHS M4-5 WOB		
		1	24	24	4.00																													SHS M1-1		
		1	21	15	2.19																													SHS M6-1 WOB		
115+40 ~~114+85~~, LT		1	24	12	2.00																											-	MOUNT SIGNS ON ONE #2A SIGN FRAME ABOVE #2 FRAME SEE VAOT STD E-123	SHS M3-4 BOW		E-136B
		1	30	24	4.00																													SHS M1-5 (VT)		
		1	21	15	2.19																													SHS M6-3 BOW		
115+18, RT		1	24	12	2.00						1						X 14.5'		X													#1A	MOUNT SIGNS ON ONE #1A SIGN FRAME. SEE VAOT STD. E-123	SHS M3-2 BOW		
		1	30	24	5.00																													SHS M1-4		
115+18, RT		1	24	12	2.00												14.0'		X													-	MOUNT SIGNS ON ONE #1A SIGN FRAME. SEE VAOT STD. E-123	SHS M3-3 GOW		E-136B
		1	24	24	4.00																													M1-5 (VT)		
116+29, LT		1	48	30	10.00						2						X 23.0'		X															VR-932		E-145B
115+96, RT		1	36	36	9.00						2						X 14.25' 14.25'		X X															SHS W4-2		
VT ROUTE 62																																				
10+63, CL	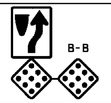	1	24	30	5.00						1						X 12.5'		X														MOUNT OM1-1 SIGNS BACK-TO-BACK	SHS R4-7		
		2	18	18	4.50																													SHS OM1-1		
10+75, LT		1	36	36	9.00						1						X 14.0'		X															SHS R5-1		
10+89, CL		1	36	36	7.07						1						X 10.0'		~~X~~														NO NEW SLEEVE (USED EXISITING)	SHS W10-1		
											FT	FT	FT	FT	FT ~~90~~ 75.5	FT ~~30~~ 41.0		EA 4		LB	LB	LB		LB	LB	LB	LB								
					SUB TOTALS	SF 73.95	SF	EA.	SF		FT				FT ~~120~~ 115.5					LB			EA.	LB				EA.	EA.	LB					

FINAL POST LENGTHS ARE TO BE DETERMINED IN THE FIELD. POST SIZES ARE COMPUTED BASED ON INFORMATION FURNISHED ON THE STANDARD SHEETS AND THE VTRANS "SIGN POST DESIGN GUIDELINE."

AVERAGE POST LENGTH = 15 FT

BOW = BLACK LEGEND ON WHITE BACKGROUND - PLAQUE
GOW = GREEN LEGEND ON WHITE BACKGROUND - PLAQUE
WOB = WHITE LEGEND ON BLUE BACKGROUND - PLAQUE
FYG = BLACK LEGEND ON FLUORESCENT YELLOW-GREEN BACKGROUND
SHS = FHWA STANDARD HIGHWAY SIGNS BOOK

VHB Vanasse Hangen Brustlin, Inc.

PROJECT NAME: BARRE CITY
PROJECT NUMBER: FEGC F 026-1(34) C/2

FILE NAME: 85b010_TSSS_C2 | PLOT DATE: 3/31/2011
PROJECT LEADER: G. BAKOS | DRAWN BY: CMD
DESIGNED BY: MDS | CHECKED BY:
TRAFFIC SIGN SUMMARY SHEET | SHEET 112 OF 339