STATE OF VERMONT
AGENCY OF TRANSPORTATION

TRAFFIC SIGN SUMMARY SHEET

MILE MARKER, STATION, OR SIGN NUMBER	SIGN LEGEND	SIGN DIMENSIONS EA	WIDTH (IN)	HEIGHT (IN)	NEW & SALVAGED SIGNS "A"	"B"	SALV SIGN	SALV TIS	EXIST POST RETAIN	SALVAGE	NEW SIGN POSTS NO. OF POSTS	FLANGED CHANNEL LB/FT 1.12	2.0	3.0	SQUARE STEEL (IN) LB/FT 1.75 1.88	2.0 2.42	2.5 3.35	ANCHOR	SLEEVE	TUBULAR ALUMINUM Ø (IN) LB/FT 3.0 1.3	4.0 1.7	4.0 MOD 1.7	TUBULAR STEEL Ø (IN) LB/FT FOUND-ATION	3.0 7.6	3.5 9.0	4.0 10.8	5.0 14.6	W-SHAPE STEEL FTG. SIZE 24"	30"	WEIGHT	POST SIZE	SIGN FRAME REQUIRED	REMARKS	SIGN DETAIL DETAIL ON SHEET NUMBER	STD. SHEET NUMBER
											OPTION ITEMS																								
MERCHANT STREET																																			
128+48, RT		1	12	30	2.50						1					X 13.5'			X														SHS R7-107a	110	
128+92, RT		1 1	24 24	24 12	4.00 2.00						1					X 14.5'			X														FYG FYG	SHS W11-2 SHS W16-7pL		
128+95 LT	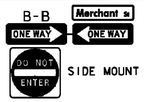 SIDE MOUNT	1 1 1 1	42 36 36 36	12 12 12 36	3.50 3.00 3.00 9.00						1						X 15.25'		X														SET R6-1R & R6-1L BACK TO BACK SET R5-1 FACING N. MAIN ST	SHS D3-1 SHS R6-1L SHS R6-1R SHS R5-1		
129+12, LT		1 1	24 24	24 12	4.00 2.00						1					X 14.5'			X														FYG FYG	SHS W11-2 SHS W16-7pL		
MERCHANT STREET																																			
70+37, LT		1	36	36	9.00						1						X 13.75'		X														SHS R1-1		
CREAMERY COURT																																			
300+35, LT		1	36	36	9.00						1						X 13.75'		X														SHS R1-1		
GRANITE STREET																																			
50+35, LT		1 1	36 36	12 36	3.00 9.00						1						X 13.75'		X														SHS D3-1 SHS R1-1		
												FT	FT	FT	FT	FT	FT		EA	LB	LB	LB		LB	LB	LB	LB								
																45 42.5	60 56.5		7																	
		SUB TOTALS			SF 63.00	SF	EA.	SF				FT				FT ~~105~~ 99.0				LB			EA.	LB				EA.	EA.	LB					

FINAL POST LENGTHS ARE TO BE DETERMINED IN THE FIELD. POST SIZES ARE COMPUTED BASED ON INFORMATION FURNISHED ON THE STANDARD SHEETS AND THE VTRANS "SIGN POST DESIGN GUIDELINE."

AVERAGE POST LENGTH = 15 FT

BOW = BLACK LEGEND ON WHITE BACKGROUND - PLAQUE
GOW = GREEN LEGEND ON WHITE BACKGROUND - PLAQUE
WOB = WHITE LEGEND ON BLUE BACKGROUND - PLAQUE
FYG = BLACK LEGEND ON FLUORESCENT YELLOW-GREEN BACKGROUND
SHS = FHWA STANDARD HIGHWAY SIGNS BOOK

VHB Vanasse Hangen Brustlin, Inc.

PROJECT NAME: BARRE CITY
PROJECT NUMBER: FEGC F 026-1(34) C/2

FILE NAME: 85b010_TSSS_C2
PROJECT LEADER: G. BAKOS
DESIGNED BY: MDS
TRAFFIC SIGN SUMMARY SHEET

PLOT DATE: 3/31/2011
DRAWN BY: CMD
CHECKED BY:
SHEET 118 OF 339