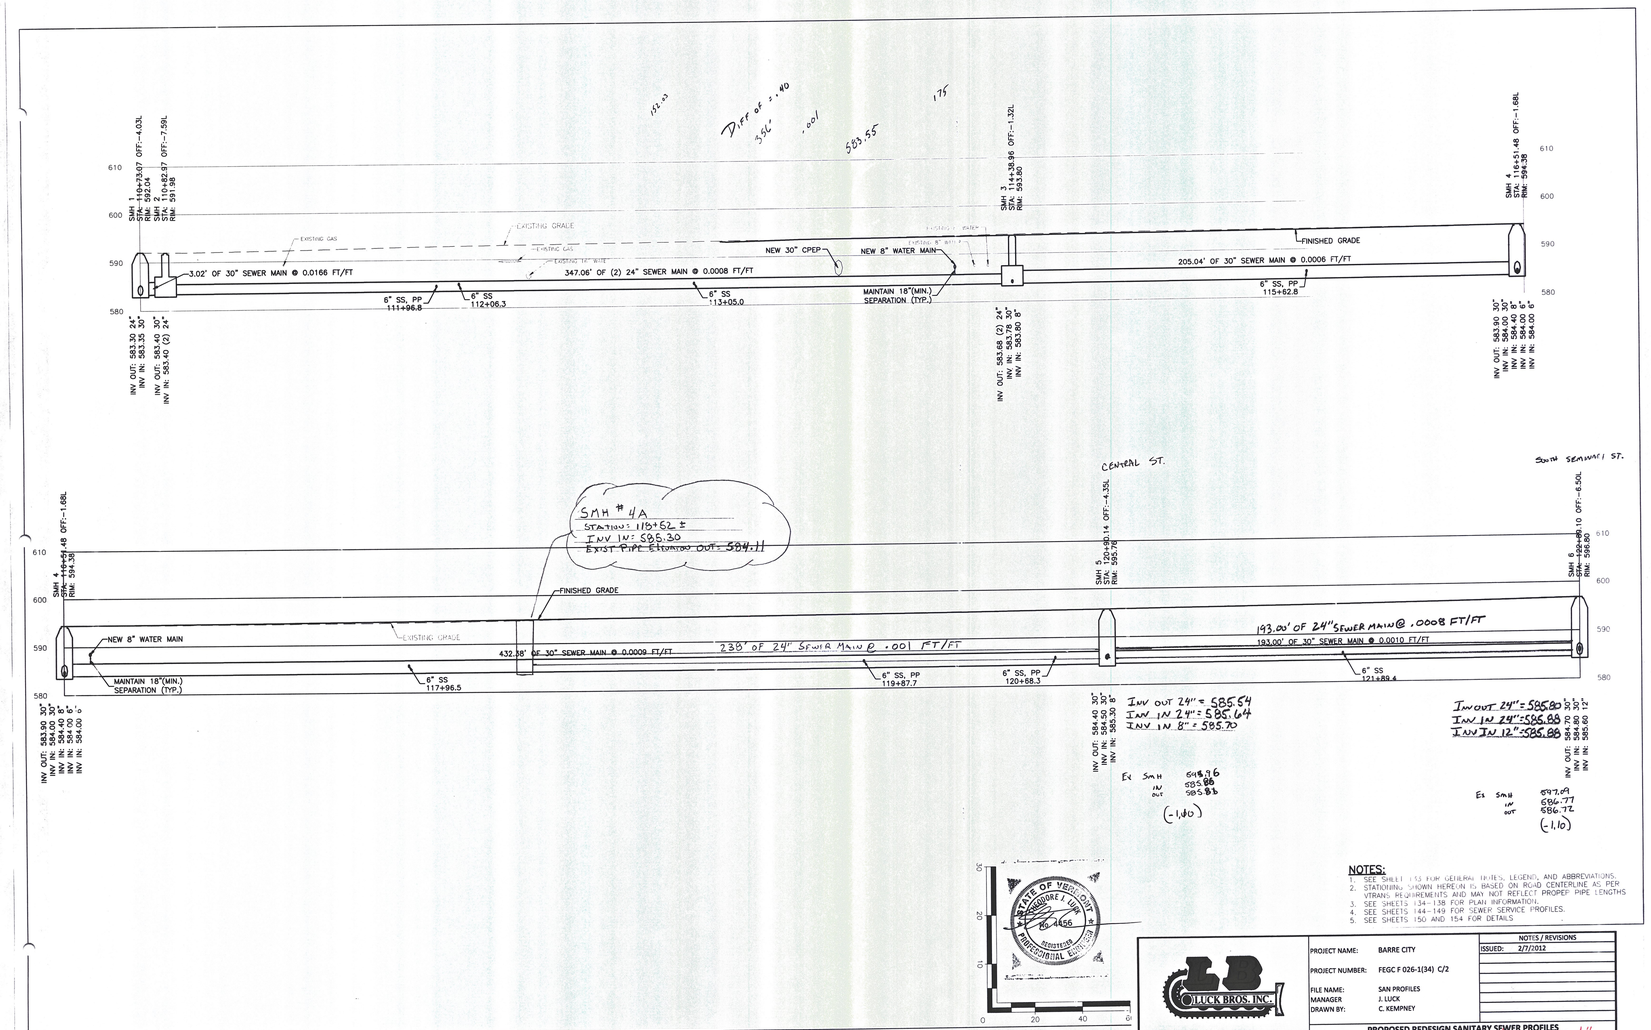

NOTES:

1. SEE SHEET 1.53 FOR GENERAL NOTES, LEGEND, AND ABBREVIATIONS.
2. STATIONING SHOWN HEREIN IS BASED ON ROAD CENTERLINE AS PER VTRANS REQUIREMENTS AND MAY NOT REFLECT PROPER PIPE LENGTHS
3. SEE SHEETS 134–138 FOR PLAN INFORMATION.
4. SEE SHEETS 144–149 FOR SEWER SERVICE PROFILES.
5. SEE SHEETS 150 AND 154 FOR DETAILS

PROJECT NAME:	BARRE CITY	NOTES / REVISIONS
PROJECT NUMBER:	FEGC F 026-1(34) C/2	ISSUED: 2/7/2012
FILE NAME:	SAN PROFILES	
MANAGER	J. LUCK	
DRAWN BY:	C. KEMPNEY	

LUCK BROS. INC.

PROPOSED REDESIGN SANITARY SEWER PROFILES

Sheet "139 revised"