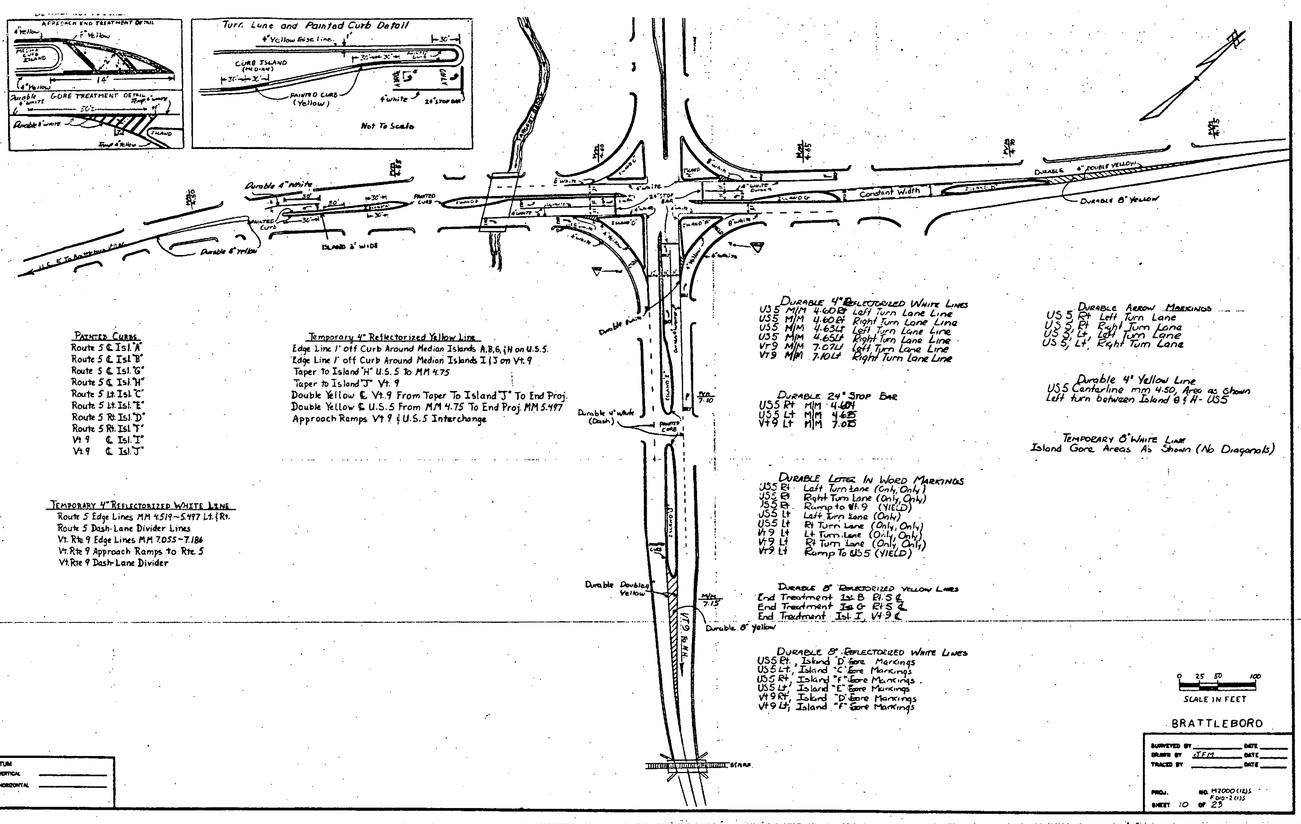


**Painted Curbs**
Route 5 ℄ Isl. 'A'
Route 5 ℄ Isl. 'B'
Route 5 ℄ Isl. 'G'
Route 5 ℄ Isl. 'H'
Route 5 Lt Isl. 'C'
Route 5 Lt Isl. 'E'
Route 5 Rt Isl. 'D'
Route 5 Rt. Isl. 'F'
Vt 9 ℄ Isl. 'I'
Vt 9 ℄ Isl. 'J'

**Temporary 4" Reflectorized Yellow Line**
Edge Line 1' off Curb Around Median Islands A,B,G,H on U.S.5.
Edge Line 1' off Curb Around Median Islands I & J on Vt. 9
Taper To Island 'H' U.S.5 To MM 4.75
Taper to Island 'J' Vt. 9
Double Yellow ℄ Vt. 9 From Taper To Island 'J' To End Proj.
Double Yellow ℄ U.S.5 From MM 4.75 To End Proj. MM 5.497
Approach Ramps Vt 9 & U.S.5 Interchange

**Temporary 4" Reflectorized White Line**
Route 5 Edge Lines MM 4.519–5.497 Lt & Rt.
Route 5 Dash Lane Divider Lines
Vt. Rte 9 Edge Lines MM 7.055–7.186
Vt. Rte 9 Approach Ramps to Rte. 5
Vt. Rte 9 Dash Lane Divider

**Durable 4" Reflectorized White Lines**

| | | | |
|---|---|---|---|
| US5 | MM | 4.60 Rt | Left Turn Lane Line |
| US5 | MM | 4.60 Rt | Right Turn Lane Line |
| US5 | MM | 4.65 Lt | Left Turn Lane Line |
| US5 | MM | 4.65 Lt | Right Turn Lane Line |
| Vt 9 | MM | 7.07 Lt | Left Turn Lane Line |
| Vt 9 | MM | 7.10 Lt | Right Turn Lane Line |

**Durable 24" Stop Bar**

| | | |
|---|---|---|
| US5 Rt | MM | 4.60 |
| US5 Lt | MM | 4.65 |
| Vt 9 Lt | MM | 7.05 |

**Durable Letter In Word Markings**
US5 Rt. Left Turn Lane (Only, Only)
US5 Rt Right Turn Lane (Only, Only)
US5 Rt. Ramp to Rt. 9 (YIELD)
US5 Lt Left Turn Lane (Only)
US5 Lt Rt Turn Lane (Only, Only)
Vt 9 Lt Lt Turn Lane (Only, Only)
Vt 9 Lt Rt Turn Lane (Only, Only)
Vt 9 Lt Ramp To US5 (YIELD)

**Durable 8" Reflectorized Yellow Lines**
End Treatment Isl. B Rt. S ℄
End Treatment Isl. G Rt. S ℄
End Treatment Isl. I, Vt 9 ℄

**Durable 8" Reflectorized White Lines**
US5 Rt., Island 'D' Gore Markings
US5 Lt., Island 'C' Gore Markings
US5 Rt., Island 'E' Gore Markings
US5 Lt., Island 'E' Gore Markings
Vt 9 Rt., Island 'D' Gore Markings
Vt 9 Lt., Island 'F' Gore Markings

**Durable Arrow Markings**
US 5 Rt Left Turn Lane
US 5 Rt Right Turn Lane
US 5 Lt. Left Turn Lane
US 5 Lt. Right Turn Lane

**Durable 4" Yellow Line**
US5 Centerline mm 4.50, Area as Shown
Left turn between Island B & H - US5

**Temporary 8" White Line**
Island Gore Areas As Shown (No Diagonals)

0 25 50 100
SCALE IN FEET

BRATTLEBORO

DATUM
VERTICAL
HORIZONTAL

SURVEYED BY ____ DATE ____
DRAWN BY JEM DATE ____
TRACED BY ____ DATE ____

PROJ. NO. M7000(14)3
F 200-2(13)
SHEET 10 OF 25