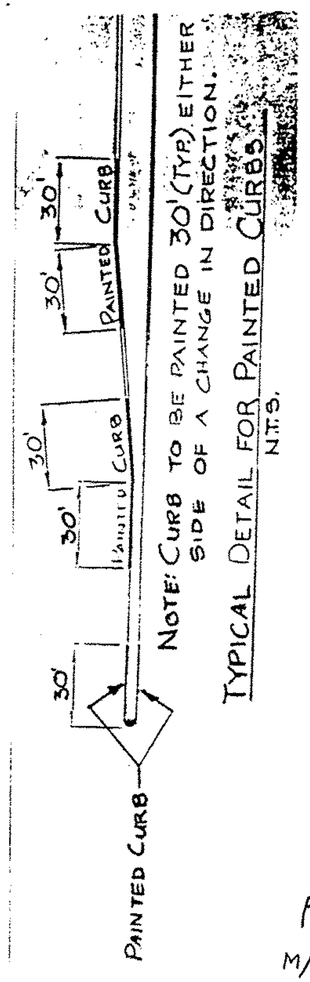

NOTE: CURB TO BE PAINTED 30' (TYP.) EITHER SIDE OF A CHANGE IN DIRECTION.

TYPICAL DETAIL FOR PAINTED CURBS

N.T.S.

NOT TO SCALE

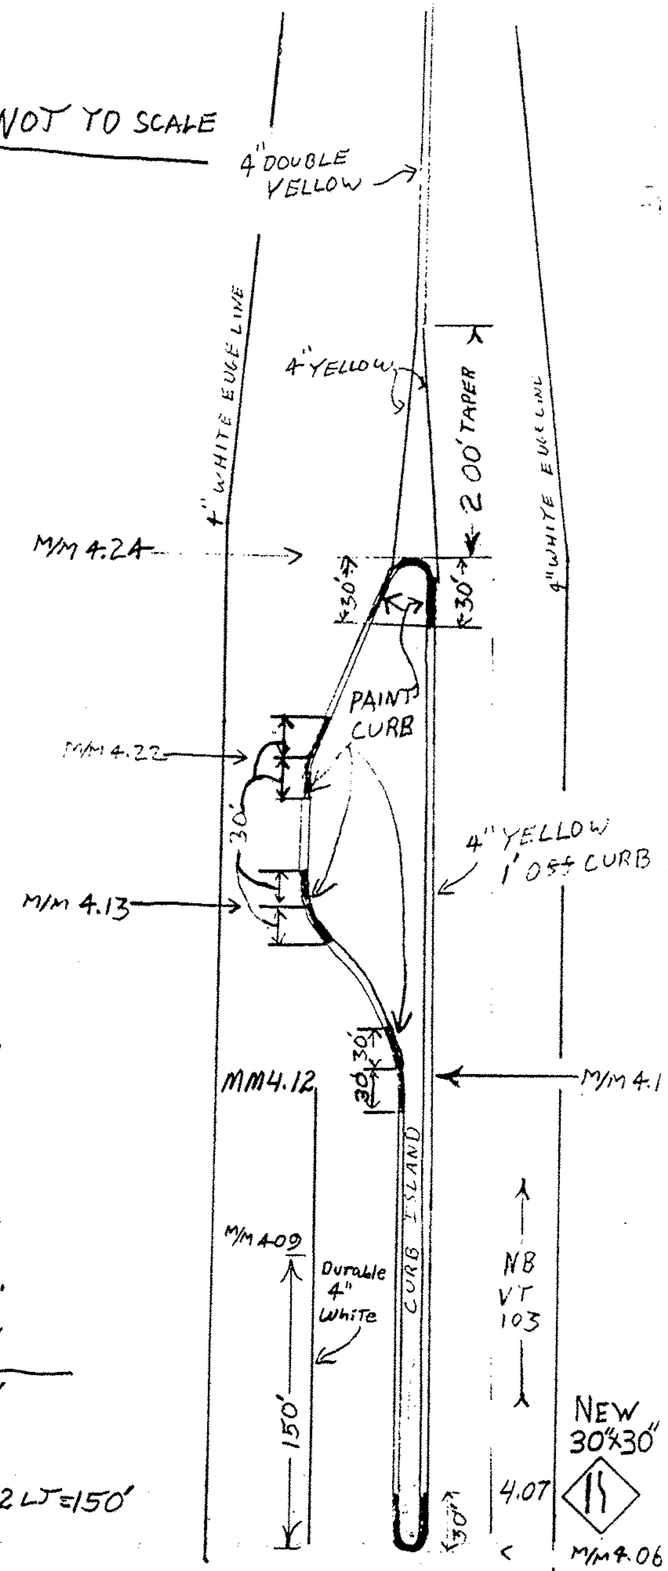

Painted Curb

M/M 4.06 - LT - 30'
4.06 - RT - 30'
MM 4.11 LT - 60'
MM 4.13 LT - 60'
MM 4.22 LT - 60'
MM 4.24 RT - 30'
4.24 LT 30'

Item 646.21 = Painted Curb Total = 300'

Item 646.60 Durable 4" White - M/M 4.06 - 4.12 LT = 150'

F025-1(26)S
LUDLOW-MT HOLLY-SHREWSBURY
SHEET 13A of 24