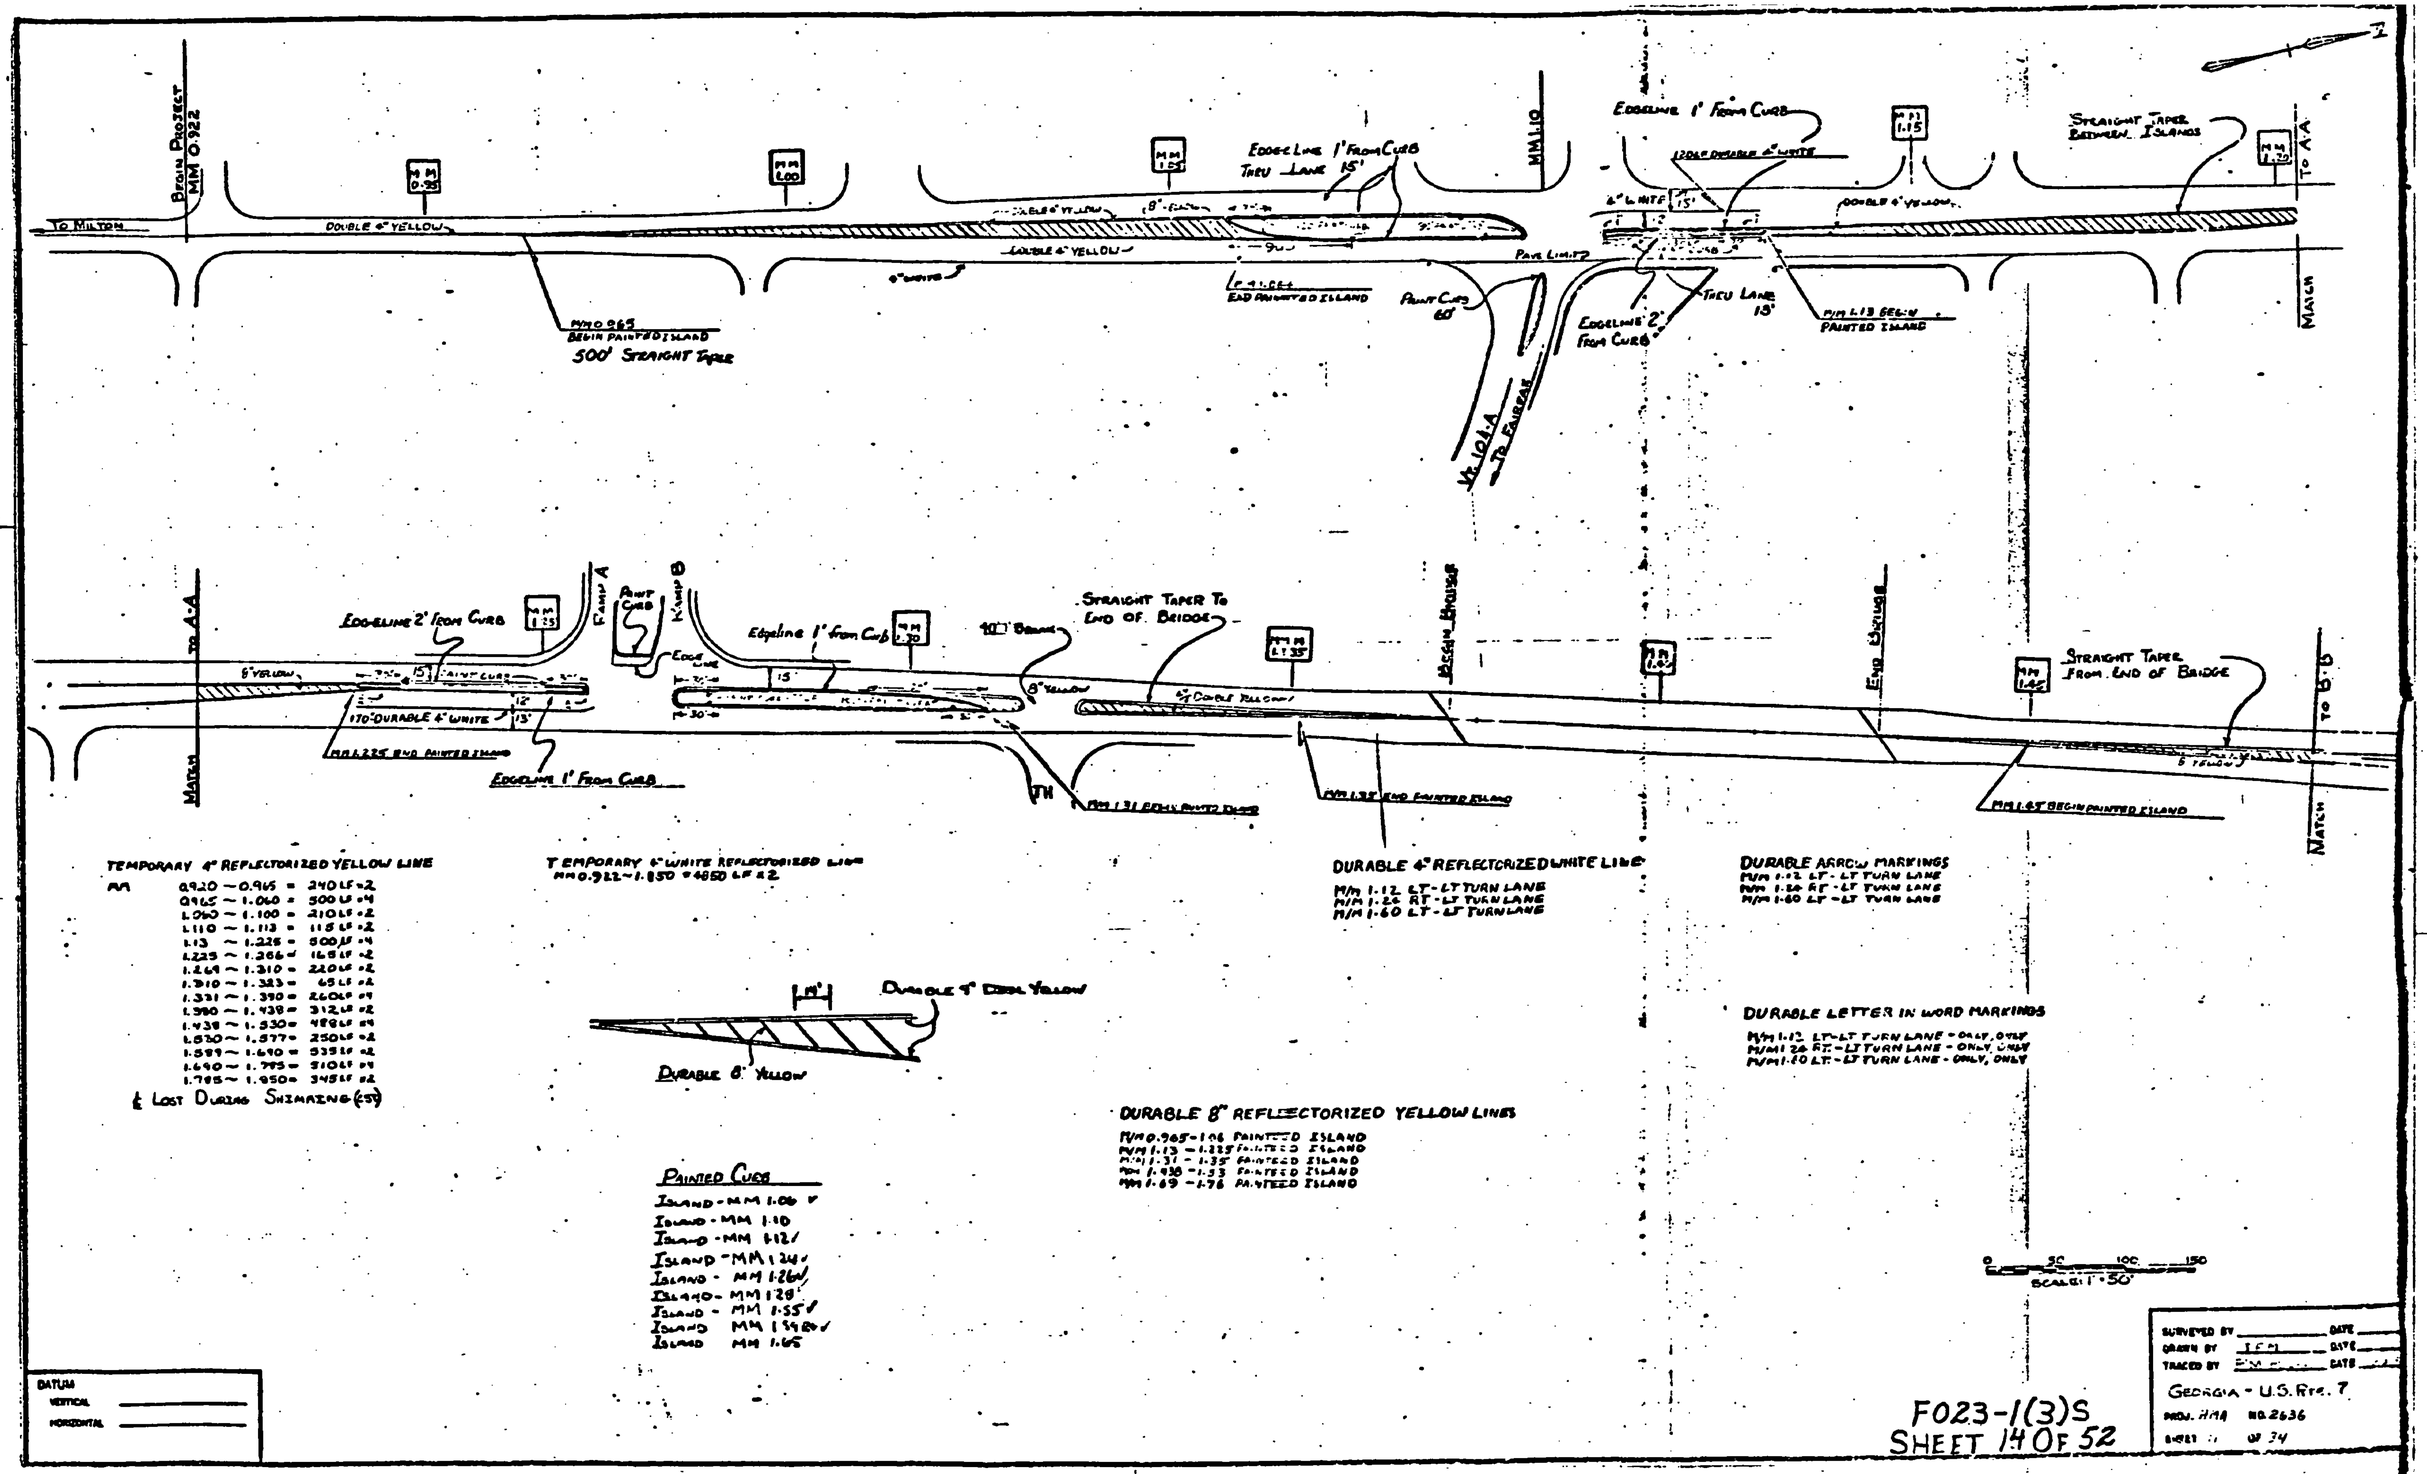
Begin Project MM 0.922
To Milton
Double 4" Yellow
MM 0.95
MM 1.00
MM 1.05
Edge Line 1' From Curb Thru Lane 15'
MM 1.10
Edgeline 1' From Curb
Double 4" White
MM 1.15
Straight Taper Between Islands
To A-A
Double 4" Yellow
Double 4" Yellow
Pave Limit
MM 0.965 Begin Painted Island
500' Straight Taper
End Painted Island
Paint Curb 60'
Edgeline 2' From Curb
Thru Lane 15'
MM 1.13 Begin Painted Island
Match
Edgeline 2' From Curb
MM 1.25
Ramp A
Paint Curb
Ramp B
Edge Line
Edgeline 1' From Curb
MM 1.30
10' Bridge
Straight Taper To End of Bridge
MM 1.35
Begin Bridge
End Bridge
MM 1.40
Straight Taper From End of Bridge
To B-B
Match
170' Durable 4" White
MM 1.225 End Painted Island
Edgeline 1' From Curb
MM 1.31 Begin Painted Island
MM 1.35 End Painted Island
MM 1.65 Begin Painted Island
Temporary 4" Reflectorized Yellow Line
MM 0.920 ~ 0.965 = 240 LF ×2
0.965 ~ 1.060 = 500 LF ×4
1.060 ~ 1.100 = 210 LF ×2
1.110 ~ 1.113 = 115 LF ×2
1.113 ~ 1.225 = 500 LF ×4
1.225 ~ 1.266 = 165 LF ×2
1.269 ~ 1.310 = 220 LF ×2
1.310 ~ 1.323 = 65 LF ×2
1.321 ~ 1.390 = 260 LF ×4
1.390 ~ 1.438 = 312 LF ×2
1.438 ~ 1.530 = 488 LF ×4
1.530 ~ 1.577 = 250 LF ×2
1.589 ~ 1.640 = 535 LF ×2
1.640 ~ 1.795 = 810 LF ×4
1.795 ~ 1.950 = 345 LF ×2
& Lost During Shimming (ST)
Temporary 4" White Reflectorized Line
MM 0.922 ~ 1.850 = 4850 LF ×2
Durable 4" Reflectorized White Line
M/M 1.12 LT - LT Turn Lane
M/M 1.26 RT - LT Turn Lane
M/M 1.60 LT - LT Turn Lane
Durable Arrow Markings
M/M 1.12 LT - LT Turn Lane
M/M 1.26 RT - LT Turn Lane
M/M 1.60 LT - LT Turn Lane
Durable Letter In Word Markings
M/M 1.12 LT - LT Turn Lane - Only, Only
M/M 1.26 RT - LT Turn Lane - Only, Only
M/M 1.60 LT - LT Turn Lane - Only, Only
Durable 4" Dbl. Yellow
Durable 8" Yellow
Durable 8" Reflectorized Yellow Lines
M/M 0.965 - 1.06 Painted Island
M/M 1.13 - 1.225 Painted Island
M/M 1.31 - 1.35 Painted Island
M/M 1.430 - 1.53 Painted Island
M/M 1.69 - 1.76 Painted Island
Painted Curb
Island - MM 1.06
Island - MM 1.10
Island - MM 1.12
Island - MM 1.24
Island - MM 1.26
Island - MM 1.28
Island - MM 1.55
Island MM 1.59
Island MM 1.65
0 50 100 150
Scale: 1" = 50'
Datum
Vertical
Horizontal
Surveyed By Date
Drawn By J.F.M. Date
Traced By Date
Georgia - U.S. Rte. 7
Proj. HM NO. 2636
Sheet 14 of 34
F023-1(3)S
Sheet 14 of 52