TRAFFIC SIGN SUMMARY SHEET

MILEMARKER, STATION, OR SIGN NUMBER	SIGN LEGEND	SIGN DIMENSIONS	EXISTING SIGNS TO BE SALVAGED: REMOVE (EA.)	II X	RETAIN (X)	NEW AND SALVAGED SIGNS: NEW "A" (S.F.)	NEW "B" (S.F.)	SALV. SIGN (EA.)	SALV. T.I.S. (S.F.)	EXISTING POSTS: RET.	DRILL	REM.	SALV.	NEW SIGN POSTS: NUMBER OF POSTS	FLANGED CHANNEL: 2.0 LB./FT.	2.5 LB./FT.	3.0 LB./FT.	TUBULAR ALUMINUM: 3.0" ∅	3.0" □	4.0" ∅	4.0" ∅ MOD.	W SHAPED STEEL: POST SIZE	WEIGHT	FTG. SIZE 24"	30"	REMARKS	FOR SIGN DETAIL SHEET: PLAN SHEET NUMBER	STD. SHEET NUMBER

--L.82-Lt.		30" x 30"	1			6.3						X		1		X												E-19A
--L.84-Lt.			1									X																
--L.94-Lt.			1									X																
--2.09-Lt.		30" x 30"				6.3								1		X												E-19A
--2.13-Lt.			1									X(2)																
--2.13-Lt.		36" x 36"				9.0								1			X										TD 557	
--2.24-Rt.			1									X																
--2.24-Rt.			1																									
--2.41-Lt.		12" x 36"				3.0								1	X												TD 558	E-7
--2.41-Rt.		12" x 36"				3.0								1	X												TD 558	E-7
--2.44-Lt.		12" x 36"				3.0								1	X												TD 558	E-7
--2.44-Rt.		12" x 36"				3.0								1	X												TD 558	E-7
--2.46-Rt.		24" x 30"	1			5.0						X		1	X													E-15A
--2.50-Rt.	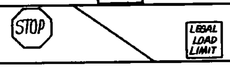	30" x 30" 24" x 24"	1			6.3 4.0						X		1	X													E-15C E-15A
--2.50-Rt.			1	X				1				X		1	X													
--2.54-Lt.			1									X																
--2.54-Lt.			1									X																
--2.56-Rt.		24" x 30"	1			5.0						X(2)		1	X													E-15B
--2.61-Rt.			1							X																		
--2.61-Rt.		30" x 30"				6.3																				Mount on Retained Post	TD 557	

TOTALS			13			60.2#		1						11	228#	80#	48#											

FINAL LENGTHS ARE TO BE DETERMINED IN THE FIELD, POST SIZES ARE COMPUTED BASED ON INFORMATION FURNISHED ON THE STANDARD SHEETS AND THE DESIGN DIVISION'S "SIGN POST DESIGN MANUAL".

PREPARED BY JB DATE 1-86

CHECKED BY _____ DATE _____

PROJ. MENDON ~ SHERBURNE STATEWIDE NO. F-SFTY (85)S

TRAFFIC SHEET NO. 70447 SHEET 123 OF 200

1986