TRAFFIC ITEM AND TRAFFIC SIGN SUMMARY SHEET, NOTES AND DETAILS

MILEMARKER, STATION, OR SIGN NUMBER	SIGN LEGEND	SIGN DIMENSIONS	EXISTING SIGNS TO BE SALVAGED: REMOVE (EA.)	RETAIN (X)	NEW AND SALVAGED SIGNS: NEW "A" (S.F.)	NEW "B" (S.F.)	SALV. SIGN (EA.)	SALV. T.I.S. (S.F.)	EXISTING POSTS: RET.	DRILL	REM.	SALV.	NEW SIGN POSTS: NUMBER OF POSTS	FLANGED CHANNEL: 2.0 LB./FT.	2.5 LB./FT.	3.0 LB./FT.	TUBULAR ALUMINUM: 3.0" Ø	3.0" □	4.0" Ø	4.0" Ø MOD.	W SHAPED STEEL: POST SIZE	WEIGHT	FTG. SIZE 24"	30"	REMARKS	FOR SIGN DETAIL SHEET: PLAN SHEET NUMBER	STD. SHEET NUMBER

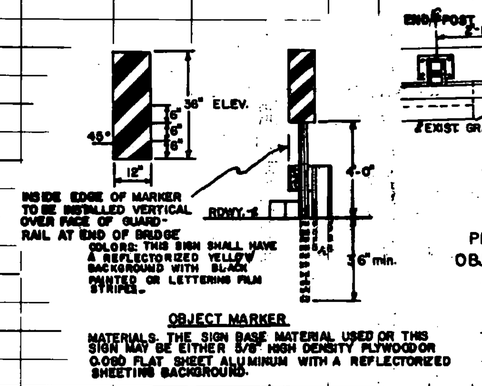

OBJECT MARKER

MATERIALS: THE SIGN BASE MATERIAL USED OR THIS SIGN MAY BE EITHER 5/8" HIGH DENSITY PLYWOOD OR 0.080 FLAT SHEET ALUMINUM WITH A REFLECTORIZED SHEETING BACKGROUND.

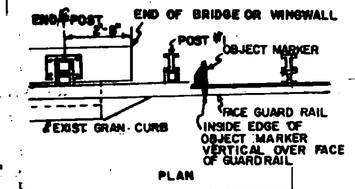

PLACEMENT OF OBJECT MARKERS

For Materials, see Standard ✳*E-*

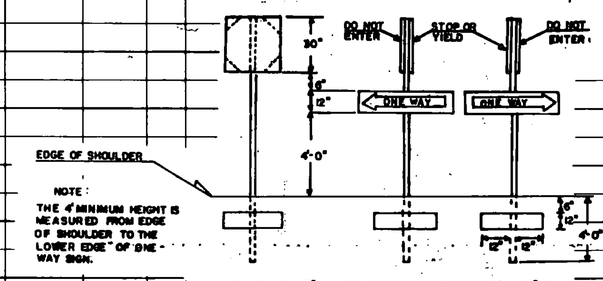

REGULATORY SIGN ASSEMBLY DETAIL

TRAFFIC ITEM SUMMARY

ITEM NO.	ITEM	UNIT			QUANTITY	RND.	TOTAL
646.50	Temp. 4" White Line	L.F.			1000		1000
646.51	Temp. 4" Yellow Line	L.F.			2550	50	2600
646.54	Temp. 8" White Line	L.F.			200		200
646.55	Temp. 8" Yellow Line	L.F.			500		500
646.60	Temp. 24" Stop Bar	L.F.			16		16
646.62	Temp. Arrow Markings	EA.			4		4
646.64	Temp. Letter In Word Marking	EA.			20		20
646.80	Removal of Existing Pavement Markings	S.F.			100		100
675.20	Traffic Signs, Type A	S.F.			727.6	7.4	735.0
675.21	Traffic Signs, Type B	S.F.			50.0		50.0
675.30	Flanged Channel Sign Posts	L.B.			3962.	38	4000
675.38	Tubular Aluminum Sign Posts	L.B.			348	2	350
675.50	Removing Signs	EA.			139	1	140
675.60	Erecting Salvaged Signs	EA.			20		20
680.20 MOD.	Travel Information Signs (Non-participating Fed. Funds)	S.F.			33.2	0.8	34

SEE SHEET TD 504 FOR PROJECT SUMMARY OF QUANTITIES AND REVISION NOTE FOR LEGAL LOAD LIMIT SIGNING.

NOTES AND DETAILS

✳ FLAT SHEET ALUMINUM - 0.125"
HIGH DENSITY OVERLAID PLYWOOD - 5/8"
GALVANIZED FLAT SHEET STEEL - 12 GAGE

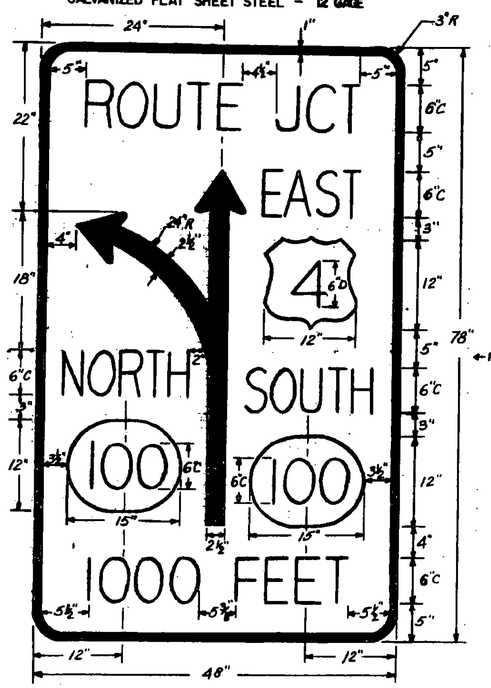

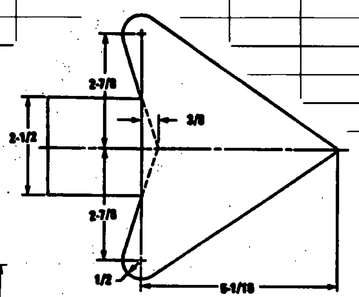

✳ E-15

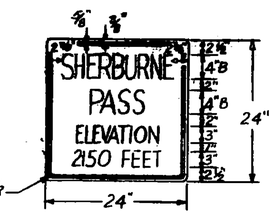

✳ E-15

COLORS

LEGEND - WHITE (REFL)
BACKGROUND - GREEN
← ROUTE NUMERALS - BLACK

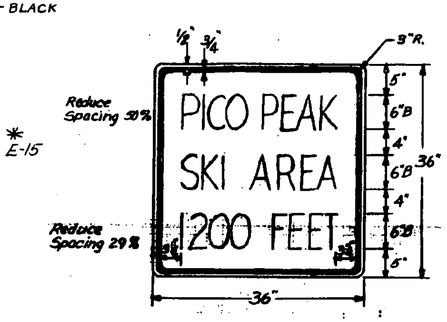

✳ E-15

✳ E-15

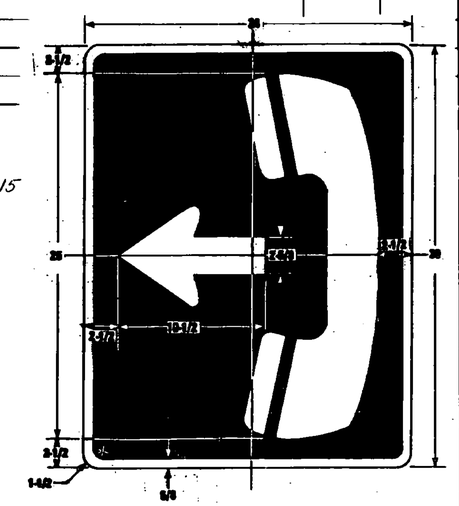

COLORS

LEGEND - WHITE (REFL)
BACKGROUND - BLUE

DRAWN BY JB DATE 3-86
CHKED BY _____ DATE _____

MENDON ~ SHERBURNE
PROJ. STATEWIDE NO. F-SFTY (85) S
TRAFFIC SHEET NO. 70530 SHEET 134 OF 200

BRUNING S3428.3