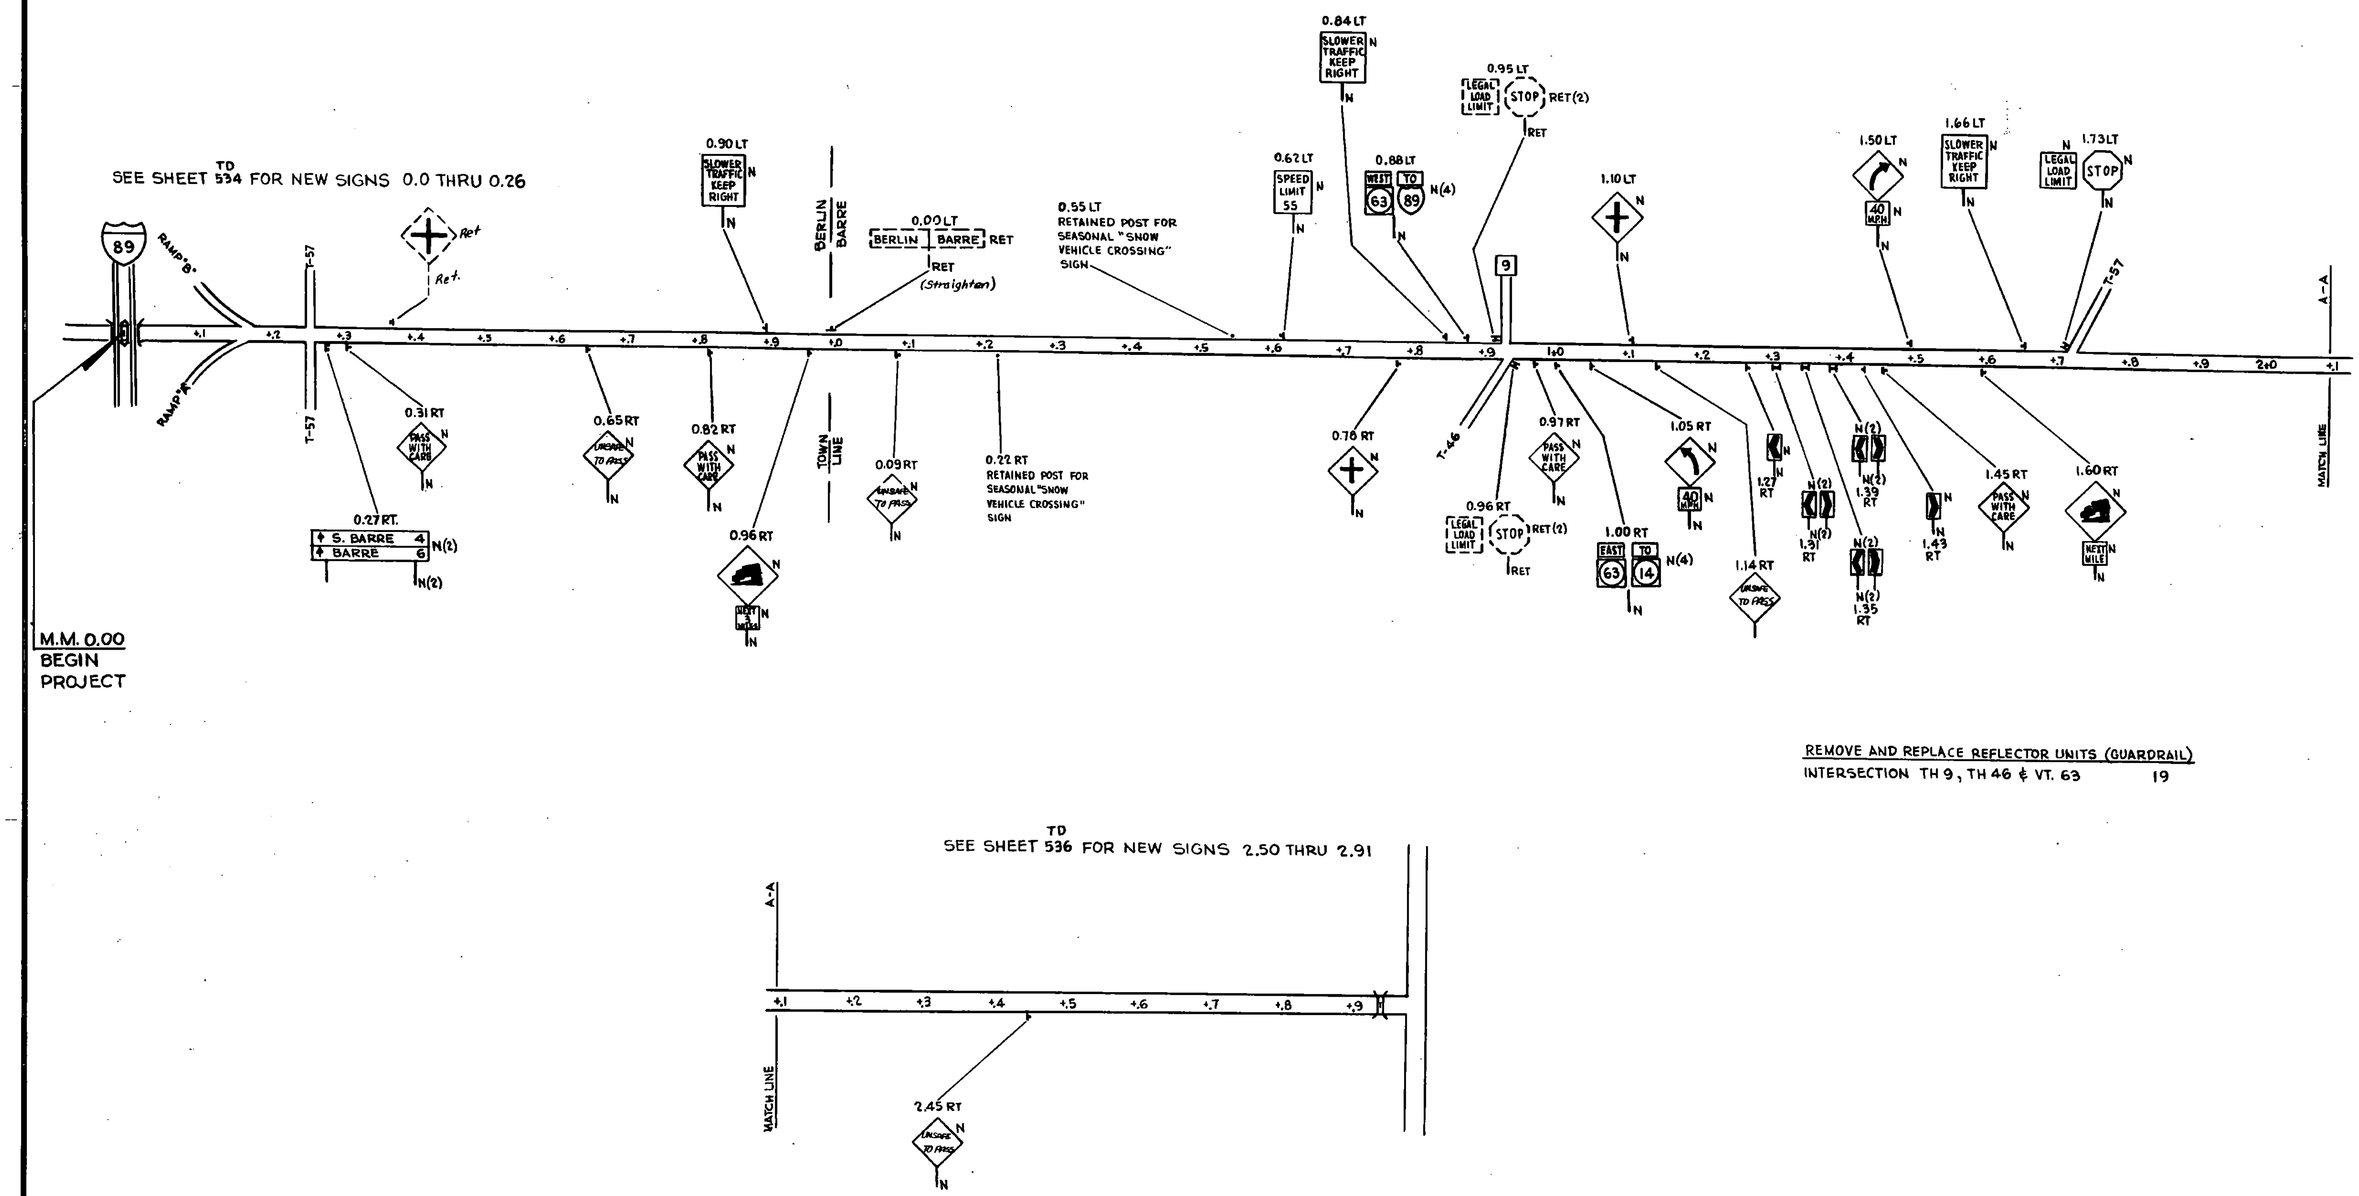

REMOVE AND REPLACE REFLECTOR UNITS (GUARDRAIL)
INTERSECTION TH 9, TH 46 & VT. 63 19

NEW AND SALVAGED SIGNS
0.26 TO 2.50

DATUM
VERTICAL
HORIZONTAL

SURVEYED BY DATE
DRAWN BY DATE
TRACED BY DATE

BERLIN - BARRE
PROJ. STATEWIDE NO. F-SFTY (85) S
SHEET 89 OF 200

TRAFFIC SHEET NO. D535 SHEET OF

BRUNING 53-425-3
07