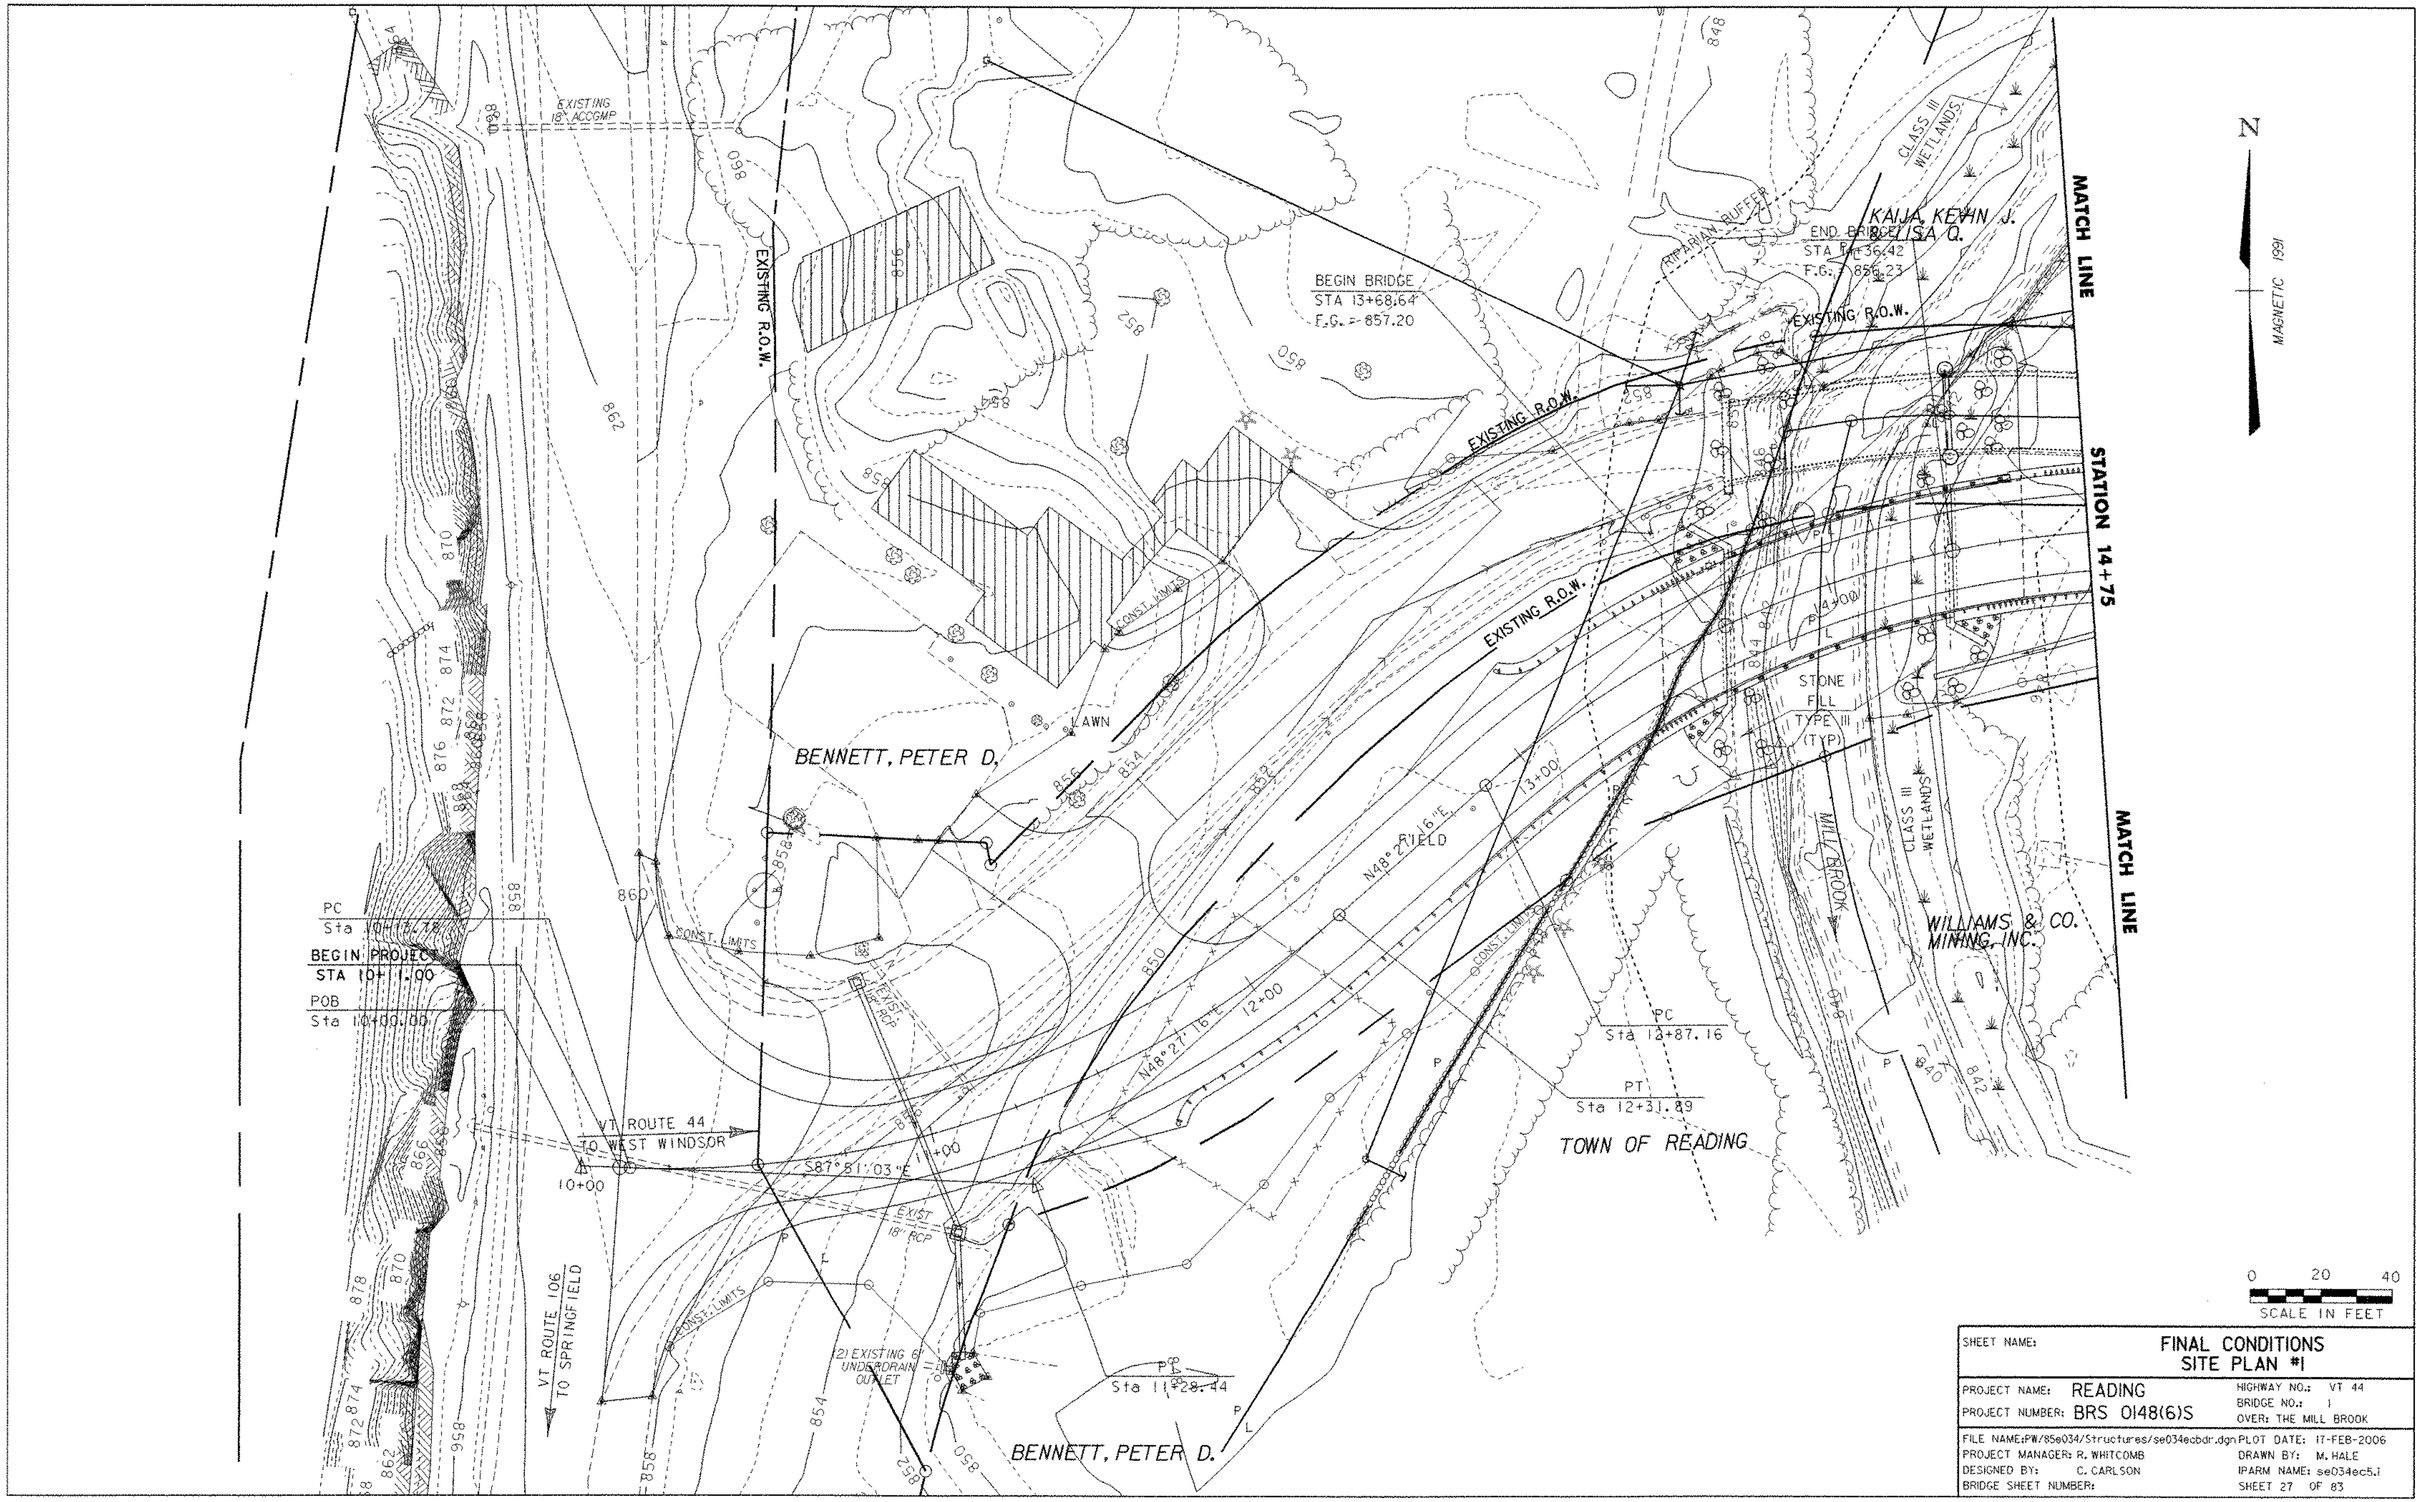

SHEET NAME:	FINAL CONDITIONS SITE PLAN #1
PROJECT NAME: READING	HIGHWAY NO.: VT 44
PROJECT NUMBER: BRS 0148(6)S	BRIDGE NO.: 1
	OVER: THE MILL BROOK
FILE NAME: PW/85e034/Structures/se034ecbdr.dgn	PLOT DATE: 17-FEB-2006
PROJECT MANAGER: R. WHITCOMB	DRAWN BY: M. HALE
DESIGNED BY: C. CARLSON	IPARM NAME: se034ec5.i
BRIDGE SHEET NUMBER:	SHEET 27 OF 83