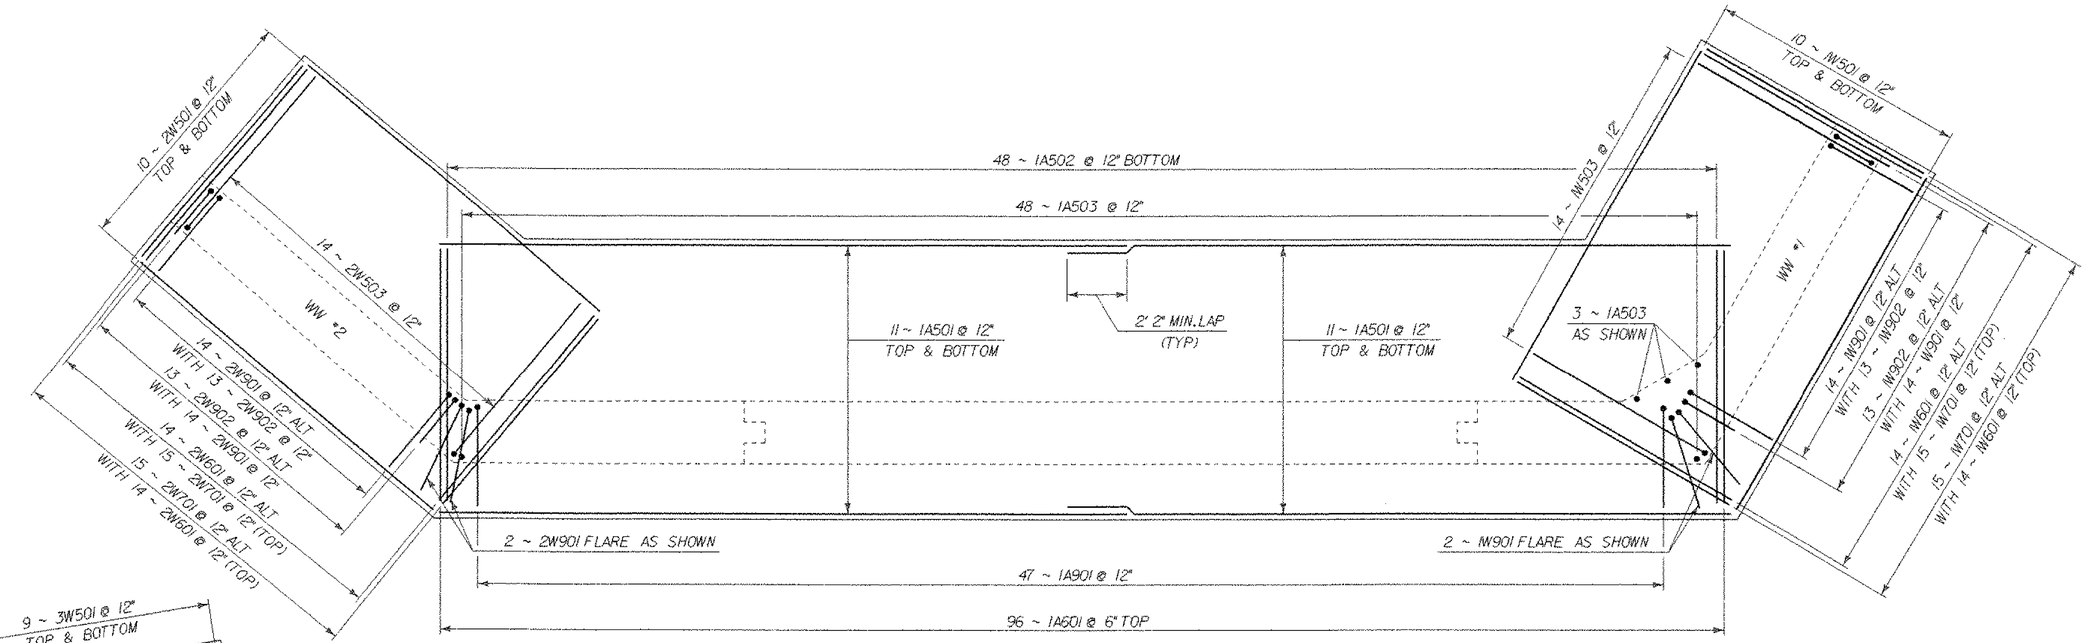

ABUTMENT #1 FOOTING REINFORCING

SCALE 3/8" = 1'-0

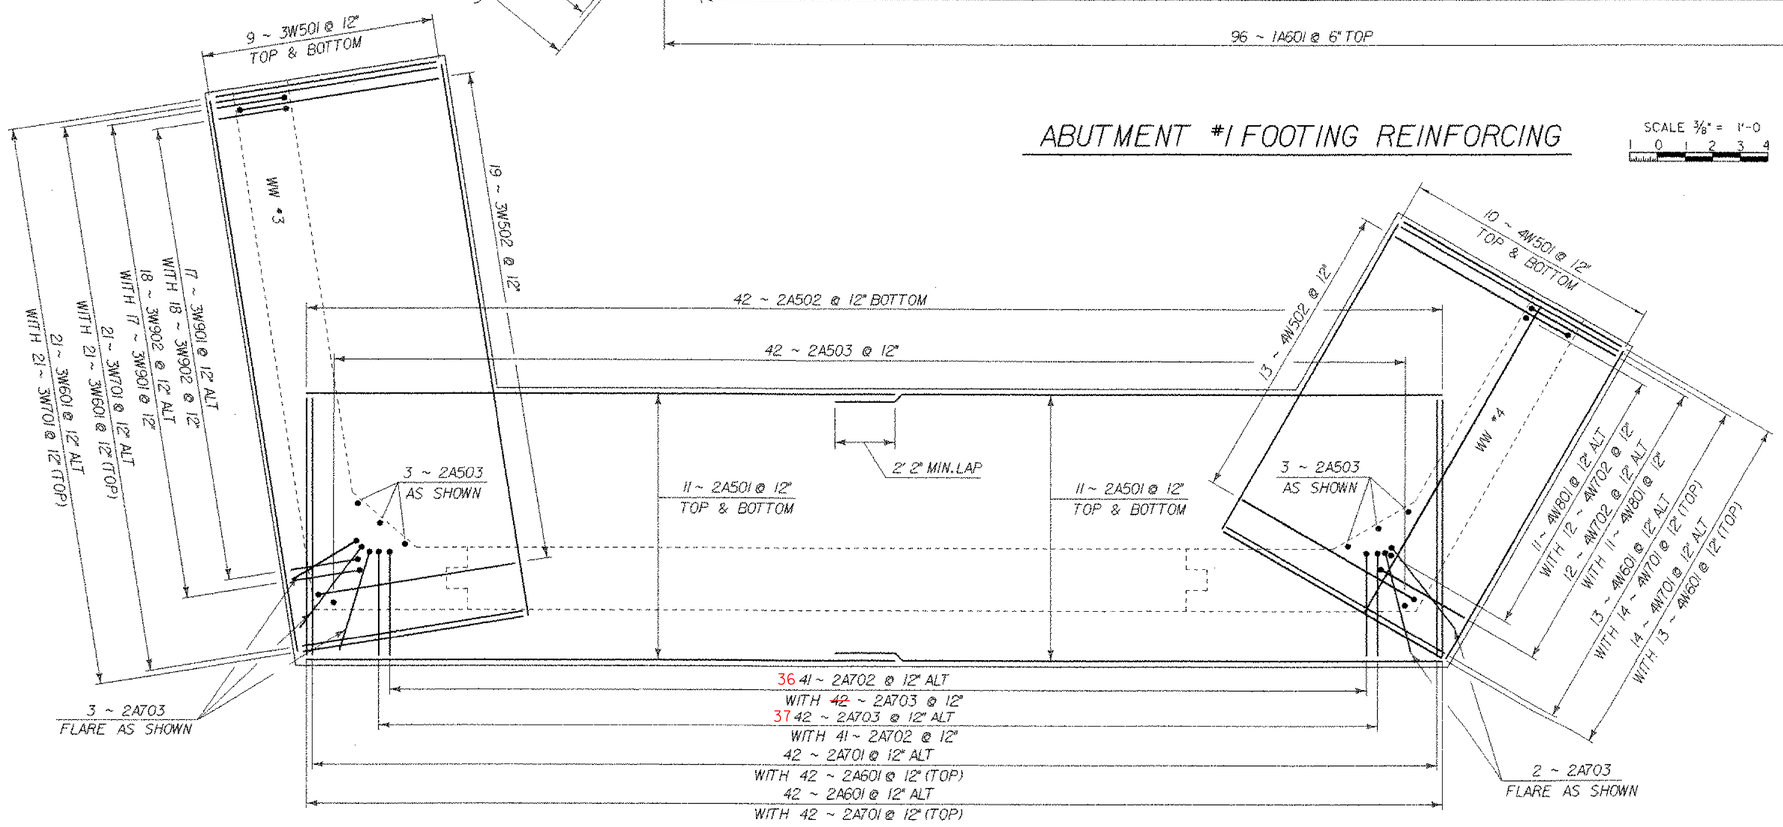

ABUTMENT #2 FOOTING REINFORCING

SCALE 3/8" = 1'-0

SHEET NAME:	FOOTING REINFORCING		
PROJECT NAME:	READING	HIGHWAY NO.:	VT 44
PROJECT NUMBER:	BRS 0148(6)S	BRIDGE NO.:	1
		OVER:	THE MILL BROOK
FILE NAME: PW/85e034/Structures/se034sub.dgn		PLOT DATE:	17-FEB-2006
PROJECT MANAGER: R. WHITCOMB		DRAWN BY:	T. FILLBACH
DESIGNED BY: C. CARLSON		IPARM NAME:	se034ftr.l
BRIDGE SHEET NUMBER:		SHEET 55 OF 83	