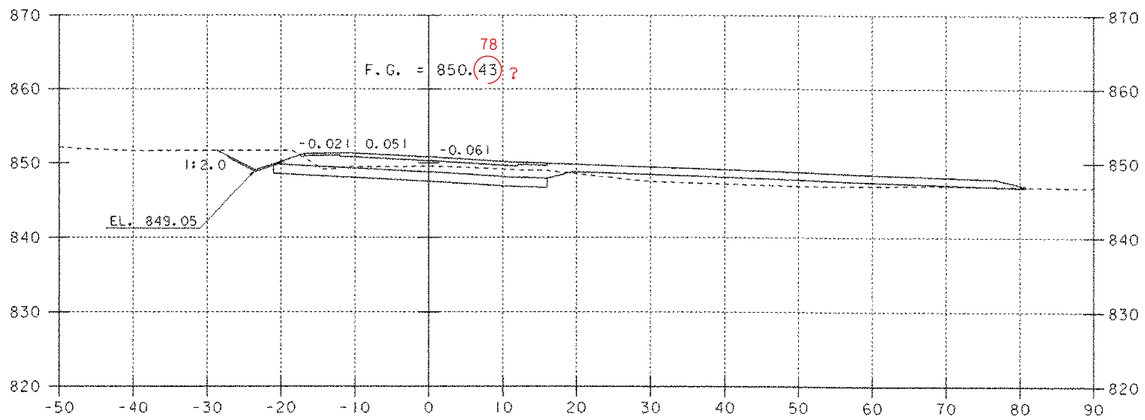


17+04
DRIVE RIGHT

SEE SHEET 76 FOR DRIVE DETAILS

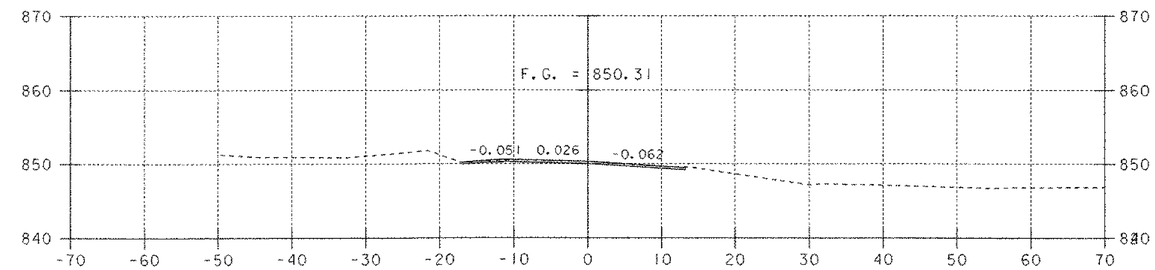


STA 18+50 LT
END SPECIAL DITCH
WITH EROSION MATTING

18+50
END APPROACH

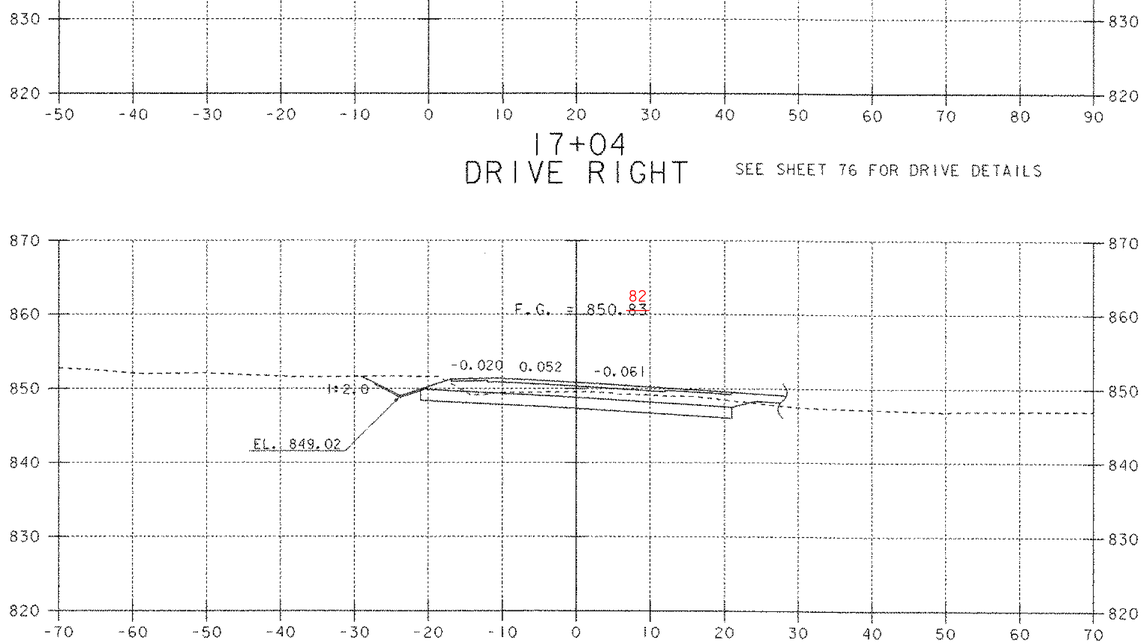


17+00

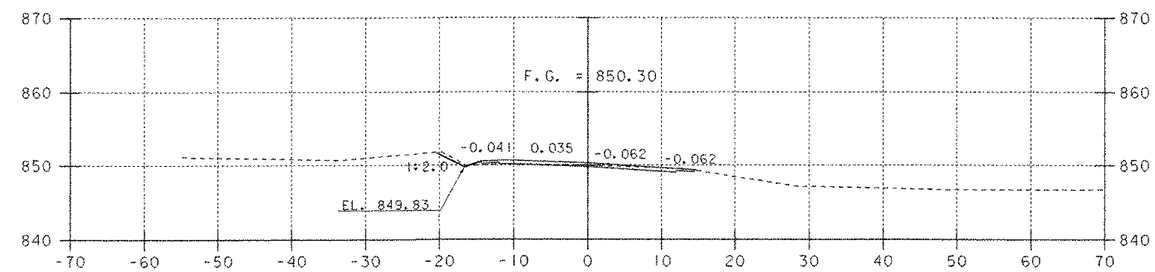


18+00

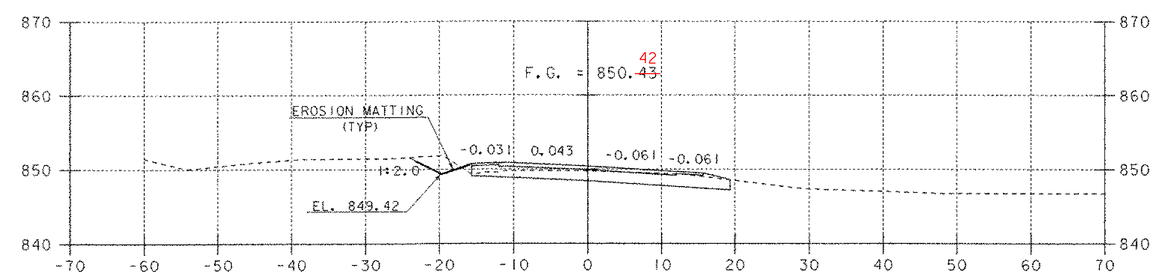


17+50

10 0 10
SCALE: 1" = 10'-0"

| | |
|---|---|
| SHEET NAME: MAINLINE CROSS SECTIONS | |
| PROJECT NAME: READING<br>PROJECT NUMBER: BRS 0148(6)S | HIGHWAY NO.: VT 44<br>BRIDGE NO.: 1<br>OVER: THE MILL BROOK |
| FILE NAME: PW/85e034/Structures/se034xsl.dgn<br>PROJECT MANAGER: R. WHITCOMB<br>DESIGNED BY: C. CARLSON<br>BRIDGE SHEET NUMBER: | PLOT DATE: 17-FEB-2006<br>DRAWN BY: J. GILMORE<br>IPARM NAME: se034mx8.1<br>SHEET 70 OF 83 |