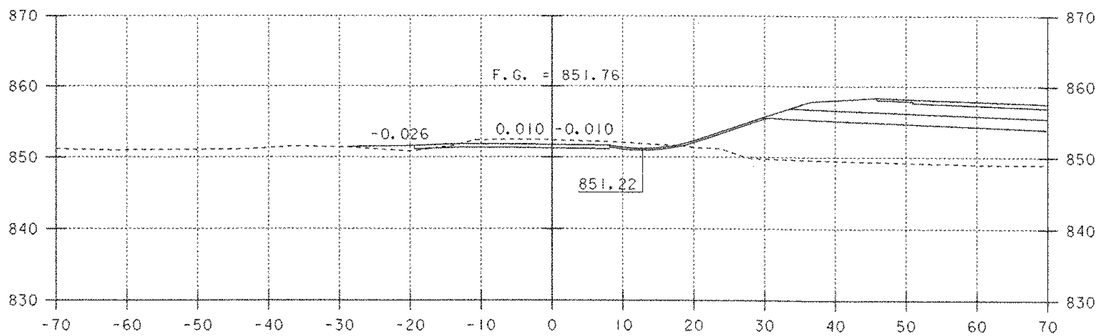

51+25

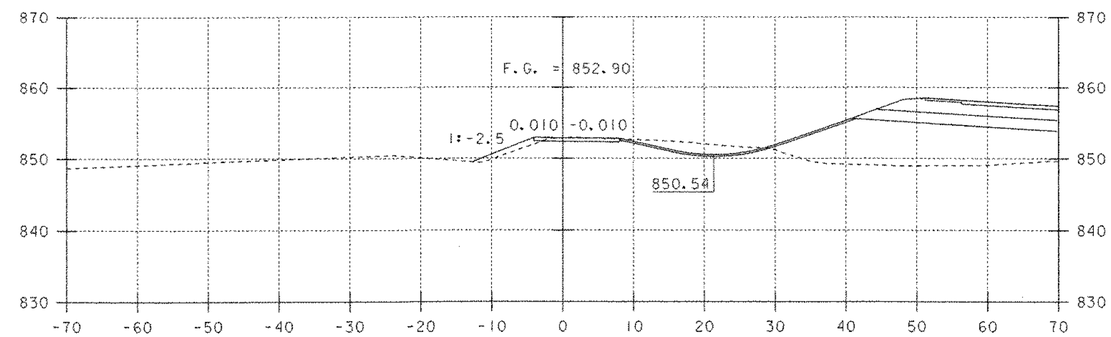

STA 51+56
END DRIVE

51+56

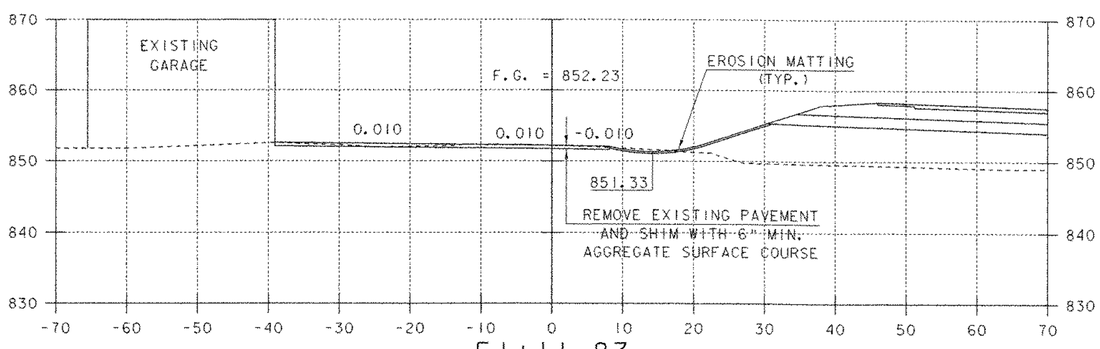

51+11.83
DRIVE LEFT
SKEW = -9° 12' 27"

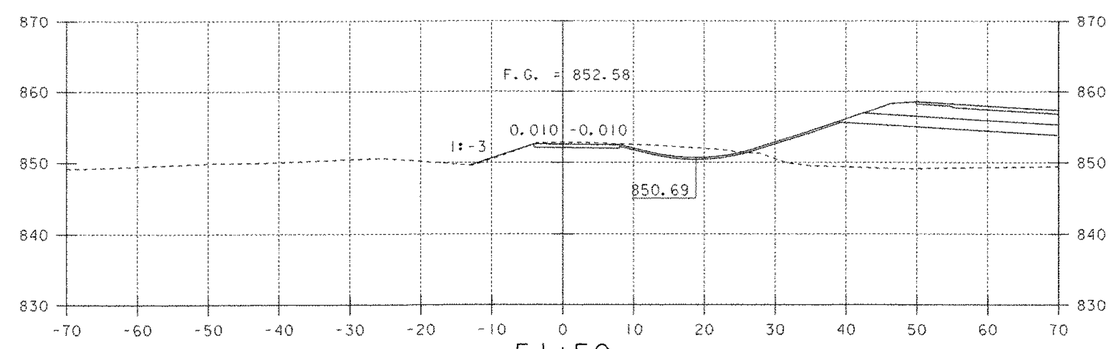

51+50

DRIVE 2

10 0 10
SCALE: 1" = 10'-0"

SHEET NAME: DRIVE CROSS SECTIONS	
PROJECT NAME: READING PROJECT NUMBER: BRS 0148(6)S	HIGHWAY NO.: VT 44 BRIDGE NO.: 1 OVER: THE MILL BROOK
FILE NAME: PW/85e034/Structures/se034xsl.dgn PROJECT MANAGER: R. WHITCOMB DESIGNED BY: C. CARLSON BRIDGE SHEET NUMBER:	PLOT DATE: 17-FEB-2006 DRAWN BY: G. ROY IPARM NAME: se034dx3.1 SHEET 75 OF 83