STATE OF VERMONT
AGENCY OF TRANSPORTATION

TRAFFIC SIGN SUMMARY SHEET

MILEMARKER, STATION, OR SIGN NUMBER	SIGN LEGEND	SIGN DIMENSIONS EA	WIDTH (in)	HEIGHT (in)	NEW & SALVAGED SIGNS "A"	"B"	SALV SIGN	SALV TIS	EXIST POST RETAIN	SALVAGE	NEW SIGN POSTS NO. OF POSTS	FLANGED CHANNEL lb/ft 1.12	2.0	3.0	SQUARE STEEL (in) lb/ft 1.75	2.0	2.5	ANCHOR	SLEEVE	TUBULAR ALUMINUM Ø (in) lb/ft 3.0	4.0	4.0 MOD	TUBULAR STEEL Ø (in) FOUND-ATION	lb/ft 3.0	3.5	4.0	5.0	W-SHAPE STEEL FTG. SIZE 24"	30"	WEIGHT	POST SIZE	SIGN FRAME REQUIRED	REMARKS	SIGN DETAIL DETAIL IN SHS	DETAIL ON SHEET NUMBER	STD. SHEET NUMBER
												1.3	1.7	1.7	7.6	9.0	10.8	14.6																		
												OPTION ITEMS																								
14+23.4 RT		1	48	24	8.0		~~X~~				2					13.5 X 13.5		X															WI-6L	X		
14+39.0 RT		1	6	8	0.33						1				X	6.0		X															VD-701 BRIDGE 208 VT 100			E-134
15+21.4 LT		1	6	8	0.33						1				X	6.75		X															VD-701 BRIDGE 208 VT 100			E-134
15+61.1 RT		1	48	24			X				2					14.75 X 13.75		X															WI-6R	X		
16+59.1 RT	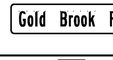	1	60	12	5.00						2					11.0 X 11.25		X															D3-1 GOLD BROOK RD (TWO SIDED PLAQUE)		SEE BELOW	
0+39.5 LT		1	30	30			X				1					X 13.25		X															R1-1	X		
		1	6	10	0.42																												VD-700 1000 / 0808 / 0153			E-138
0+49.7 RT		1	24	30	5.00						1					X 14.75		X															VR-017 LINE 3: 24,000			E-141

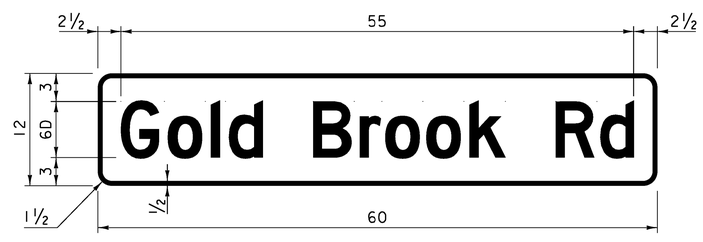

COLORS: LEGEND & BORDER - WHITE (RETROREFLECTIVE)
BACKGROUND - GREEN (RETROREFLECTIVE)

MATERIALS: 0.125" FLAT SHEET ALUMINUM

FINAL POST LENGTHS ARE TO BE DETERMINED IN THE FIELD. POST SIZES ARE COMPUTED BASED ON INFORMATION FURNISHED ON THE STANDARD SHEETS AND VTRANS "SIGN POST DESIGN GUIDELINE."
SHS = STANDARD HIGHWAY SIGNS

POST TOTALS						FT	FT	FT	FT 20	FT ~~112~~ 118.25	FT		EA	LB	LB	LB		LB	LB	LB	LB			
SUB-TOTAL	SF 11.08	SF	EA ~~3~~ 2	SF		FT			FT ~~132~~ 138.25					LB			EA	LB				EA	EA	LB
TOTALS	SF 11.08	SF	EA ~~3~~ 2	SF		FT			FT ~~132~~ 138.25					LB			EA	LB				EA	EA	LB

PROJECT NAME: STOWE
PROJECT NUMBER: BRF 029-1(17)

FILE NAME: s85e037sign.dgn
PROJECT LEADER: C. CARLSON
DESIGNED BY: H. I. SALLS
TRAFFIC SIGN SUMMARY

PLOT DATE: 17-JUN-2013
DRAWN BY: R. PELLETT
CHECKED BY: G. ROY
SHEET 24 OF 70