New head wall at Sta 20+019.080 Rt and the new pipe is at an 18.4° skew to the tangent ending at Sta 20+021.500 Lt with head wall.

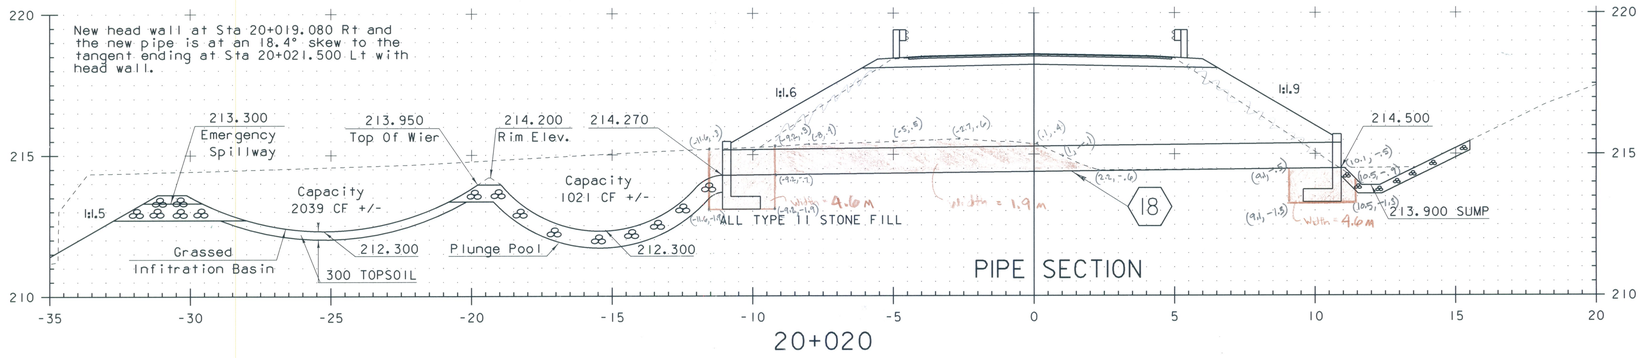

20+020

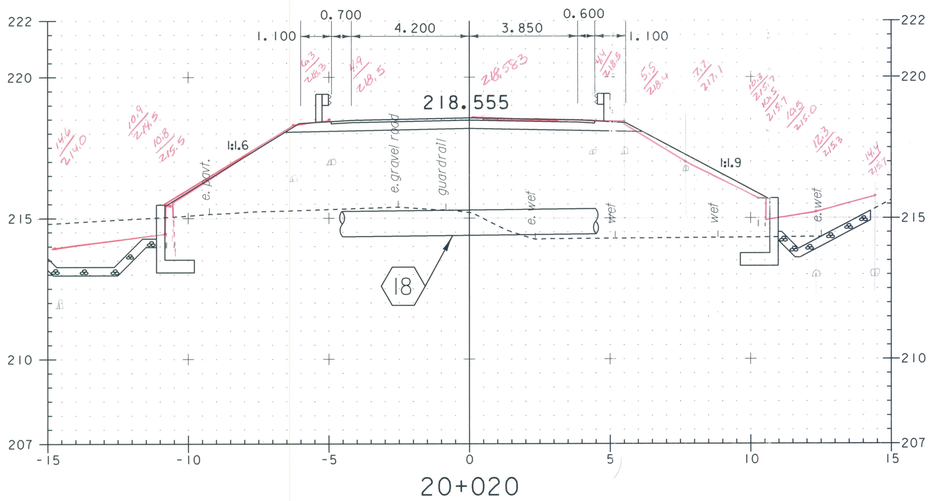

20+020

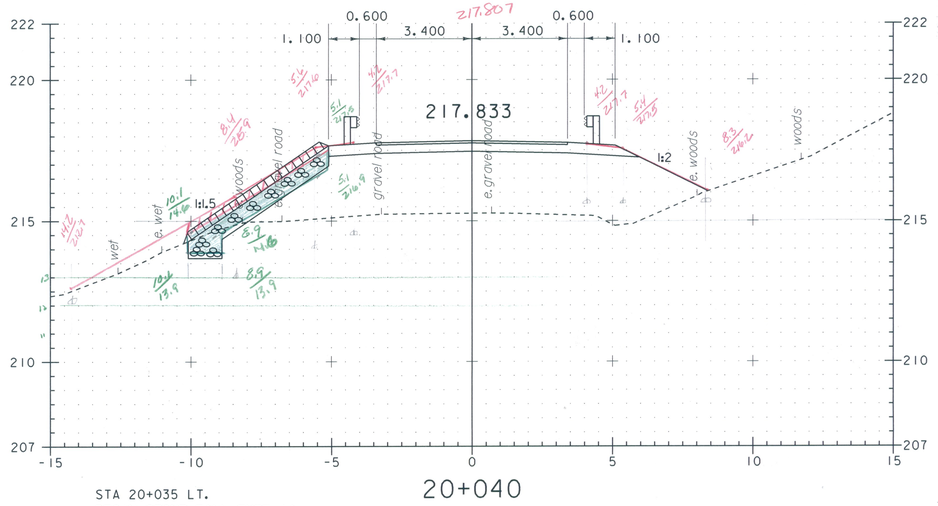

20+040

STA 20+035 LT.
BEGIN STONE FILL TYPE II
BEGIN GEOTEXTILE FOR STONE FILL
BEGIN GRUBBING MATERIAL

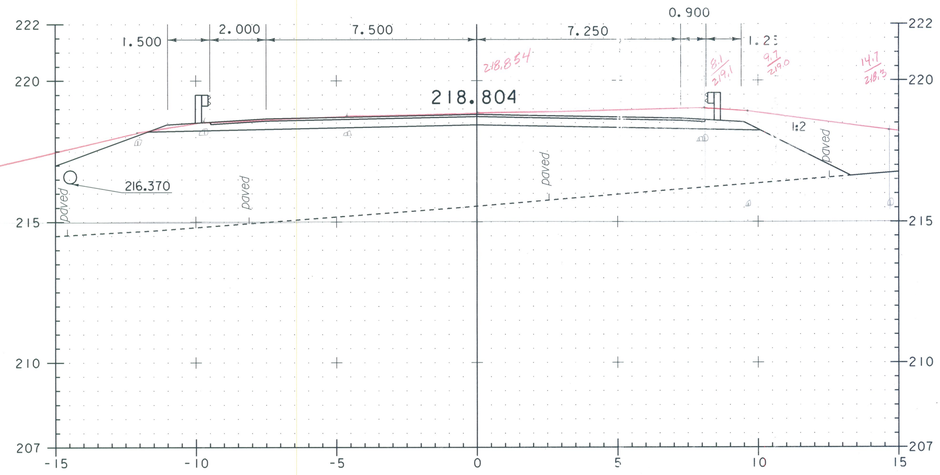

20+010

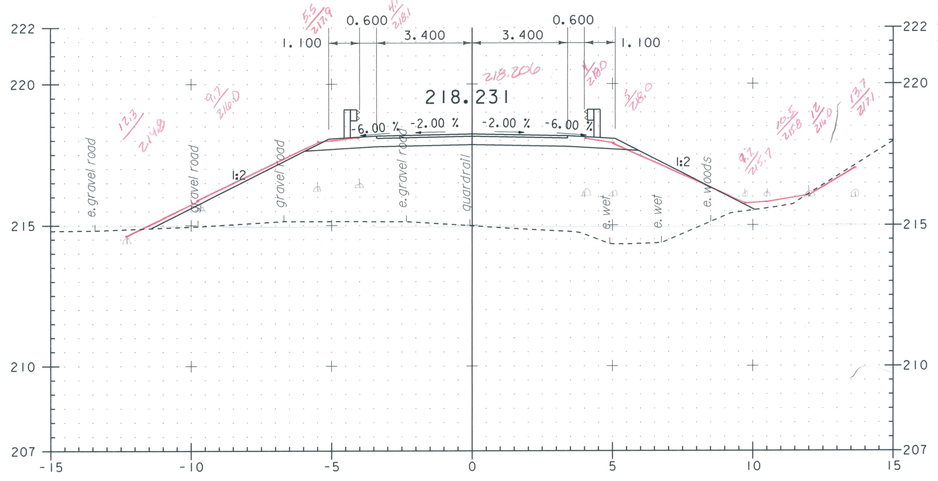

20+030

0 5 10

GRAPHIC SCALE 1:100

STA 20+010 TO 20+040

SEE SHEET 12 FOR DRAINAGE FLAG DESCRIPTIONS

PROJECT NAME:	STOCKBRIDGE
PROJECT NUMBER:	BRF 022-1(20)
FILE NAME: /srt5/85e039/de039xsl.dgn	PLOT DATE: 08-APR-2010
PROJECT LEADER: C.P. Williams	DRAWN BY: G. Shangraw
DESIGNED BY: G. Shangraw	CHECKED BY: R.S. Young
STONY BROOK ROAD CROSS SECTIONS 2	SHEET 127 OF 139