Metric

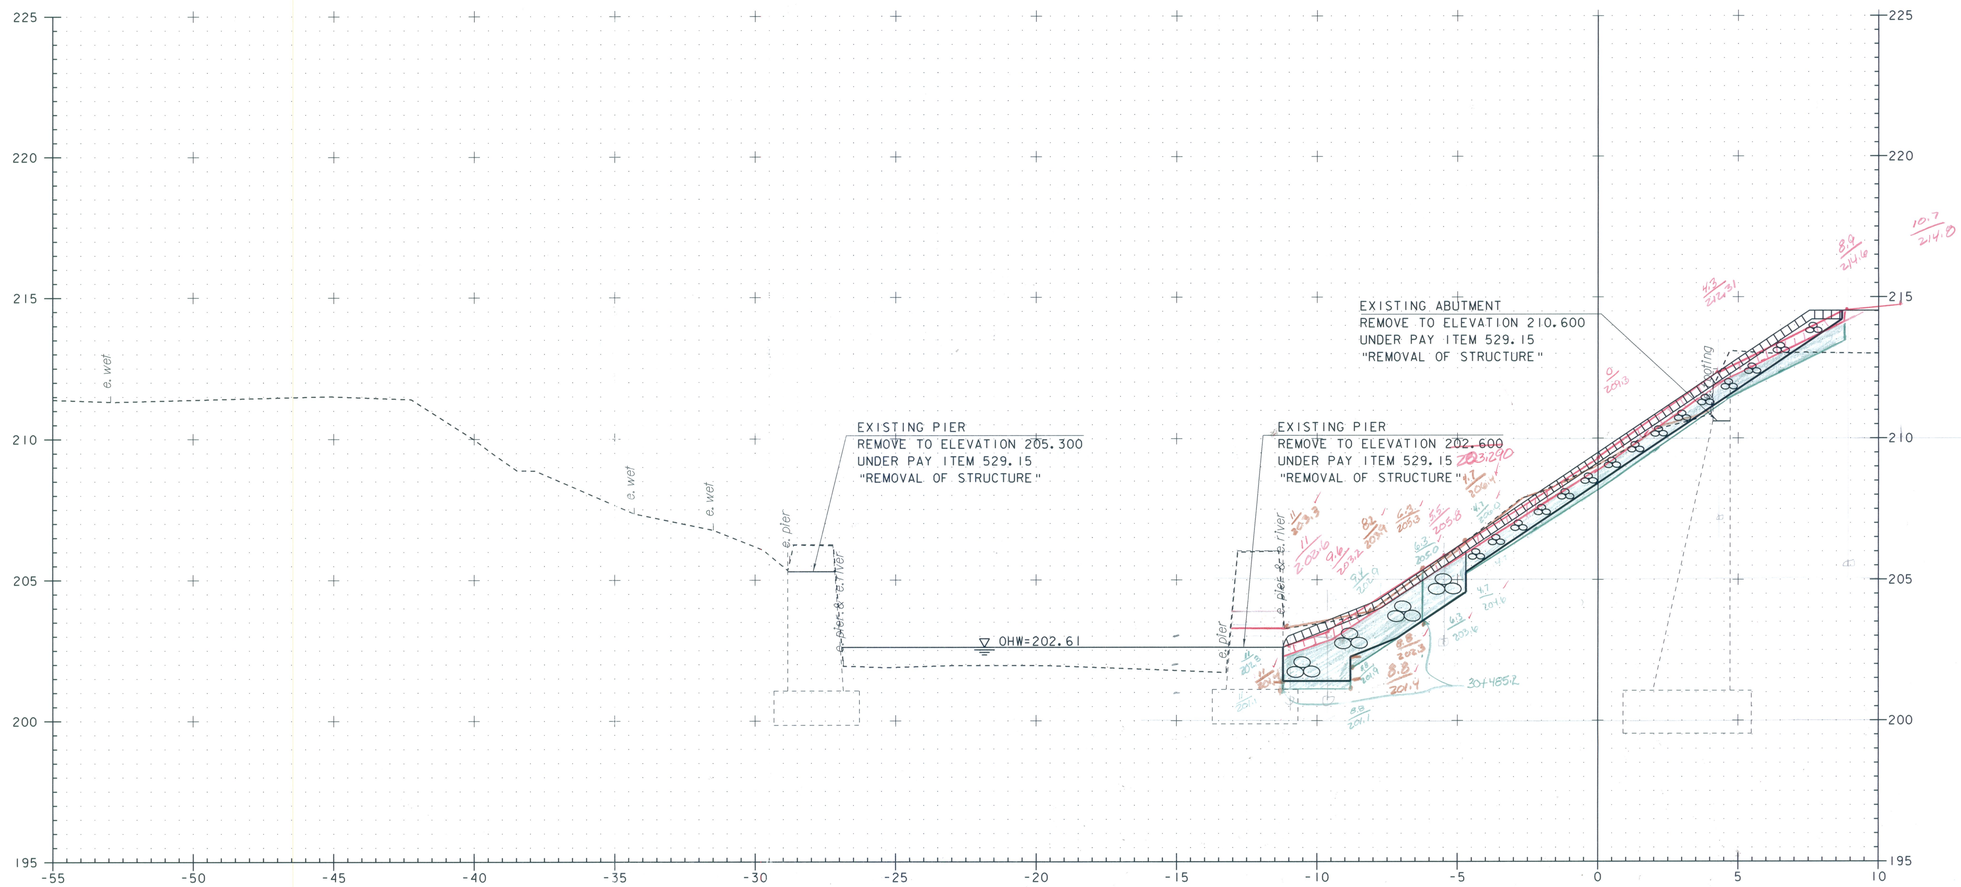

30+490

30+483.0 LT
BEGIN UNCLASSIFIED CHANNEL EXCAVATION
BEGIN GEOTEXTILE UNDER STONE FILL
BEGIN STONE FILL TYPE IV
BEGIN GRUBBING MATERIAL

30+485.2 LT
BEGIN STONE FILL TYPE II

0 5 10
GRAPHIC SCALE 1:100

PROJECT NAME: STOCKBRIDGE	
PROJECT NUMBER: BRF 022-1(20)	
FILE NAME: /sr+5/85e039/de039xsl.dgn	PLOT DATE: 08-APR-2010
PROJECT LEADER: C.P.Williams	DRAWN BY: G. Shangraw
DESIGNED BY: G. Shangraw	CHECKED BY: R.S. Young
CHANNEL CROSS SECTIONS 4	SHEET 134 OF 139