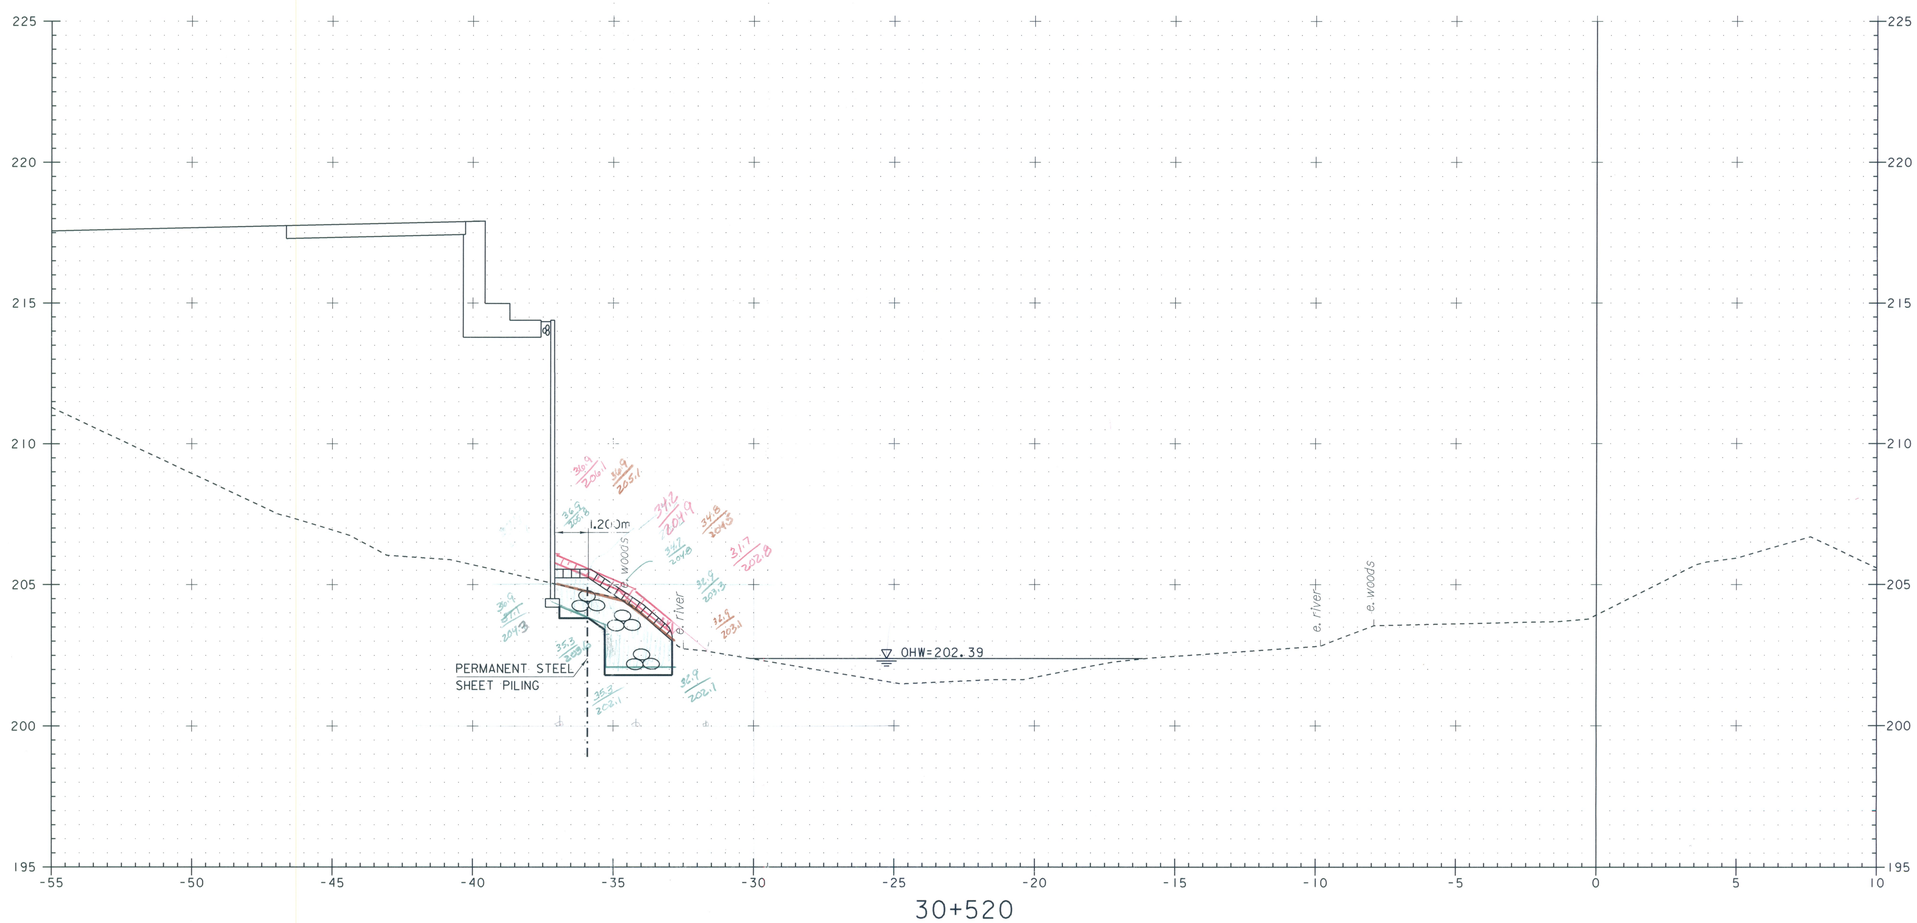

0 5 10

GRAPHIC SCALE 1:100

PROJECT NAME: STOCKBRIDGE	
PROJECT NUMBER: BRF 022-1(20)	
FILE NAME: /sr+5/85e039/de039xsl.dgn	PLOT DATE: 08-APR-2010
PROJECT LEADER: C.P. Williams	DRAWN BY: G. Shangraw
DESIGNED BY: G. Shangraw	CHECKED BY: R.S. Young
CHANNEL CROSS SECTIONS 7	SHEET 137 OF 139