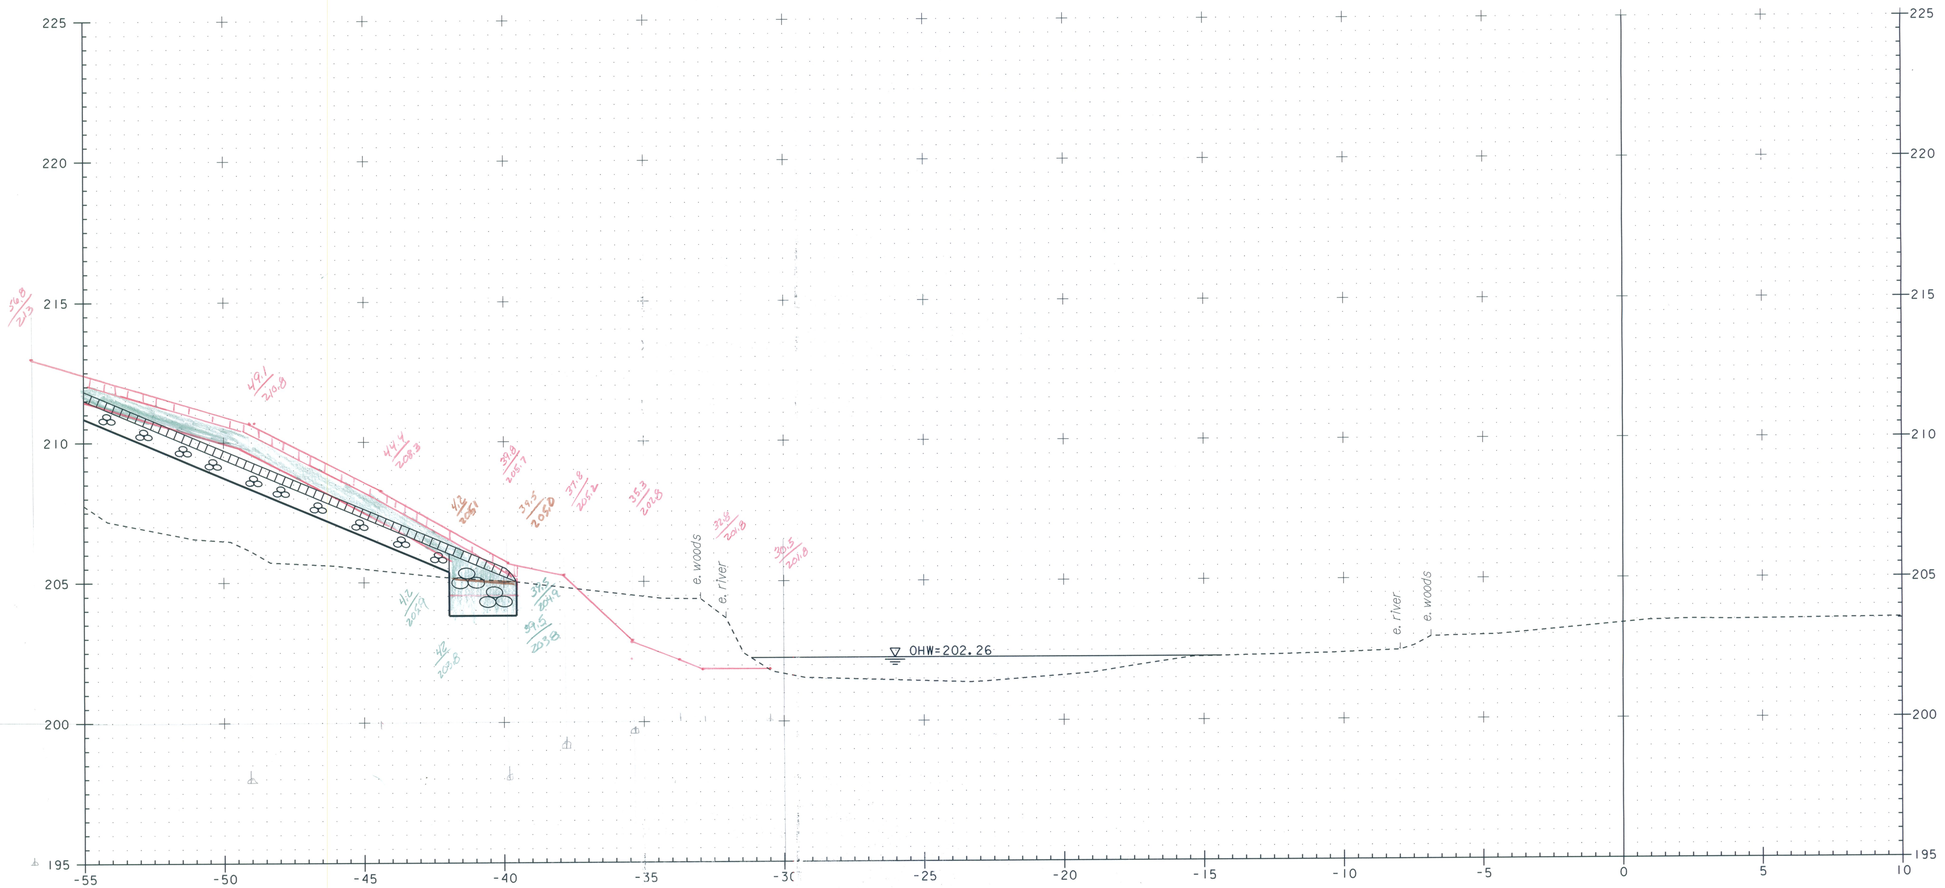

30+540

30+547.5 LT
END UNCLASSIFIED CHANNEL EXCAVATION
END GEOTEXTILE UNDER STONE FILL
END STONE FILL TYPE II
END GRUBBING MATERIAL

30+547.0 LT
END STONE FILL TYPE IV

0 5 10
GRAPHIC SCALE 1:100

PROJECT NAME: STOCKBRIDGE
PROJECT NUMBER: BRF 022-1(20)

FILE NAME: /sr15/85e039/de039xsl.dgn
PROJECT LEADER: C.P. Williams
DESIGNED BY: G. Shangraw
CHANNEL CROSS SECTIONS 9

PLOT DATE: 08-APR-2010
DRAWN BY: G. Shangraw
CHECKED BY: R.S. Young
SHEET 139 OF 139