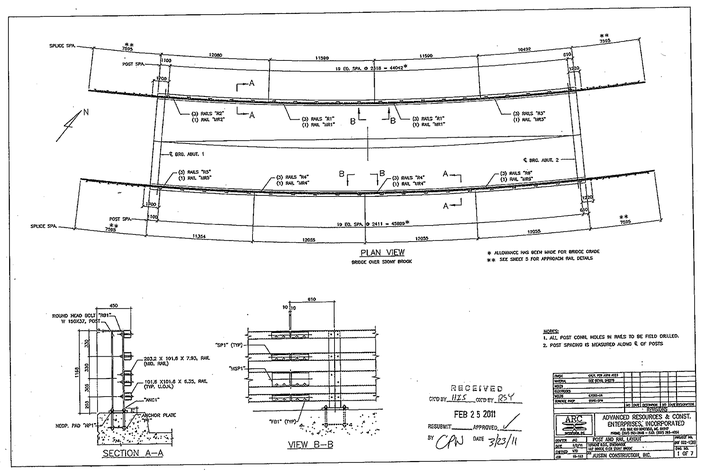

RECEIVED
CTD BY HLS CTD BY DSY
FEB 25 2011
REQUIREMENT APPROVED
BY CAN DATE 3/23/11

NOTES:
1. ALL POST COVRE HOLES IN RAILS TO BE FIELD DRILLED.
2. POST SPACING IS MEASURED ALONG ℄ OF POSTS

DESIGN	CCS, YGI, CFS, HST					
DRAWN	DB,BDN,SBDB					
CHECKED						
APPROVED						
DATE	2/2/11					
SCALE	AS SHOWN					
CONTRL PROF	2010-SPA					
		NO. DATE	REVISIONS AND DESCRIPTION REVISIONS			

ARC
ADVANCED RESOURCES & CONST. ENTERPRISES, INCORPORATED
P.O. BOX 420 CENTRAL, NY 12195
PHONE: (518) 477-7400 FAX: (518) 765-4202

CONTRACT	1 POST AND RAIL CATALOG		CONTRACT NO.
DATE	2/11/11	GROUP CAT. DRAWING	AP 152-C20
DESIGN	YGI	1B RAILS FOR STONY BROOK	SHT. NO.
DRAWN	DB,BDN,SBDB	3B RAILS FOR STONY BROOK	1 OF 7
JOB	09-022	AUSTIN CONSTRUCTION, INC.	