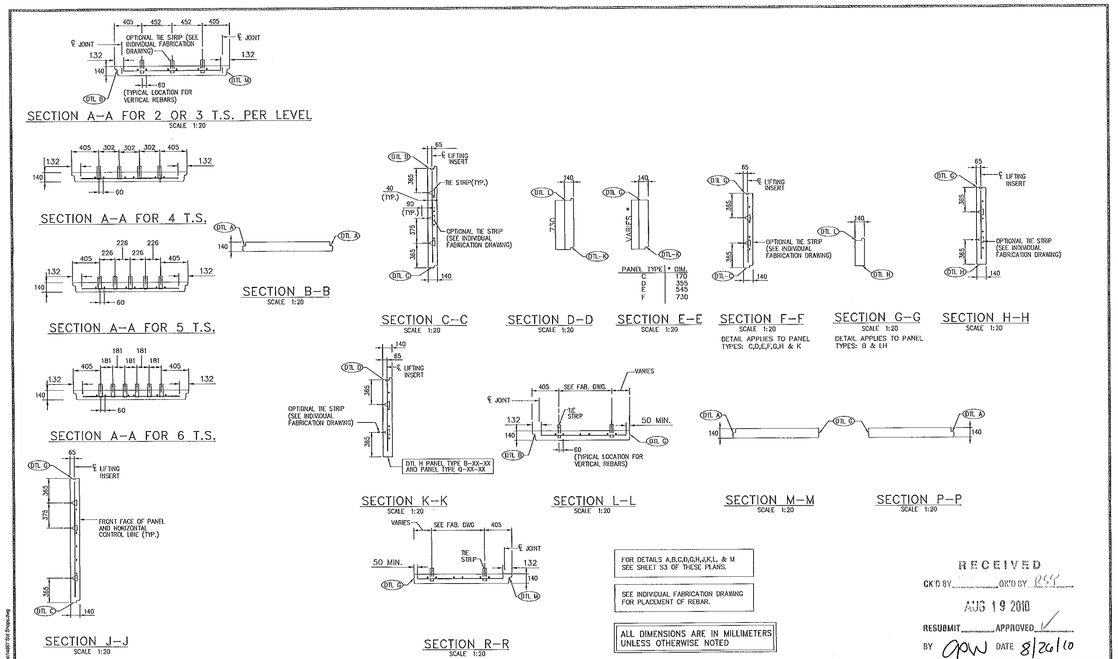

FOR DETAILS A,B,C,D,G,H,J,K,L, & M SEE SHEET S3 OF THESE PLANS.

SEE INDIVIDUAL FABRICATION DRAWING FOR PLACEMENT OF REBAR.

ALL DIMENSIONS ARE IN MILLIMETERS UNLESS OTHERWISE NOTED

RECEIVED
CK'D BY _____ OK'D BY RSF
AUG 19 2010
RESUBMIT _____ APPROVED ✓
BY GPW DATE 8/26/10

This drawing contains information proprietary to The Reinforced Earth Company, and is being furnished for the use of VERMONT AGENCY OF TRANSPORTATION only in connection with this project, and the information contained is not to be transmitted to any other organization unless specifically authorized in writing by The Reinforced Earth Company. The Reinforced Earth Company is exclusive licensee in the United States under patents issued to Henri Vidal, and the furnishing of this drawing does not constitute an expressed or implied license under the Vidal patents.

The design contained on these drawings is based on information provided by the owner. On the basis of this information, The Reinforced Earth Company has designed, and is responsible for the internal stability of the structure only. External stability, including foundation (bearing capacity and settlement) and slope stability (sliding and rotation), is the responsibility of the owner.

REINFORCED EARTH
11864 Sunset Circle Drive, Vienna, VA 22182 (703)573-1110

"REINFORCED EARTH" is the registered trademark of The Reinforced Earth Company.

DESIGNED BY: LY	REV.	DATE	DESCRIPTION
PROJECT ENGR: LY			
CHECKED BY: PLA			

PROJECT NAME	VT ROUTE 107, BRIDGE 9	DATE	07/16/2010
LOCATION	STOCKBRIDGE, VERMONT	CONTRACT NO.	RE-14697
OWNER	VERMONT AGENCY OF TRANSPORTATION	DRAWING NO.	S2 OF S10
DRAWING COVERS	PANEL SECTIONS	SCALE	AS SHOWN

R:\RE14697_BRIDGE\VT_Bridge\general\14697 S2 Panel.dwg