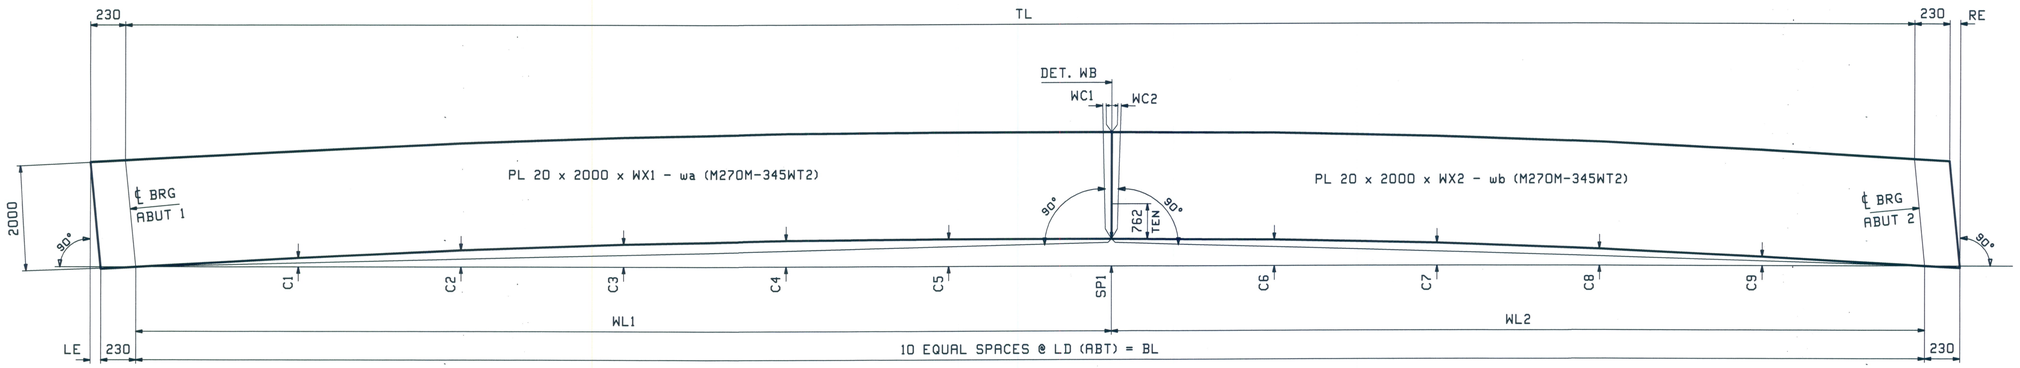

CAMBER DIAGRAM FOR 1G1 THRU 5G5

MARK	TL	BL	LE	RE	WL1	WL2	WX1	WX2	SP1	WC1	WC2	LD	C1	C2	C3	C4	C5	C6	C7	C8	C9	PG/LINE	PG/LINE
1G1	44 245	44 218	100	73	25 374	18 844	25 704	19 089	137	11	15	4422	47	87	117	136	142	136	117	87	47	2/ C	2/ N
2G2	44 652	44 621	101	70	25 374	19 247	25 705	19 494	154	12	16	4462	52	97	131	152	159	152	131	97	52	2/ A	2/ L
3G3	45 060	45 024	103	67	25 374	19 650	25 708	19 898	170	13	17	4502	58	107	144	167	175	167	144	107	58	2/ A	2/ J
4G4	45 466	45 424	105	63	25 374	20 050	25 710	20 299	186	15	19	4542	64	117	157	182	191	182	157	117	64	2/ A	2/ G
5G5	45 872	45 825	107	60	25 374	20 451	25 712	20 702	203	16	20	4583	69	127	171	198	208	198	171	127	69	2/ A	2/ E

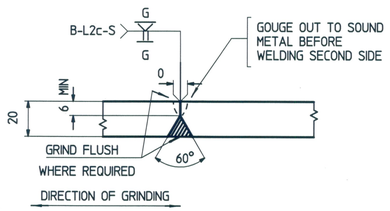

WEB PLATE SPLICE DETAIL "WB"

RECEIVED
CK'D BY HJF ORIG BY RSY
SEP 02 2010
RESUBMIT ____ APPROVED ✓
BY OPW DATE 9/29/10

FOR GENERAL NOTES SEE SHEET GN1

REV.	DATE	REMARKS	DWN	CHK	APVL	SHOP
0					AUG 30 2010	

MATERIAL:	SURFACE PREP. & PAINT:	HOLES:	SHOP BOLTS:
M270M-345WT2	SEE SHT GN1		

DESCRIPTION: CAMBER DIAGRAMS

CASCO BAY STEEL STRUCTURES, INC.
75 SPRING HILL ROAD SACO, MAINE 04072
PHONE (207) 282-7360 FAX. (207) 282-1179

TENSOR 3012

STRUCTURE: VT RTE 107 over STONEY BROOK BRIDGE 9 STOCKBRIDGE, VT COUNTY of WINDSOR		DRAWN: TG	DATE: 08/04
		CHK'D: SF	DATE: 08/23/10
LOCATION: STOCKBRIDGE, VT		JOB NO.	DWG NO.
PROJ NO. BRF 022-1(20)		461	C1
CUSTOMER: AUSTIN CONSTRUCTION			REV. △

Wed, Aug 25, 2010 08:59:51 AM //users/jobs/2010/21 Rev0