ABM INFO		SHIP	BILL OF MATERIAL					JOB NO.	DRAWING NO.	REV.
								461	1	
PAGE	LINE	MARK	QTY	MARK	MATERIAL	LENGTH m	LENGTH mm	REMARKS	WT	PROCUREMENT NOTES
		1G1	1		GIRDER				24355 kg 53693 lbs	
2	C		1	wa	PL 20x2000	25	704	M270M-345WT2		
2	N		1	wb	PL 20x2000	19	089	M270M-345WT2		
1	Q		1	ta	PL 30x450	19	101	M270M-345WT2		
1	J		1	tb	PL 30x450	25	604	M270M-345WT2		
1	Q		1	ba	PL 30x450	19	075	M270M-345WT2		
1	J		1	bb	PL 30x450	25	603	M270M-345WT2		
4	B		2	x1b	PL 30x200	2	003	M270M-345WT2		
4	B		2	x1d	PL 30x200	2	003	M270M-345WT2		
4	C		7	x1f	PL 20x200	2	000	M270M-345WT2		
4	D		1	x1h	PL 6x80	0	301			

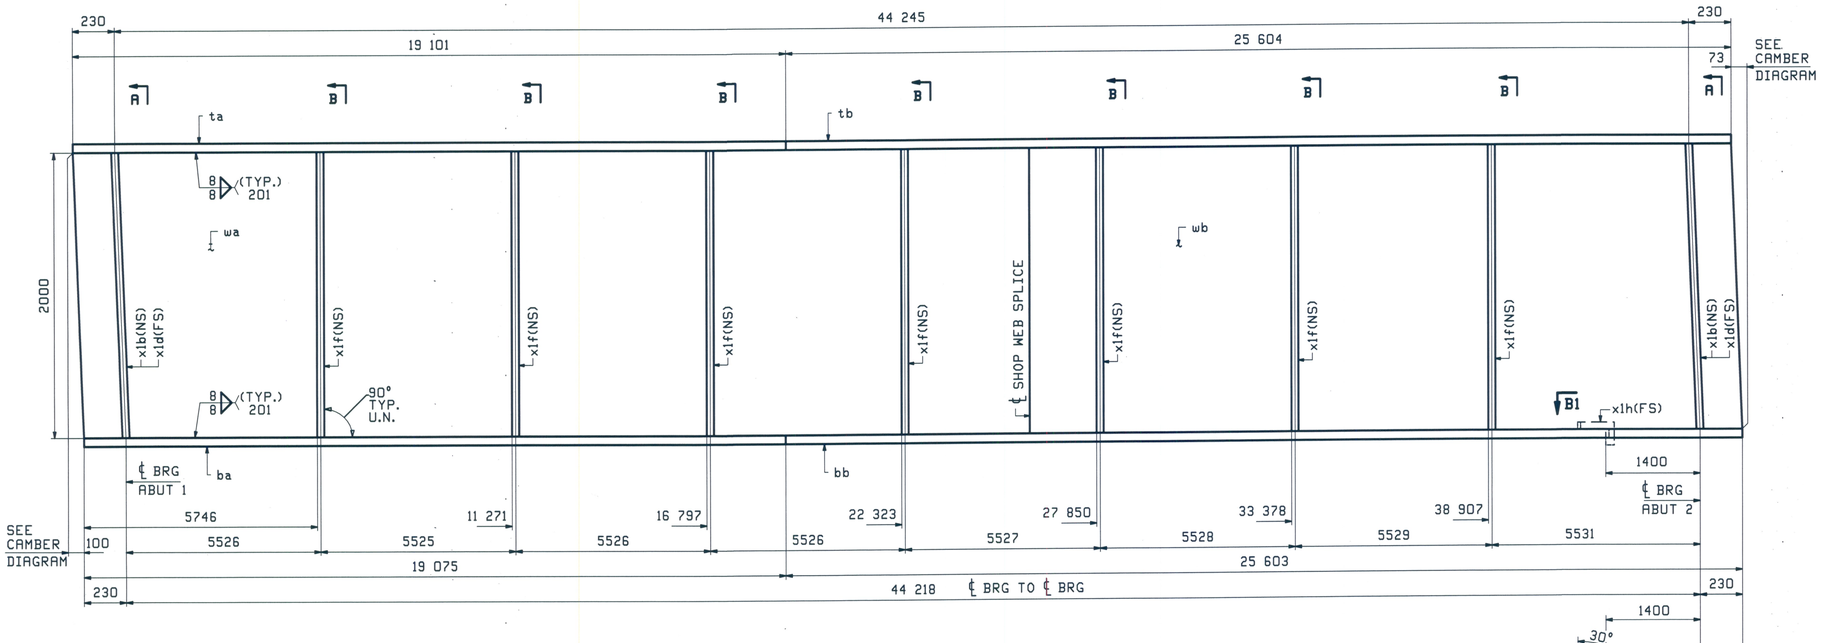

ONE - GIRDER - 1G1 (DEV)

SEE DRAWING GN1 FOR GENERAL NOTES
SEE DRAWING F1 FOR FLANGE DIAGRAM
SEE DRAWING C1 FOR CAMBER DIAGRAM
SEE X1 DRAWING FOR GIRDER STANDARDS

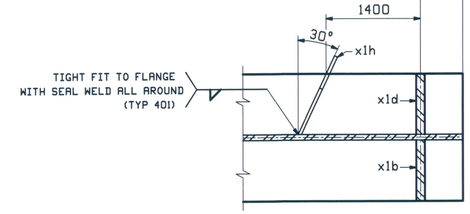

SECTION-B1

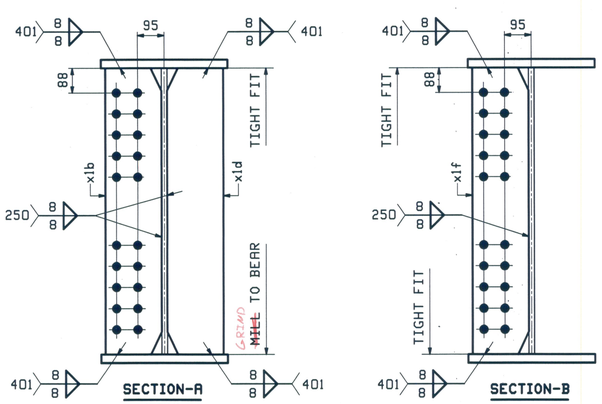

SECTION-A (DEV)

SECTION-B

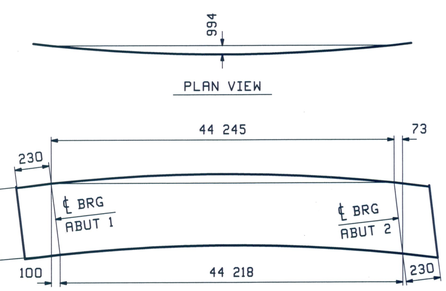

DEV. ORIENTATION DIAGRAM

REV.	DATE	REMARKS	DWN	CHK	APVL	SHOP
0					AUG 30 2010	

MATERIAL: (U.N.)	SURFACE PREP. & PAINT:	HOLES:	SHOP BOLTS:
M270M-345W	SEE SHT GN1	24 mm	

DESCRIPTION: GIRDER 1G1

CASCO BAY STEEL STRUCTURES, INC.
75 SPRING HILL ROAD SACO, MAINE 04072
PHONE (207) 282-7360 FAX. (207) 282-1179
TENSOR 3012

STRUCTURE: VT RTE 107 over STONEY BROOK BRIDGE 9 STOCKBRIDGE, VT COUNTY of WINDSOR	DRAWN: TG	DATE: 08/09	
	CHKD: SF	DATE: 08/23/10	
LOCATION: STOCKBRIDGE, VT	JOB NO. 461	DWG NO. 1	
PROJ NO. BRF 022-1(20)		REV. △	
CUSTOMER: AUSTIN CONSTRUCTION			

RECEIVED
CK'D BY HIV DATE RSY
SEP 02 2010
RESUBMIT ____ APPROVED As Noted
BY CPW DATE 9/29/10

Wed, Aug 25, 2010 08:55:56 AM /users/jobs/3012/1.Rev0