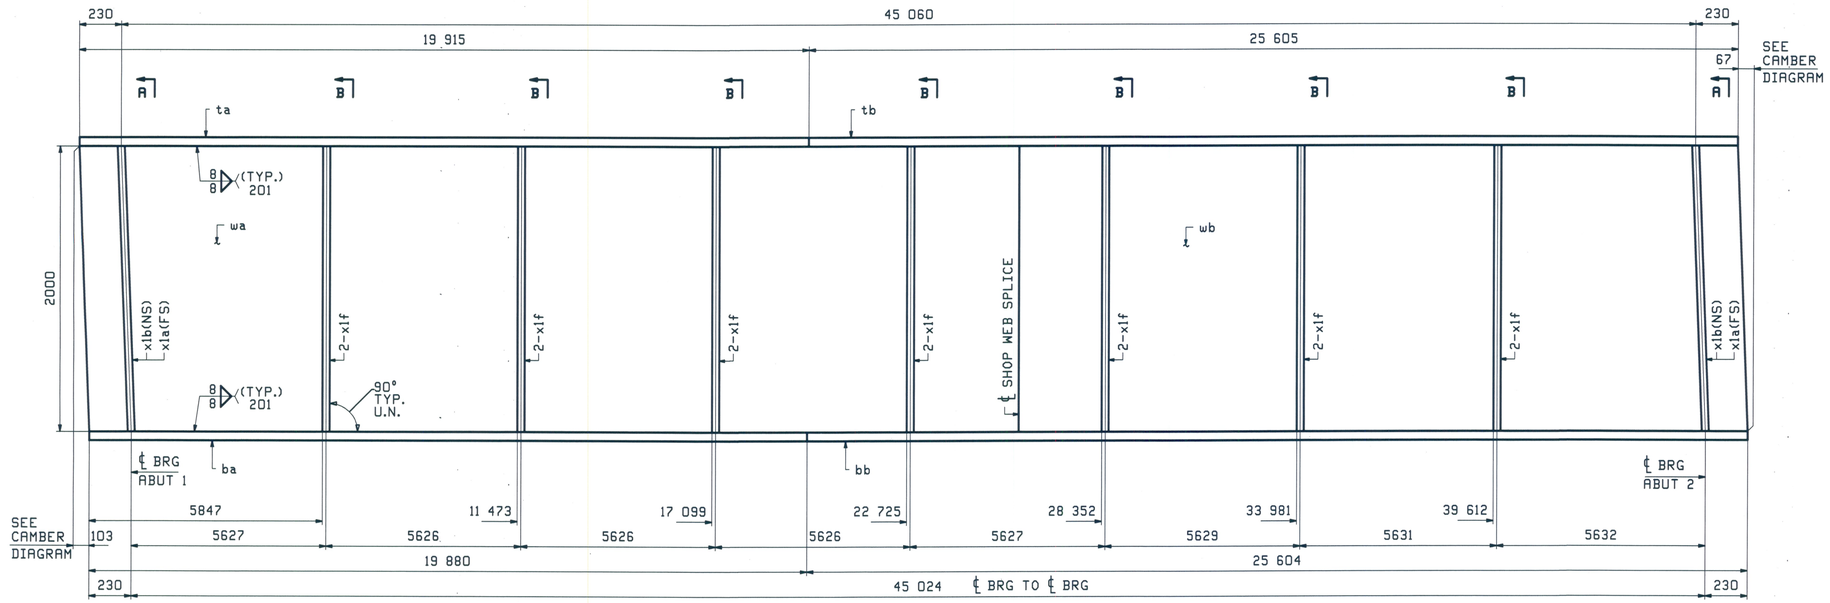

ONE - GIRDER - 3G3 (DEV)

SEE DRAWING GN1 FOR GENERAL NOTES
SEE DRAWING F1 FOR FLANGE DIAGRAM
SEE DRAWING C1 FOR CAMBER DIAGRAM
SEE X1 DRAWING FOR GIRDER STANDARDS

ABM INFO		SHIP	BILL OF MATERIAL					JOB NO. 461	DRAWING NO. 3	REV.
PAGE	LINE	MARK	QTY	MARK	MATERIAL	LENGTH m	LENGTH mm	REMARKS	WT	PROCUREMENT NOTES
		3G3	1		GIRDER				25221 kg 55602 lbs	
2	A		1	wa	PL 20x2000	25	708	M270M-345WT2		
2	J		1	wb	PL 20x2000	19	898	M270M-345WT2		
1	L		1	ta	PL 30x450	19	915	M270M-345WT2		
1	J		1	tb	PL 30x450	25	605	M270M-345WT2		
1	L		1	ba	PL 30x450	19	880	M270M-345WT2		
1	J		1	bb	PL 30x450	25	604	M270M-345WT2		
4	B		2	x1a	PL 30x200	2	003	M270M-345WT2		
4	B		2	x1b	PL 30x200	2	003	M270M-345WT2		
4	C		14	x1f	PL 20x200	2	000	M270M-345WT2		

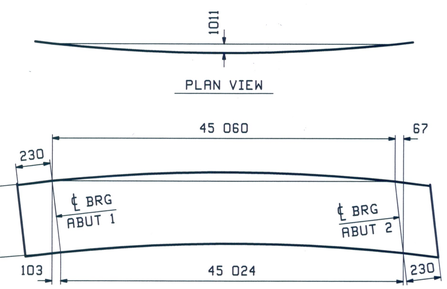

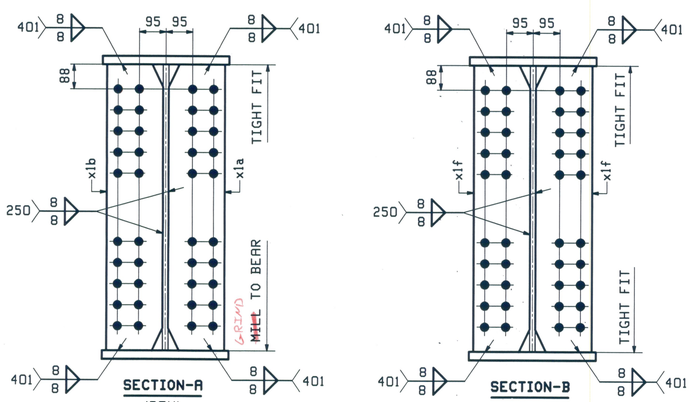

REV.	DATE	REMARKS	DWN	CHK	APVL	SHOP
0					AUG 30 2010	

MATERIAL:	SURFACE PREP. & PAINT:	HOLES:	SHOP BOLTS:
M270M-345WT2	SEE SHT GN1	24mm	

DESCRIPTION: GIRDER 3G3

CASCO BAY STEEL STRUCTURES, INC.
75 SPRING HILL ROAD SACO, MAINE 04072
PHONE (207) 282-7360 FAX. (207) 282-1179
TENSOR 3012

STRUCTURE:	VT RTE 107 over STONEY BROOK BRIDGE 9 STOCKBRIDGE, VT COUNTY of WINDSOR	DRAWN: TG	DATE: 08/10
		CHKD: SF	DATE: 08/23/10
LOCATION:	STOCKBRIDGE, VT	JOB NO.	DWG NO.
PROJ NO.	BRF 022-1(20)	461	3
CUSTOMER:	AUSTIN CONSTRUCTION		REV. △

RECEIVED
CK'D BY HJC ORDER R54
SEP 02 2010
RESUBMIT ____ APPROVED As Noted
BY GPW DATE 9/29/10

508 Wed, Aug 25, 2010 08:55:59 AM /users/jobs/2012-2 : Rev0