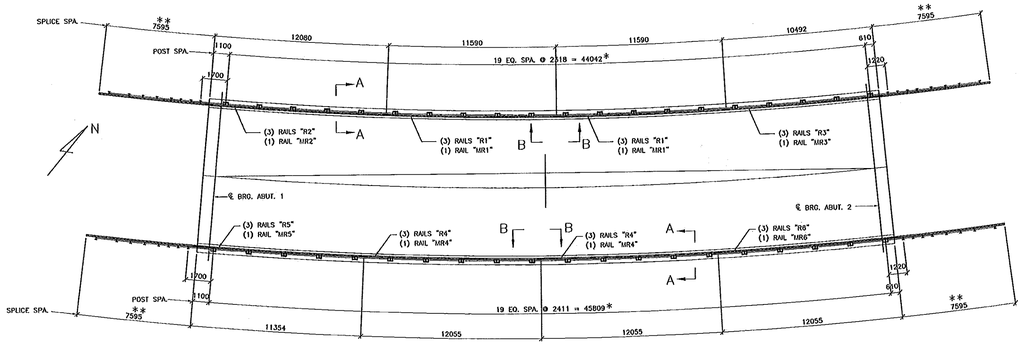

PLAN VIEW

BRIDGE OVER STONY BROOK

* ALLOWANCE HAS BEEN MADE FOR BRIDGE GRADE

** SEE SHEET 5 FOR APPROACH RAIL DETAILS

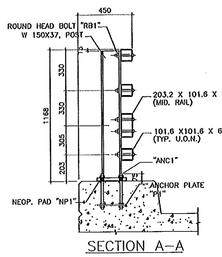

SECTION A–A

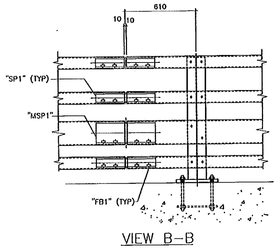

VIEW B–B

Structures Copy

RECEIVED
CK'D BY HTS CK'D BY RSY
FEB 25 2011
RESUBMIT ____ APPROVED ✓
BY CPN DATE 3/23/11

NOTES:
1. ALL POST CONN. HOLES IN RAILS TO BE FIELD DRILLED.
2. POST SPACING IS MEASURED ALONG ℄ OF POSTS

FINISH	GALV. PER ASTM A123
MARKING	SEE DETAIL SHEETS
NOTES	
ELECTRODES	
WELDS	E70XX-LH
SURFACE PREP	SSPC-SP6

NO.	DATE	DESCRIPTION	NO.	DATE	DESCRIPTION
REVISIONS					

ARC
ADVANCED RESOURCES & CONST. ENTERPRISES, INCORPORATED
P.O. BOX 130 WINDSOR, ME. 04363
PHONE: (207) 445-2616 • FAX: (207) 445-4954

DRAWN	JAC
DATE	1/1/11
CHECKED	WD
JOB	10-183

POST AND RAIL LAYOUT
WINDSOR EAST, WINDSOR/KX
1ST BRIDGE OVER STONY BROOK
AUSTIN CONSTRUCTION, INC.

PROJECT NO. BRF 002-1(90)
DWG. NO. 1 OF 7