SEE SHEET 2 FOR INDEX OF SHEETS
AND LIST OF STANDARDS.

STATE OF VERMONT
AGENCY OF TRANSPORTATION

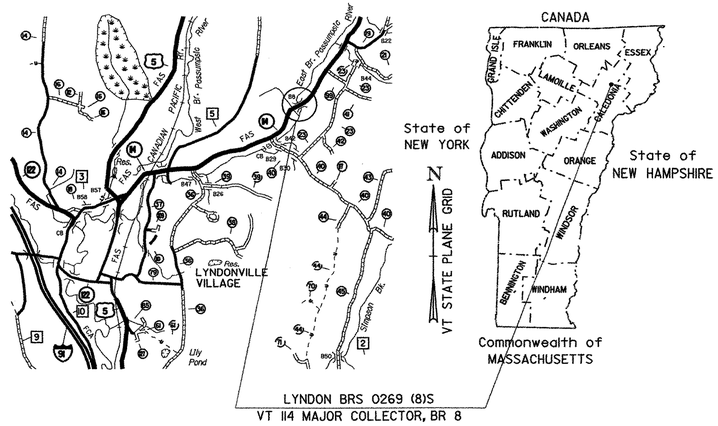

PROPOSED IMPROVEMENT
BRIDGE PROJECT
TOWN OF LYNDON
COUNTY OF CALEDONIA

ROUTE NO : VT 114 MAJOR COLLECTOR BRIDGE NO : 8

PROJECT LOCATION : BEGINNING AT A POINT APPROXIMATELY 3.505 KILOMETERS NORTHEASTERLY FROM THE INTERSECTION OF US 5 AND VT 114 AND EXTENDING NORTHEASTERLY 0.120 KILOMETERS ALONG VT 114.

PROJECT DESCRIPTION : REPLACEMENT OF THE EXISTING BRIDGE INCLUDING RELATED APPROACH ROADWAY AND CHANNEL WORK.

LENGTH OF STRUCTURE :	28.838 METERS.
LENGTH OF ROADWAY :	91.162 METERS.
LENGTH OF PROJECT :	120.000 METERS.

RECORD PLANS

CONTRACTOR: WINTERSET, INC. – LYNDONVILLE, VT.

RESIDENT ENGINEER: KEVIN McCLURE

CONSTRUCTION BEGAN: FEBRUARY 24, 2006

CONSTRUCTION COMPLETE: NOVEMBER 08, 2006

RECORD PLANS BY: CHRIS JOLLY, KEVIN McCLURE, CHIP PIERCE

I HEREBY CERTIFY THAT ALL THE CONSTUCTION REQUIRED BY THIS SET OF DRAWINGS HAS BEEN ACCOMPLISHED AS INDICATED HEREIN.

BY Kevin McClure RESIDENT ENGINEER

DATE 3-20-08

NOTE: Any further information concerning final quantities, amounts or other details relative to this project may be found at Central Files in the electronic archives.

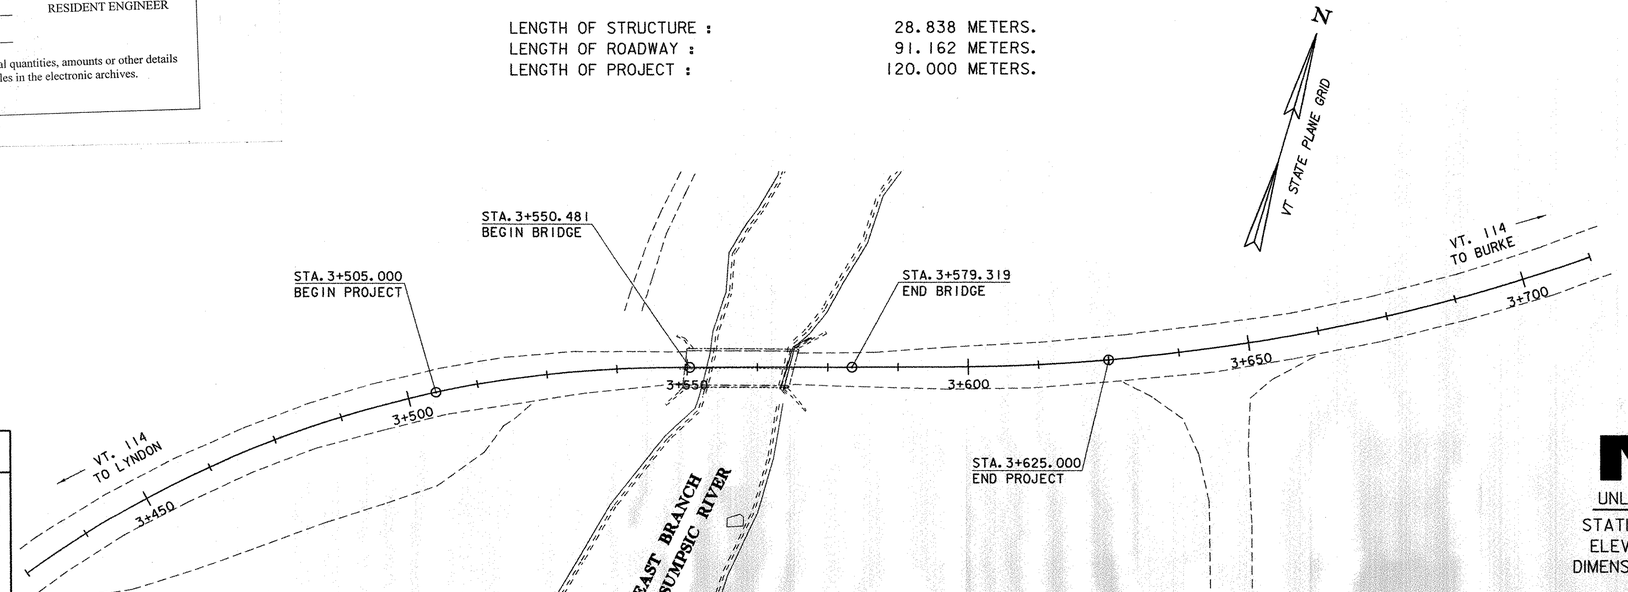

0 10 20 30
SCALE = 1:500

CONVENTIONAL SYMBOLS

COUNTY LINE
TOWN LINE
LIMITS OF ACCESS
POINT OF ACCESS
FENCE LINE
STONE WALL
TRAVELED WAY
GUARD RAIL
RAILROAD
SURVEY LINE
CULVERT
POWER POLE
TELEPHONE POLE
TREES
CONTROL OF ACCESS
PROPERTY LINE
R.O.W. TAKING LINE
SLOPE RIGHTS SR SR SR
TOP OF CUT
TOE OF SLOPE

SURVEYED BY : R. MOREAU
SURVEYED DATE : 01-31-1993

DATUM
VERTICAL NAVD 88
HORIZONTAL NAD 83 (92)

VAOT Metric

UNLESS NOTED OTHERWISE
STATIONS ARE IN KILOMETERS
ELEVATIONS ARE IN METERS
DIMENSIONS ARE IN MILLIMETERS

THESE PLANS ARE SUBJECT TO SUCH ENGINEERING CHANGES AS MAY BE REQUIRED BY THE FEDERAL HIGHWAY ADMINISTRATION OR THE DIRECTOR OF PROGRAM DEVELOPMENT.

CONSTRUCTION IS TO BE CARRIED ON IN ACCORDANCE WITH THESE PLANS AND THE STANDARD SPECIFICATIONS FOR CONSTRUCTION DATED 2001, AS APPROVED BY THE FEDERAL HIGHWAY ADMINISTRATION ON JANUARY 4, 2001 FOR USE ON THIS PROJECT, INCLUDING ALL SUBSEQUENT REVISIONS AND SUCH REVISED SPECIFICATIONS AND SPECIAL PROVISIONS AS ARE INCORPORATED IN THESE PLANS.

85e041\Structures\se041bdr.dgn se041111.1

DIRECTOR OF PROGRAM DEVELOPMENT
APPROVED [signature] DATE 06-05

PROJECT MANAGER : ROGER R. WHITCOMB

PROJECT NAME : LYNDON
PROJECT NUMBER : BRS 0269 (8)S

SHEET 1 OF 68 SHEETS