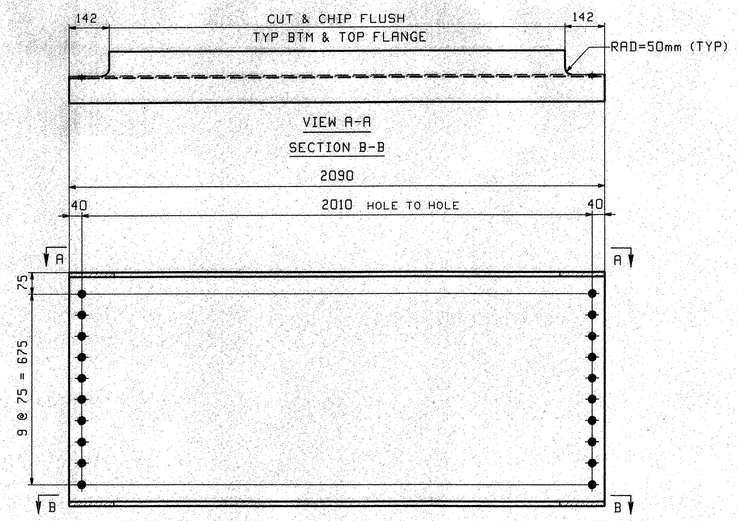

20 ~ INT. DIAPHRAGMS - 6D1

LOOKING UP-STATION

ABM INFO		SHIP	BILL OF MATERIAL						JOB NO.	DRAWING NO.	REV.
									293	6	
PAGE	LINE	MARK	QTY	MARK	MATERIAL	LENGTH m	LENGTH mm	REMARKS	WT	PROCUREMENT NOTES	
					DIAPHRAGMS						
2	K	6D3	20		W 840x176	2	090		368 kg 811 lbs		

OUT FOR APPROVAL	3-7-06									
OUT FOR APPROVAL										
ISSUED TO SHOP										
FIELD & OFFICE										
REV.	REMARKS	DATE	DWN	CHK	APP	Q.A.	NO.	DIA.	LGT	TYPE	WASHER

MATERIAL:	ELECTRODES:	HOLES:	SHOP BOLTS:
M270M GR 345W		15/16 Ø	NONE

SURFACE PREP. & PAINT:

SEE DRAWING GN1

DESCRIPTION:	DIAPHRAGMS	DRAWN BY	DATE
JOB:	VT 114 OVER THE EAST BRANCH OF THE PASSUMPSIC RIVER BRIDGE NO. 8 LYNDON, VT. COUNTY OF CALEDONIA	JTB	02/16
		CHKD BY	
		PCP	03/02
TENSOR 2625		APPROV BY	
		SUPERVISOR	W. J. GATTI
PROJ NO.	BRS 0269 (B)S	Q.A.	
CUSTOMER:	WINTERSET, INC.		

CASCO BAY STEEL STRUCTURES, INC.
75 SPRING HILL ROAD SACO, MAINE 04072
PHONE (207) 282-7360 FAX. (207) 282-1179

JOB NO.	DRG. NO.
293	6
	REV. △

RECEIVED
CK'D BY CWC CK'D BY JWP
MAR 13 2006
RESUBMIT ____ APPROVED ✓
BY CWC DATE 4-11-06

090-55

PCP Fri Mar 3 09:09:18 EST 2006 /users/jobs/293/6/Rev0