Metric

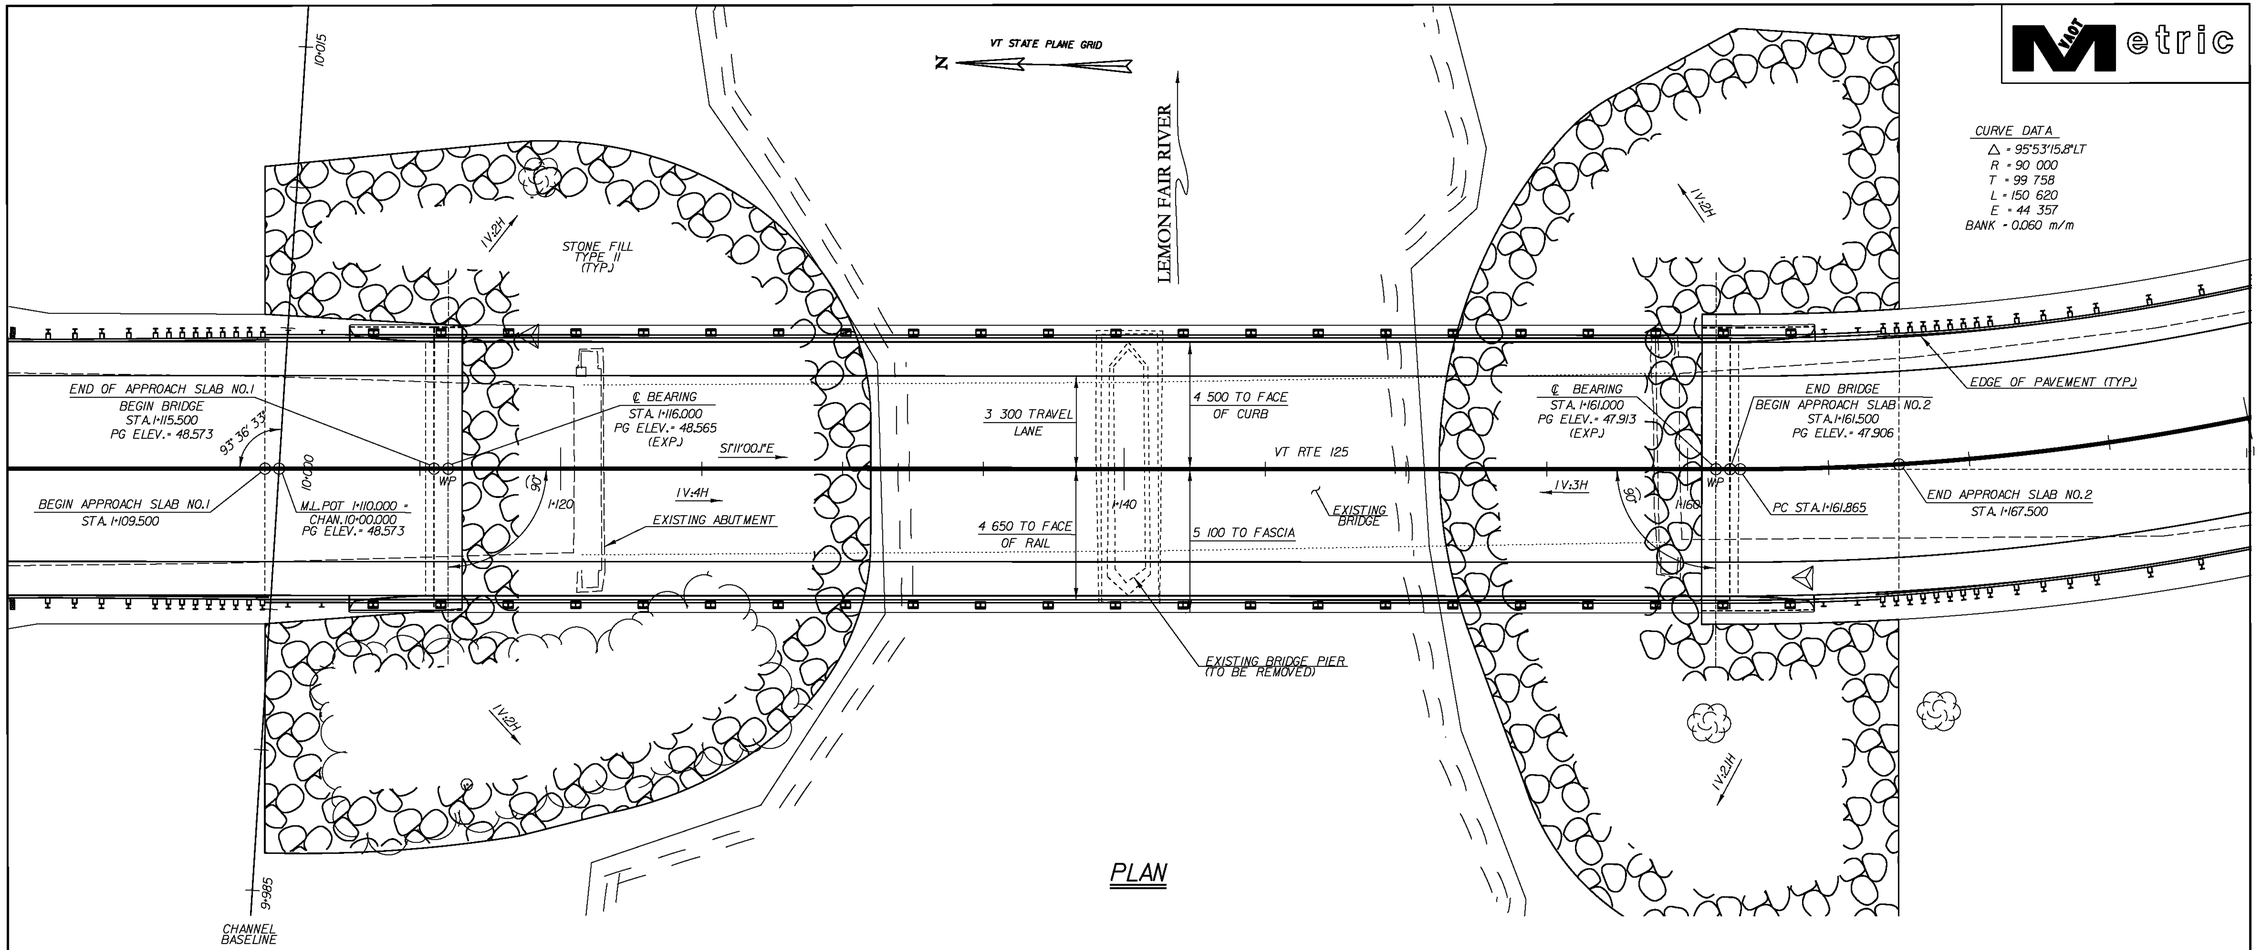

PLAN

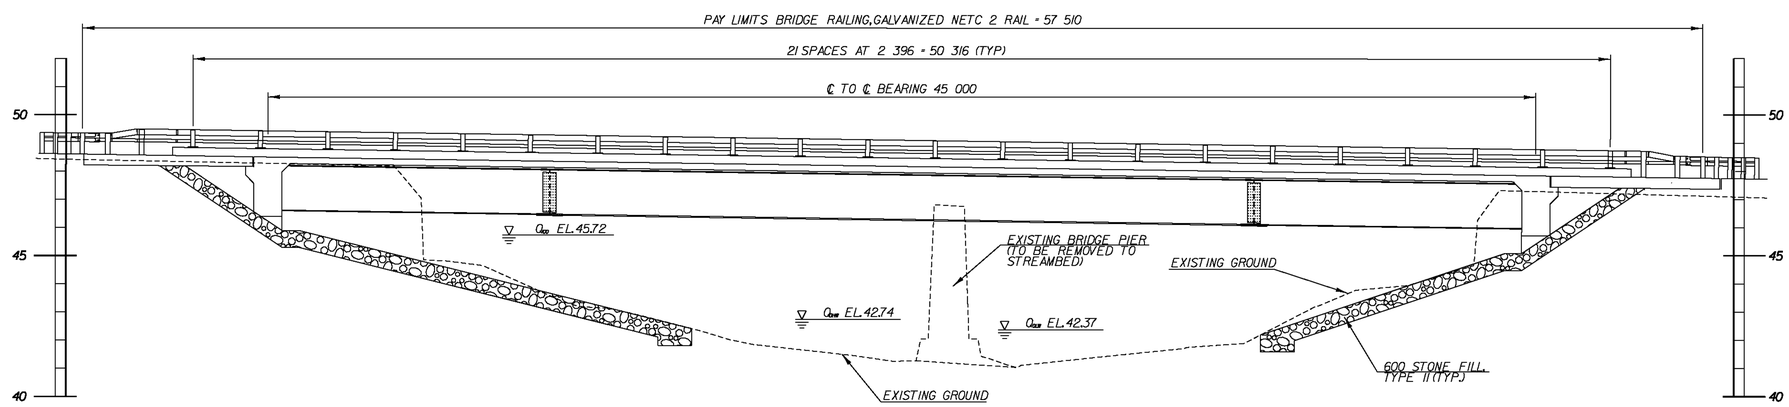

ELEVATION

0 2 4 6 8 10
SCALE 1:100

PROJECT NAME:	CORNWALL
PROJECT NUMBER:	BRS 0172(6)

FILE NAME: z85e042brdbdr.dgn	PLOT DATE: 2/12/2010
PROJECT LEADER: MARTHA EVANS-MONGEON	DRAWN BY: VK
DESIGNED BY: M. CRUZ	CHECKED BY: M. CRUZ
PLAN AND ELEVATION	SHEET 92 OF 144

DATUM

VERTICAL	NAVD88
HORIZONTAL	NAD83(92)