Metric

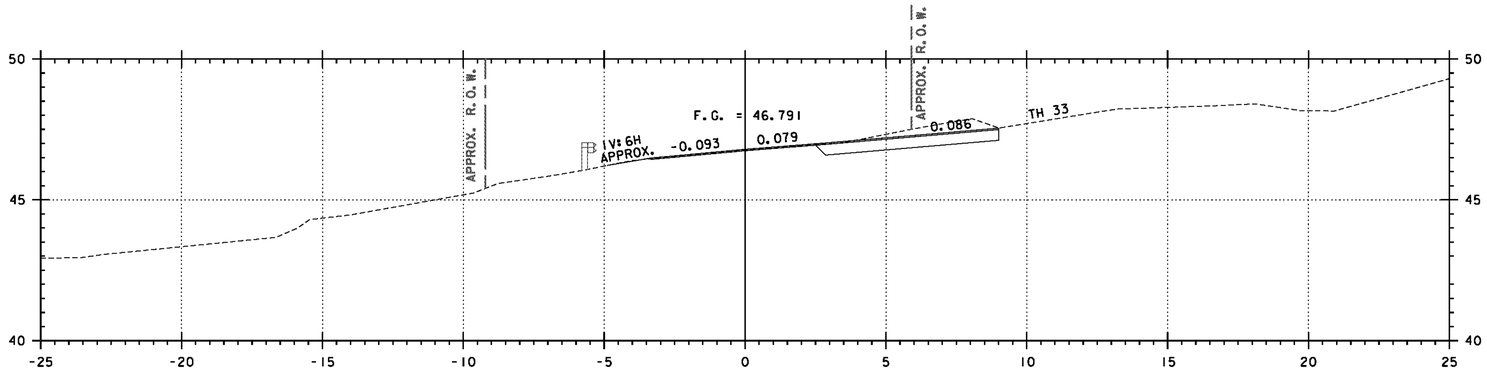

3+250.00
END DETOUR
BEGIN APPROACH

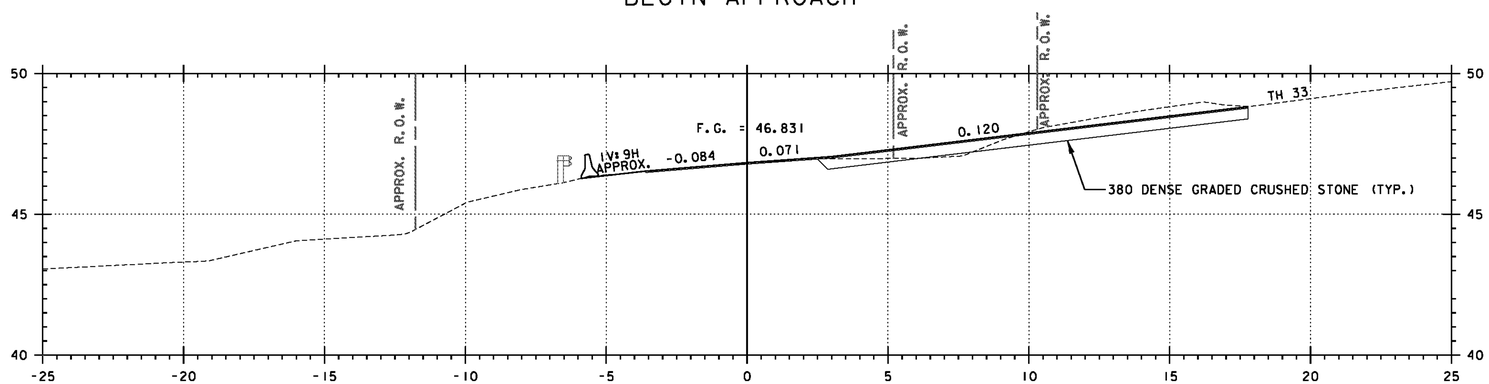

PT 3+242.204

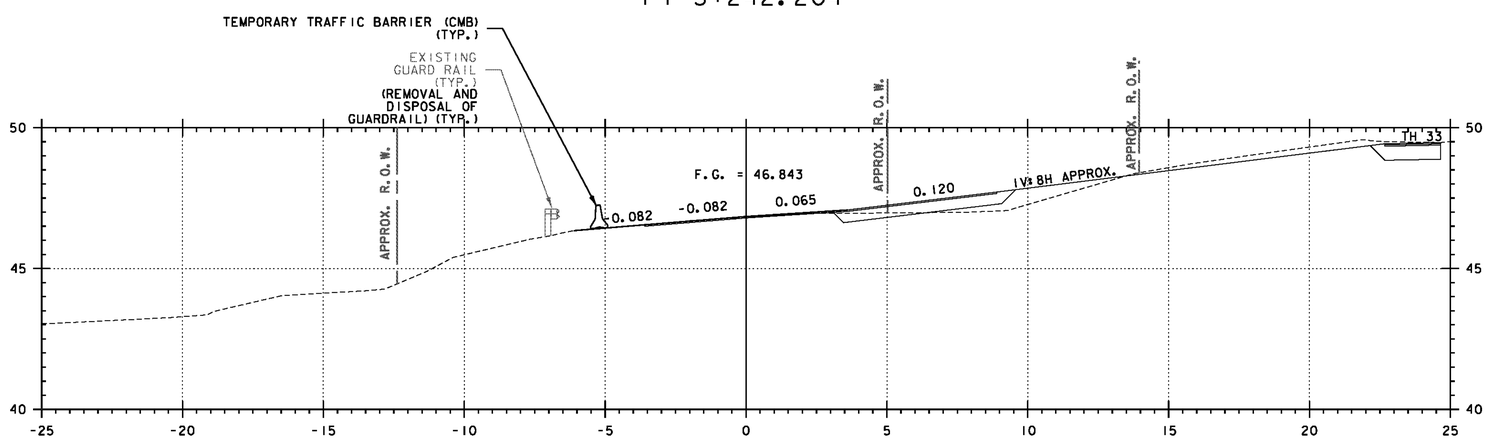

3+240

0 1 2 4 6 8 10
SCALE = 1:100

DATUM	
VERTICAL	NAVD 88
HORIZONTAL	NAD 83(92)

Temporary Detour

STA. 3+240 TO STA. 3+250

PROJECT: CORNWALL	PROJECT NO.: BRS 0172(6)
DESIGN FILE NAME: z85e042xs5.dgn	
IPARM FILE NAME:	PLOT DATE: 2/5/2010
SURVEYED BY: VTRANS & VT SURVEY	SURVEY DATE: 1996&1999
SQUAD LEADER: MARTHA EVANS-MONGEON	DRAWN BY: ERIK ATKINS
TEMPORARY DETOUR CROSS SECTION SHEET 7	SHEET: 141 OF 144