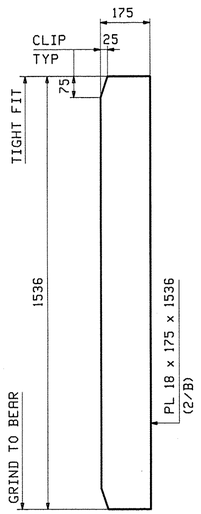

4 ~ x1a

BRG STIFF
FASCIA SIDE

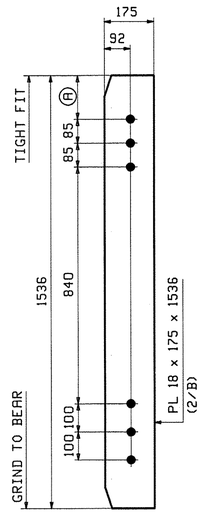

MARK "A"

BRG STIFF

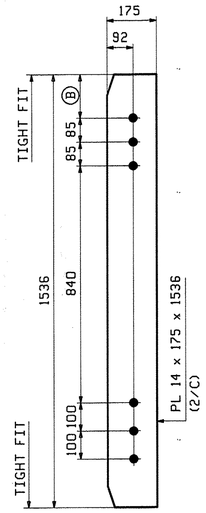

MARK "B"

INT CF CONN

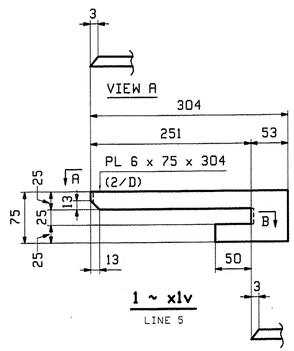

1 ~ x1v

LINE 5

SECTION B

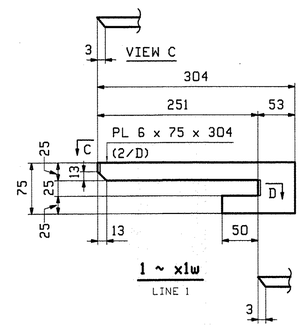

1 ~ x1w

LINE 1

SECTION D

MARK "A"	QTY	Ⓐ	
x1b	8	95	LOW END
x1c	4	151	DROP = 56
x1d	4	229	DROPS = 133, 134

MARK "B"	QTY	Ⓑ	
x1f	24	95	LOW END
x1g	4	159	DROP = 64
x1k	4	171	DROP = 76
x1m	4	183	DROPS = 88, 89
x1n	4	196	DROP = 101
x1p	4	209	DROPS = 113, 114
x1t	4	220	DROPS = 125, 126

NOTES:
FOR GENERAL NOTES SEE DRAWING GN1.

REV.	DATE	REMARKS	DWN	CHK	APVL	SHOP
0					6/18/10	

MATERIAL:	SURFACE PREP. & PAINT:	HOLES:	SHOP BOLTS:
M270M-345W	SEE DWG GN1	15/16"ø	NONE

DESCRIPTION: GIRDER STANDARD DETAILS

CASCO BAY STEEL STRUCTURES, INC.
75 SPRING HILL ROAD SACO, MAINE 04072
PHONE (207) 282-7360 FAX. (207) 282-1179
TENSOR 2998

STRUCTURE:	VT Route 125 over Lemon Fair River Bridge No. 9 Cornwall County of Addison	DRAWN: JTB	DATE: 06/01
		CHKD: PCP	DATE: 06/16
LOCATION:	CORNWALL, VERMONT	JOB NO.	DWG NO.
PROJ NO.	BRS 0172(6)	457	X1
CUSTOMER:	VT AOT		REV. △

RECEIVED
CK'D BY _____ COMPLY
JUN 23 2010
RESUBMIT _____ APPROVED ✓
BY DATE 7/20/10

PCP Wed, Jun 16, 2010 01:26:05 PM /users/jobs/2998/X1.Rev0