ABM INFO		SHIP	BILL OF MATERIAL					JOB NO.	DRAWING NO.	REV.
								457	6	
PAGE	LINE	MARK	QTY	MARK	MATERIAL	LENGTH m	LENGTH mm	REMARKS	WT	PROCUREMENT NOTES
		6CF1	32		CROSSFRAMES				99 kg 218 lbs	
2	G		32	a6	L 76x76x9.5	1	830			
2	H		64	b6	L 76x76x9.5	2	043			
2	J		64	pa6	PL 14x260	0	275			
2	K		64	pb6	PL 14x275	0	290			
2	L		32	pc6	PL 14x115	0	215			

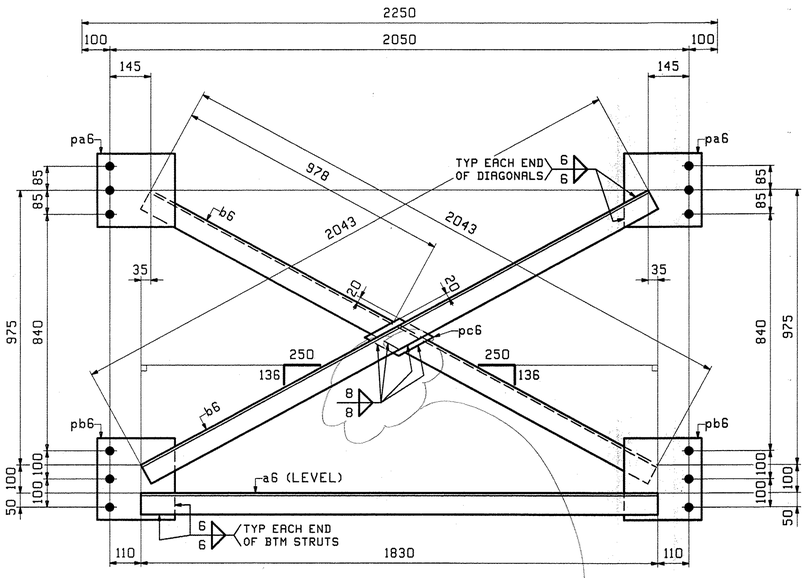

32 ~ CROSSFRAMES - 6CF1

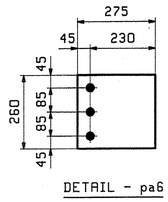

DETAIL - pa6

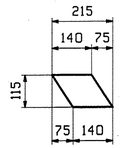

DETAIL - pc6

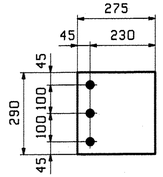

DETAIL - pb6

May use 6mm weld if desired

NOTE:
FOR GENERAL NOTES SEE DRAWING GN1.

REV.	DATE	REMARKS	DWN	CHK	APVL	SHOP
0					6/18/10	

MATERIAL:	SURFACE PREP. & PAINT:	HOLES:	SHOP BOLTS:
M270M-345W	SEE DWG GN1	15/16" Ø	NONE

DESCRIPTION: CROSSFRAMES

CASCO BAY STEEL STRUCTURES, INC.
75 SPRING HILL ROAD SACO, MAINE 04072
PHONE (207) 282-7360 FAX. (207) 282-1179

TENSOR 2998

STRUCTURE:		DRAWN:	DATE:
VT Route 125 over Lemon Fair River Bridge No. 9 Cornwall County of Addison		JTB	06/01
		CHKD: PCP	DATE: 06/16
LOCATION:	CORNWALL, VERMONT	JOB NO.	DWG NO.
PROJ NO.	BRS 0172(6)	457	6
CUSTOMER:	VT AOT		REV. △

RECEIVED
CK'D BY _____ OFFICE
JUN 23 2010
RESUBMIT _____ APPROVED As Noted
BY DATE 7/20/10

PCP Wed, Jun 16, 2010 01:35:44 PM /users/pbs/2998/6 | Rev0