TYPICAL SECTIONS & DESIGN DATA

ITEM 406.25 BITUMINOUS CONCRETE PAVEMENT
LEVELING COURSE, TYPE III OR IV (300 TONS/MILE)
AS DIRECTED BY THE ENGINEER
3/4" WEARING COURSE (±1/4") TYPE IV

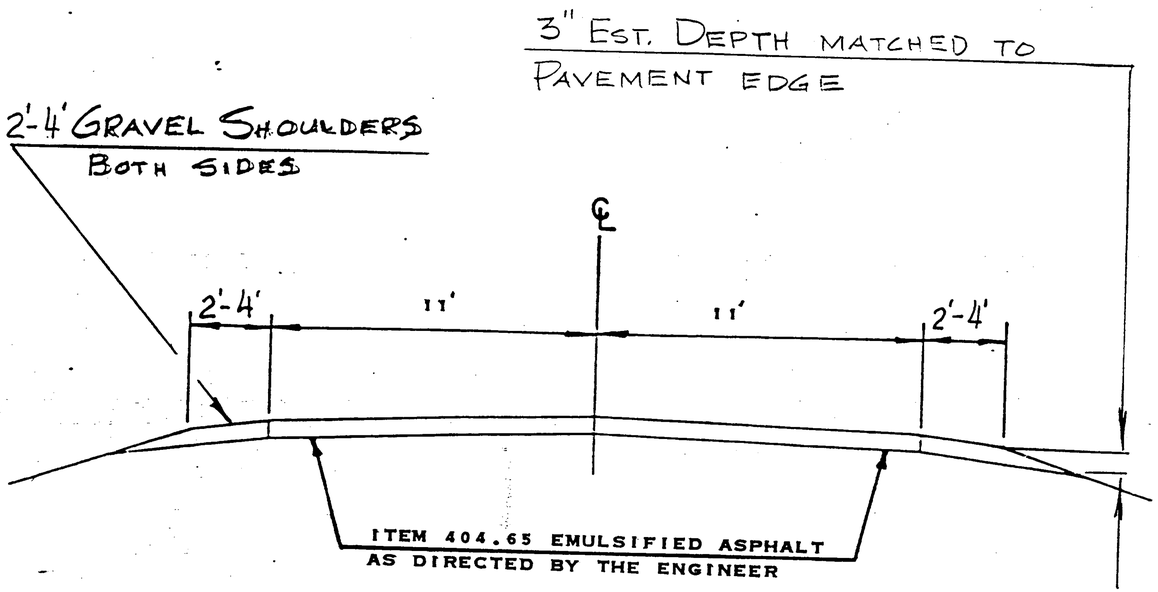

SECT. I - MM 1.400 - 1.761

SECT. II - MM 1.903 - 3.973

1982 ADT 1240
V 50

PROJECT WORCESTER

NO. RS 0241(20)

SHEET 11 OF 20 SHEETS