# TYPICAL SECTIONS & DESIGN DATA

ITEM 406.25 BITUMINOUS CONCRETE PAVEMENT
LEVELING COURSE TYPE III OR IV (150 TONS/MILE)
AS DIRECTED BY THE ENGINEER
1 1/4" WEARING COURSE (±1/4") TYPE III

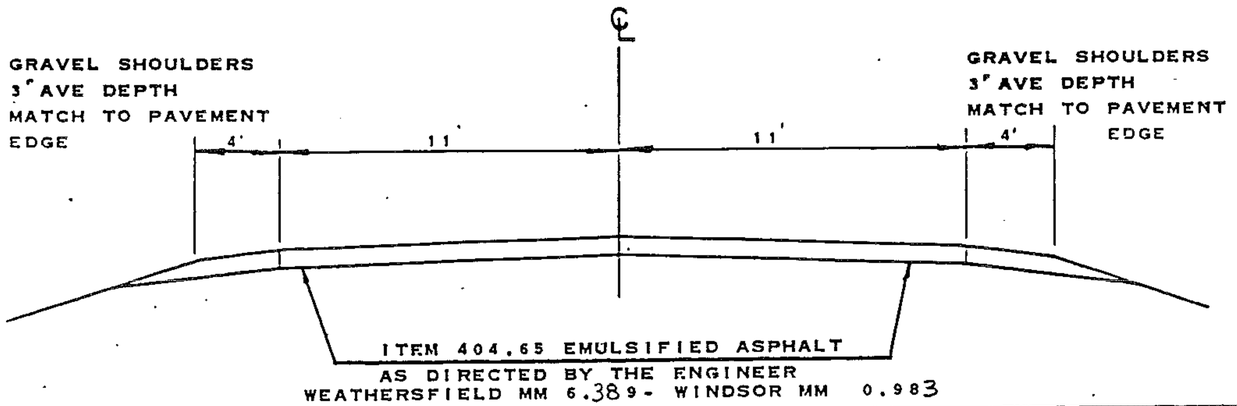


ITEM 406.25 BITUMINOUS CONCRETE PAVEMENT
LEVELING COURSE TYPE III OR IV (164 TONS/MILE)
AS DIRECTED BY THE ENGINEER
1 1/4" WEARING COURSE (±1/4") TYPE III

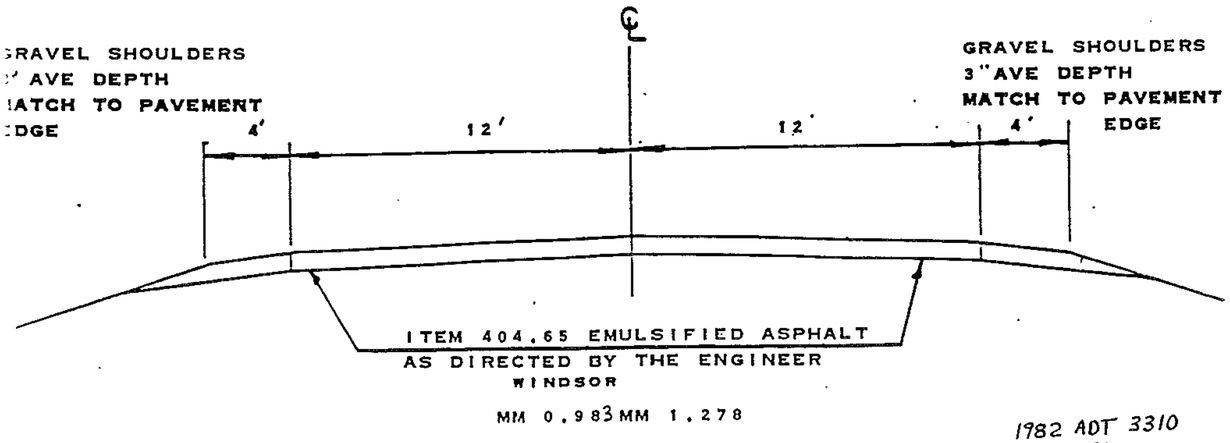


1982 ADT 3310
V= 50

Note: Topsoil, Item 653.10 to be applied as directed by the Engineer. Seed, Fertilizer, Limestone and Mulch Items to be applied as required, payment to be subsidiary to the Topsoil item.

PROJECT WEATHERSFIELD-WINDSOR

NO. HMA2645

SHEET 2 OF 12 SHEETS