NOTE 5
19.95M 1-4 50 DB CH16
19.95M 1-4 50 DB FP21
19.95M 1-4 75 DB CV14

NOTE 1
17.36M 1-4 125 ENC CV11
17.36M 1-4 75 ENC CV12
17.36M 1-4 75 ENC CV14,15,16,28
17.36M 1-4 50 ENC FP20,21,22
17.36M 1-4 50 ENC CH15,16,17
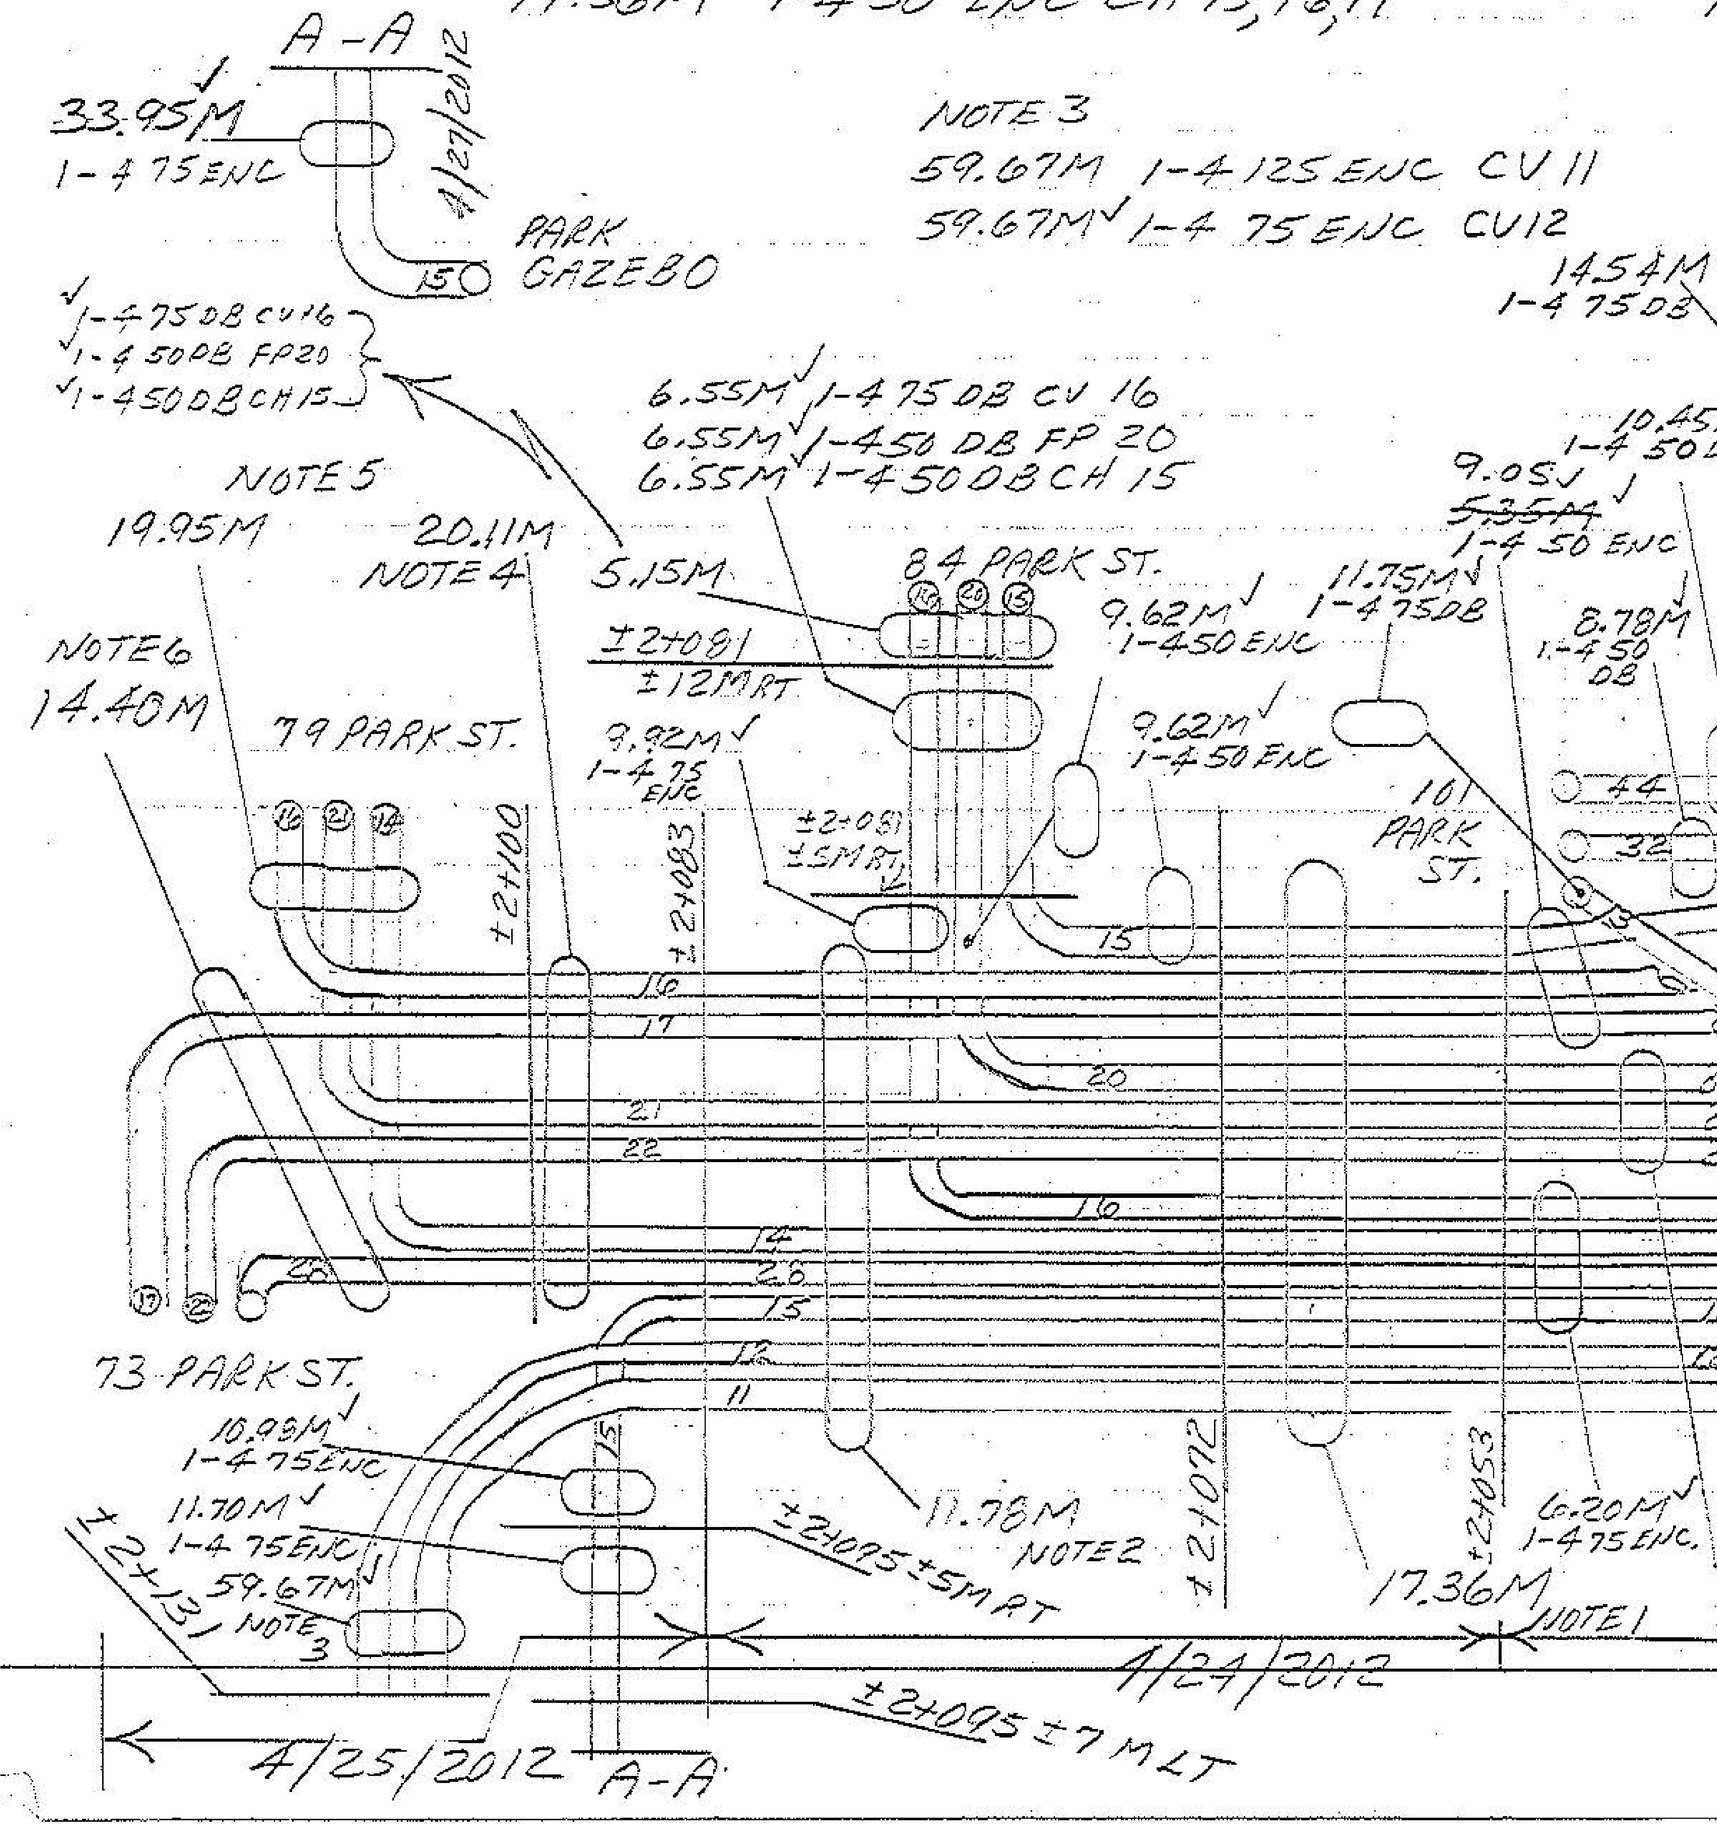
NOTE 3
59.67M 1-4 125 ENC CV11
59.67M 1-4 75 ENC CV12