5/2/2012

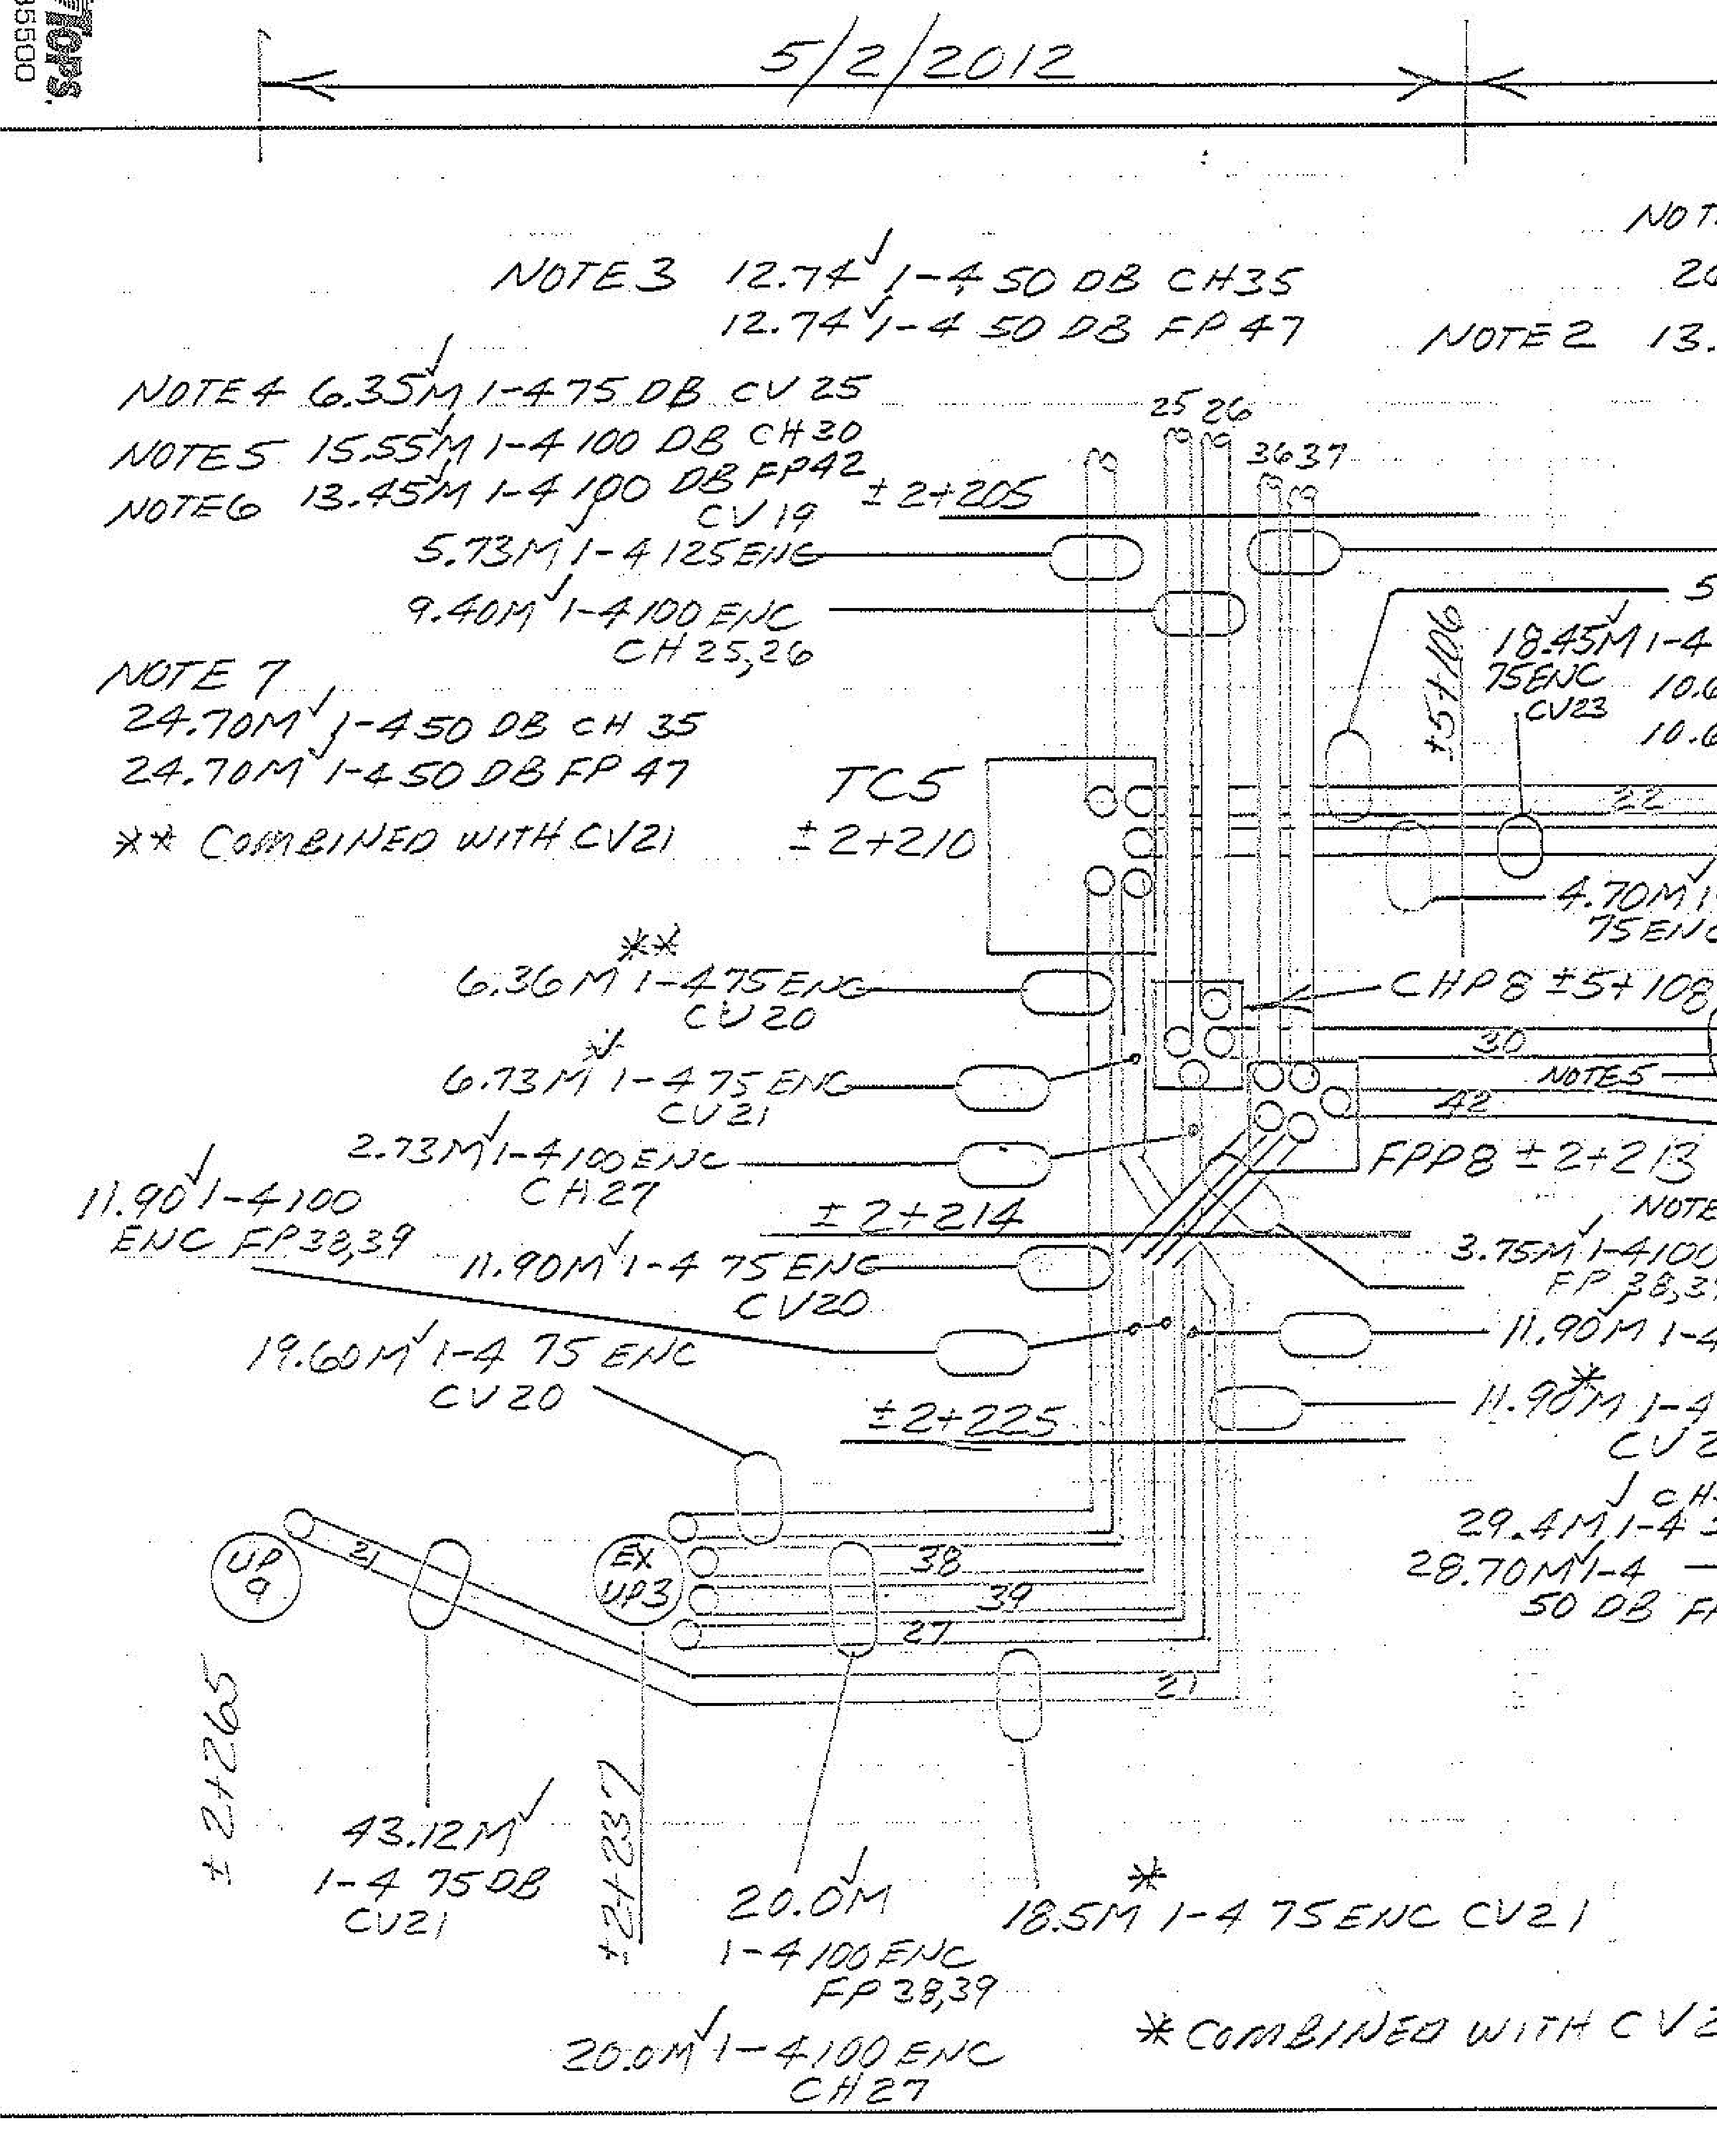
NOTE 3 12.74 1-4 50 DB CH35
12.74 1-4 50 DB FP 47
NOTE 4 6.35M 1-4 75 DB CV 25
NOTE 5 15.55M 1-4 100 DB CH 30
NOTE 6 13.45M 1-4 100 DB FP42
CV 19
5.73M 1-4 125 ENC
9.40M 1-4 100 ENC
CH 25,26
NOTE 7
24.70M 1-4 50 DB CH 35
24.70M 1-4 50 DB FP 47
** COMBINED WITH CV21
TC5
±2+210
±2+205
±5+106
18.45M 1-4
75 ENC
CV23
6.36M ** 1-4 75 ENC
CV 20
CHP8 ±5+108
6.73M * 1-4 75 ENC
CV21
2.73M 1-4 100 ENC
CH 27
FPP8 ±2+213
11.90 1-4 100
ENC FP 38,39
±2+214
11.90M 1-4 75 ENC
CV20
3.75M 1-4 100
FP 38,39
19.60M 1-4 75 ENC
CV 20
11.90M 1-4
11.90M * 1-4
±2+225
29.4M 1-4
28.70M 1-4
50 DB
UP 9
EX UP3
±2+265
43.12M
1-4 75 DB
CV21
±2+237
20.0M
1-4 100 ENC
FP 38,39
18.5M * 1-4 75 ENC CV21
20.0M 1-4 100 ENC
CH 27
* COMBINED WITH CV2