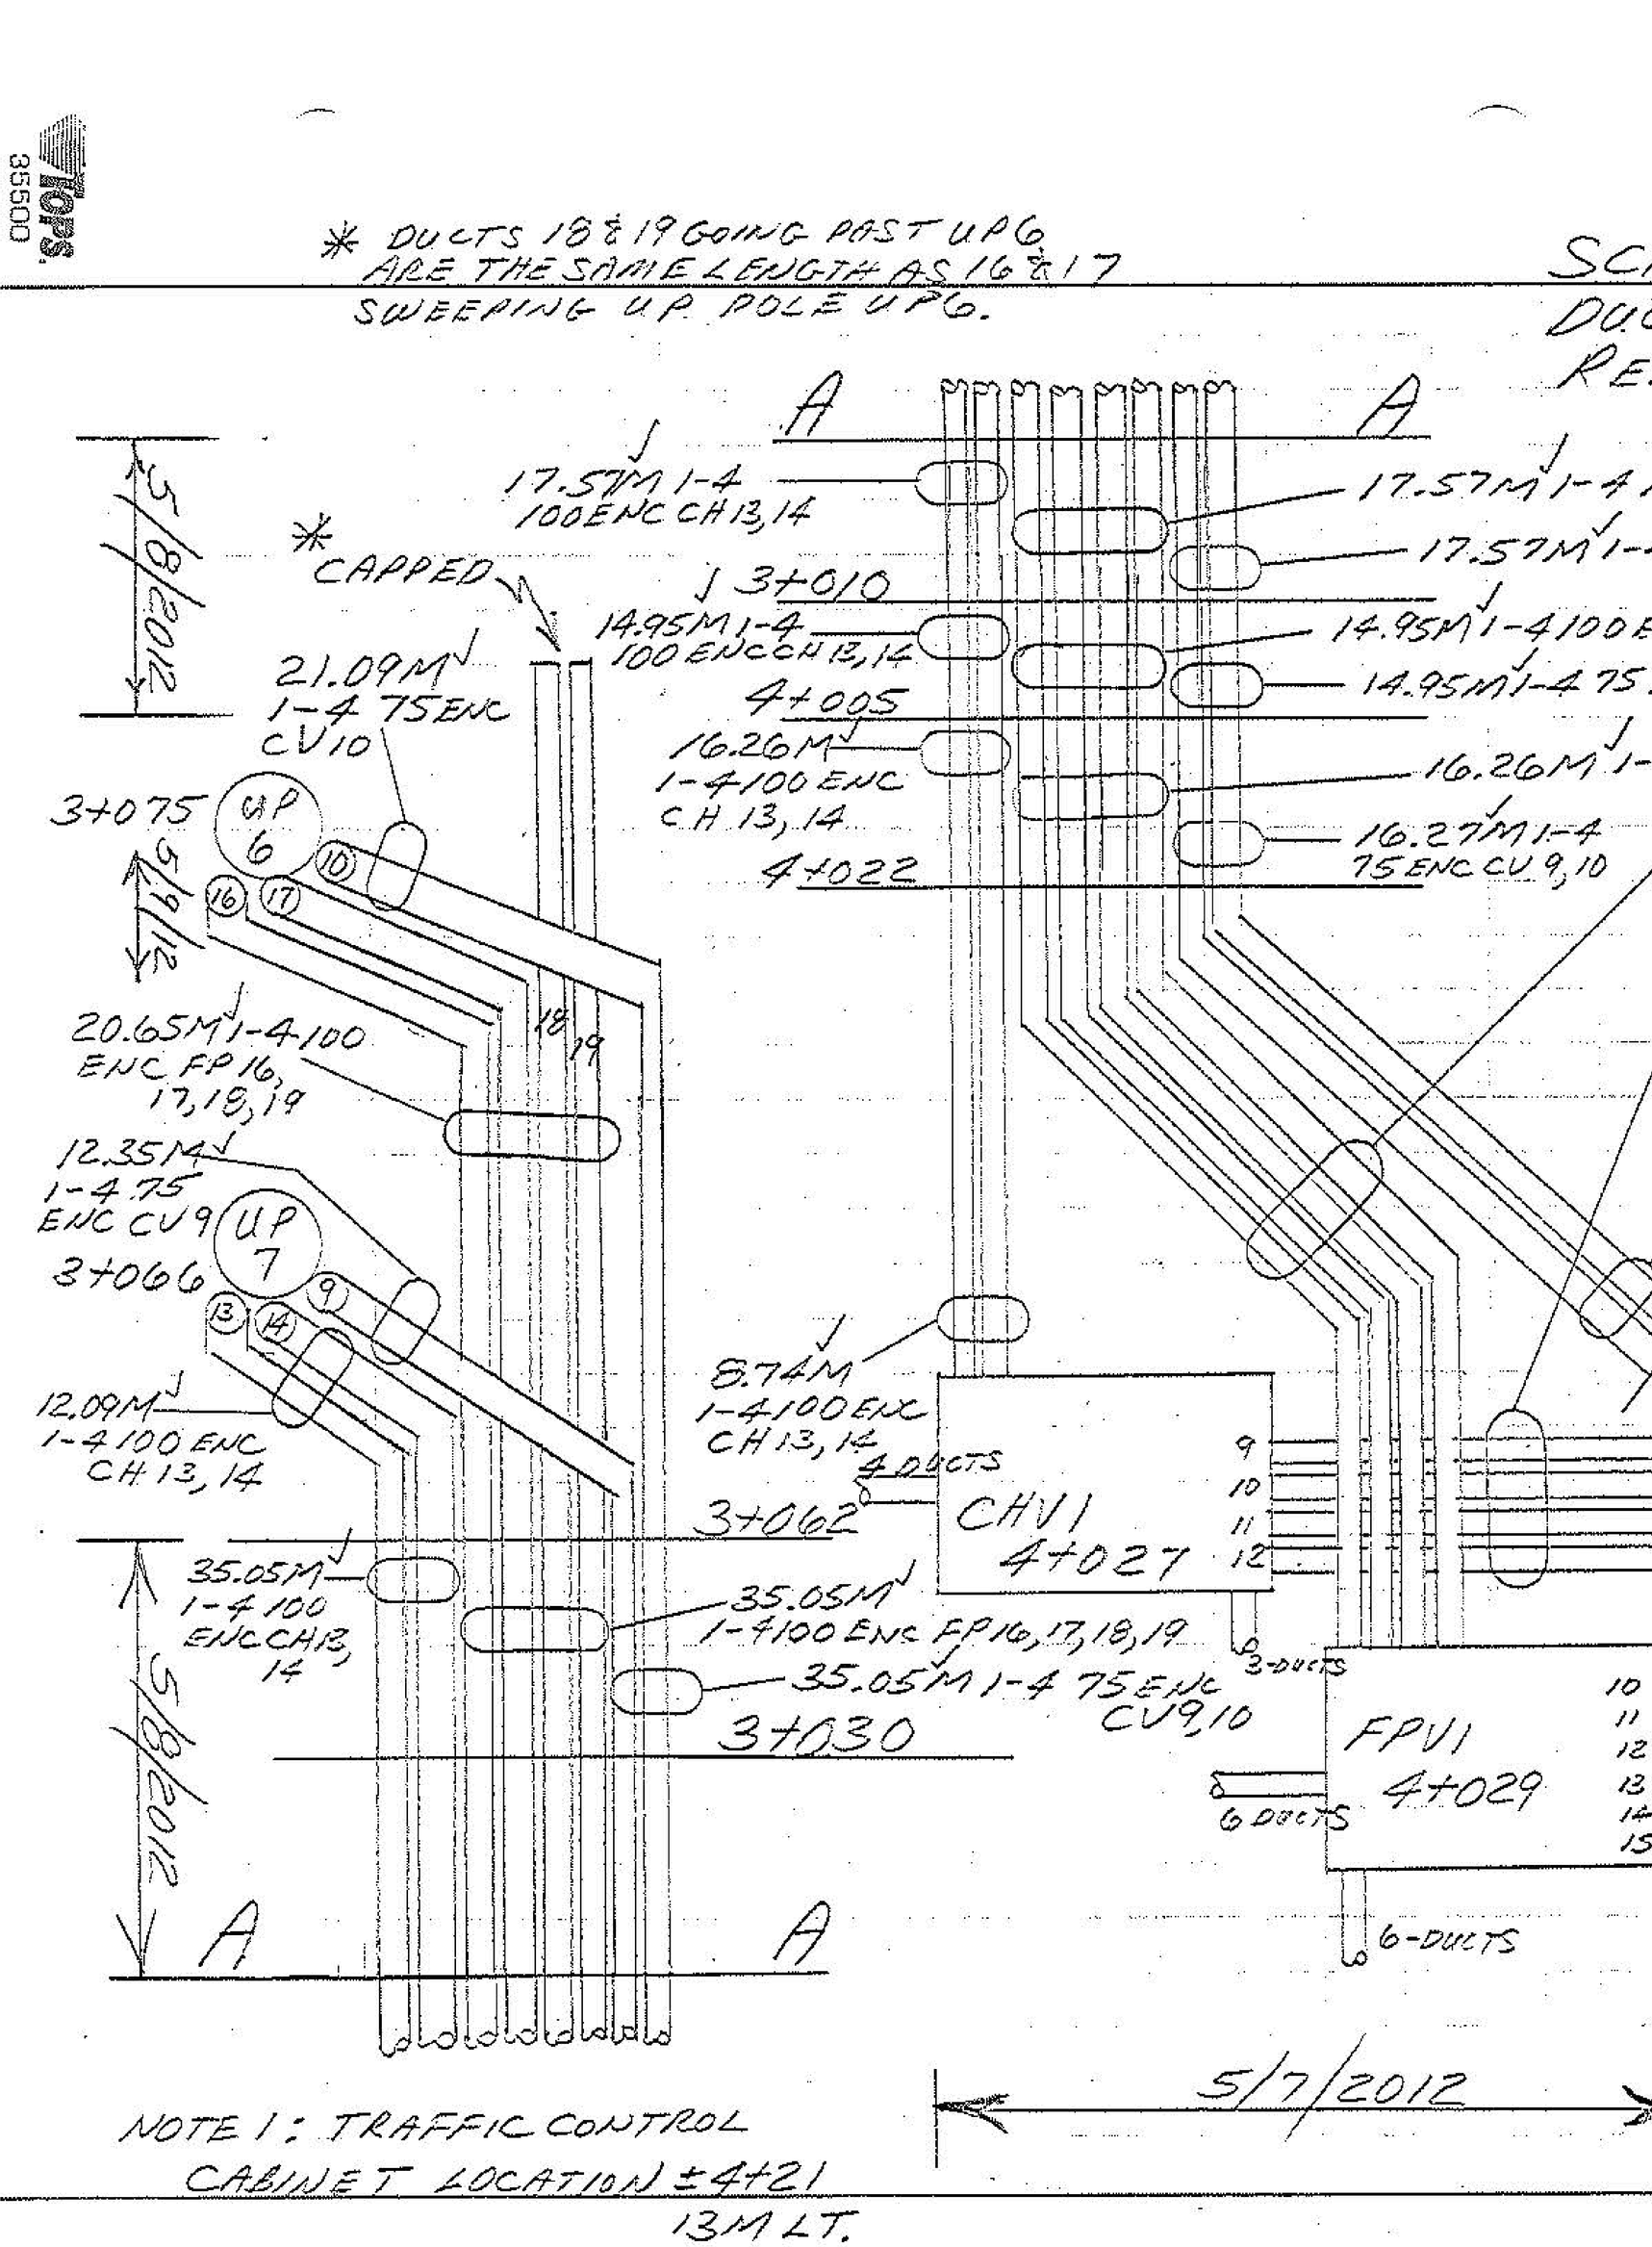

NOTE 1: TRAFFIC CONTROL CABINET LOCATION ±4+21 13M LT.