TRAFFIC ITEM AND TRAFFIC SIGN SUMMARY SHEET, NOTES AND DETAILS

MILEMARKER, STATION, OR SIGN NUMBER	SIGN LEGEND	SIGN DIMENSIONS	EXISTING SIGNS TO BE SALVAGED: REMOVE (EA.)	REMOVE (X)	RETAIN (X)	NEW AND SALVAGED SIGNS: NEW "A" (S.F.)	NEW "B" (S.F.)	SALV. SIGN (EA.)	SALV. T.I.S.(S.F.)	EXISTING POSTS: RET.	DRILL	REM.	SALV.	NEW SIGN POSTS: NUMBER OF POSTS	FLANGED CHANNEL: 2.0 LB./FT.	2.5 LB./FT.	3.0 LB./FT.	TUBULAR ALUMINUM: 3.0" Ø	3.0" □	4.0" Ø	4.0" Ø MOD.	W SHAPED STEEL: POST SIZE	WEIGHT	FTG. SIZE 24"	FTG. SIZE 30"	REMARKS	FOR SIGN DETAIL SHEET: PLAN SHEET NUMBER	STD. SHEET NUMBER
3.90 Rt.	RIGHT LANE FOR RIGHT TURN	30" x 30"				6.25								1			X										THIS SHEET	
3.99 Rt.	ONLY	30" x 30"				6.25								1			X										THIS SHEET	

---------	TOTALS					12.5											90#											

TRAFFIC ITEM SUMMARY

ITEM NO.	ITEM	UNIT		QUAN.		RND.	TOTAL
646.21	Painted Curb	LF		275		25	300
646.30	Durable 4" White Line	LF		320		-	320
646.31	Durable 4" Yellow Line	LF		1000		-	1000
646.35	Durable 8" Yellow Line	LF		120		5	125
646.40	Durable 24" Stop Bar	LF		48		2	50
646.42	Durable Arrow Markings	EA		3		-	3
646.44	Durable Letter In Word Marking	EA		28		-	28
646.50	Temp. 4" White Line	LF		12,960		40	13,000
646.51	Temp. 4" Yellow Line	LF		14,904		96	15000
675.20	Traffic Signs, Type A	SF		12.5		.5	13
675.30	Flanged Channel Sign Posts	LB		90		10	100

Durable Arrow Mark.
MM 3.99-MM 4.05 Rt.
(Turn Lane -3 As Shown)

Durable Letter In Word Markings
MM 3.07 Rt - "STOP"
MM 3.64 Lt. - "STOP"
MM 3.66 Rt - "STOP"
MM 4.03 Lt. - "STOP"
MM 3.99-MM 4.05 Rt - Turn Lane
3-"ONLY"s - As Shown

Durable 24" Stop Bar
MM 3.07 Rt - TH
MM 3.64 Lt - TH
MM 3.66 Rt - TH
MM 4.03 Lt. - TH

NOTES AND DETAILS

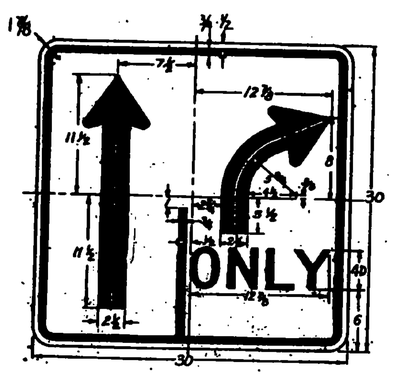

COLORS

LEGEND – BLACK (NON-REFL)
BACKGROUND – WHITE (REFL)

MATERIALS
SEE STD. E-15

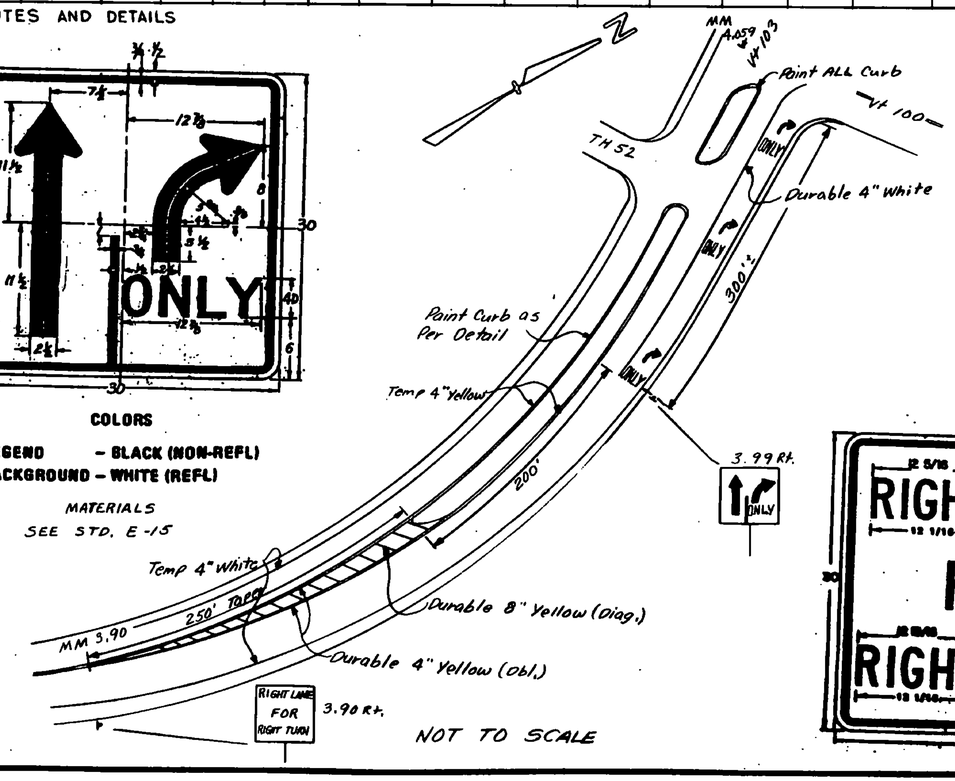

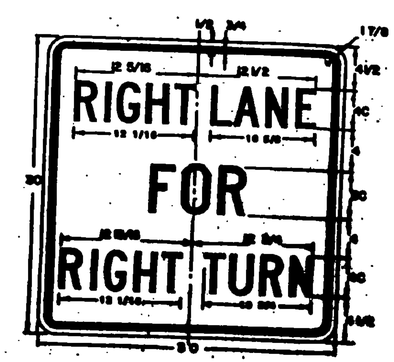

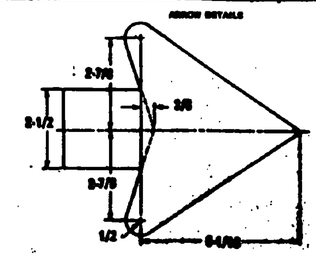

PROJECT LUDLOW ROUTE Vt 103 PROJECT #. F 025-1(29)S

TEMPORARY 4" YELLOW LINE

MILE	MILE	LT.	RT.	QTY. LEFT	℄ DOUBLE DASH	QTY. RT.	TOTAL
2.862	3.20	Solid	Solid	1785		1785	3570
3.20	3.55	Dash	Dash		462		462
3.55	3.64	Dash	Solid	119		475	594
3.64	3.90	Solid	Solid	1373		1373	2746
							7372
			4 TH's @	40' x 2		–	320
							7052
			100% Lost in Leveling			+	7052
							14104
	Edgelines around Islands					+	800
						TOTAL	14904

TEMPORARY 4" WHITE LINE

MILE	MILE	LT.	RT.	QTY. LEFT	℄ DOUBLE DASH	QTY. RT.	TOTAL
2.862	4.059	EL	EL	6320		6320	12640
Rt. Turn Lane Line (Leveling Course)						320	320
							12960

DRAWN BY TB DATE 12-96
CHKED BY ____ DATE ____

LUDLOW

PROJ. F NO. 025-1(29)S

TRAFFIC SHEET NO. 528 SHEET 4 OF 40