

**STONE FILL, TYPE I (MOD. - INLET PROTECTION)**

EXIST. DI @ 46+7.0 LT  
 EXIST. DI @ 46+65.0 RT  
 EXIST. DI @ 47+12.7 LT  
 EXIST. DI @ 48+79.6 LT

**GEOTEXTILE FABRIC FOR FILTERS**

PROP. CB @ 45+10 RT (9 S.F. INLET PROTECTION)  
 PROP. CB @ 45+50 LT (9 S.F. INLET PROTECTION)  
 PROP. CB @ 46+15 RT (9 S.F. INLET PROTECTION)  
 PROP. CB @ 47+10 RT (9 S.F. INLET PROTECTION)  
 PROP. CB @ 47+10 LT (9 S.F. INLET PROTECTION)  
 EXIST. DI @ 47+19.3 RT (9 S.F. INLET PROTECTION)  
 EXIST. DI @ 47+43.2 RT (9 S.F. INLET PROTECTION)  
 PROP. CB @ 49+40 RT (9 S.F. INLET PROTECTION)  
 PROP. CB @ 49+40 LT (9 S.F. INLET PROTECTION)  
 PROP. CB @ 25+44.1 RT (SAUNDERS AVE) (9 S.F. INLET PROTECTION)  
 EXIST. DI @ 25+99.6 LT (SAUNDERS AVE) (9 S.F. INLET PROTECTION)  
 PROP. CB @ 30+34.6 LT (PIERCE ST) (9 S.F. INLET PROTECTION)  
 PROP. CB @ 30+40.1 RT (PIERCE ST) (9 S.F. INLET PROTECTION)  
 EXIST. DI @ 30+41.9 LT (PIERCE ST) (9 S.F. INLET PROTECTION)  
 EXIST. DI @ 30+78.5 RT (PIERCE ST) (9 S.F. INLET PROTECTION)

**GEOTEXTILE FOR SILT FENCE**

45+00 ~ 45+61 RT  
 46+06 ~ 47+16 RT  
 47+42 ~ 48+84 RT  
 49+23 ~ 50+00 RT

**SEED**

45+00 ~ 50+00 RT  
 45+00 ~ 50+00 LT

**SEED ~ WINTER RYE**



45+00 ~ 50+00 RT  
 45+00 ~ 50+00 LT

**HAY MULCH**

45+00 ~ 50+00 RT  
 45+00 ~ 50+00 LT

**EROSION MATTING**

30+50 ~ 30+75 RT (PIERCE ST)  
 30+50 ~ 30+75 LT (PIERCE ST)

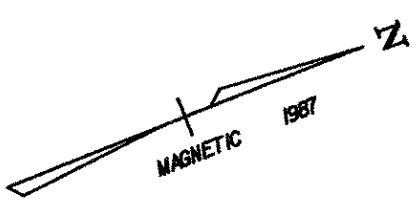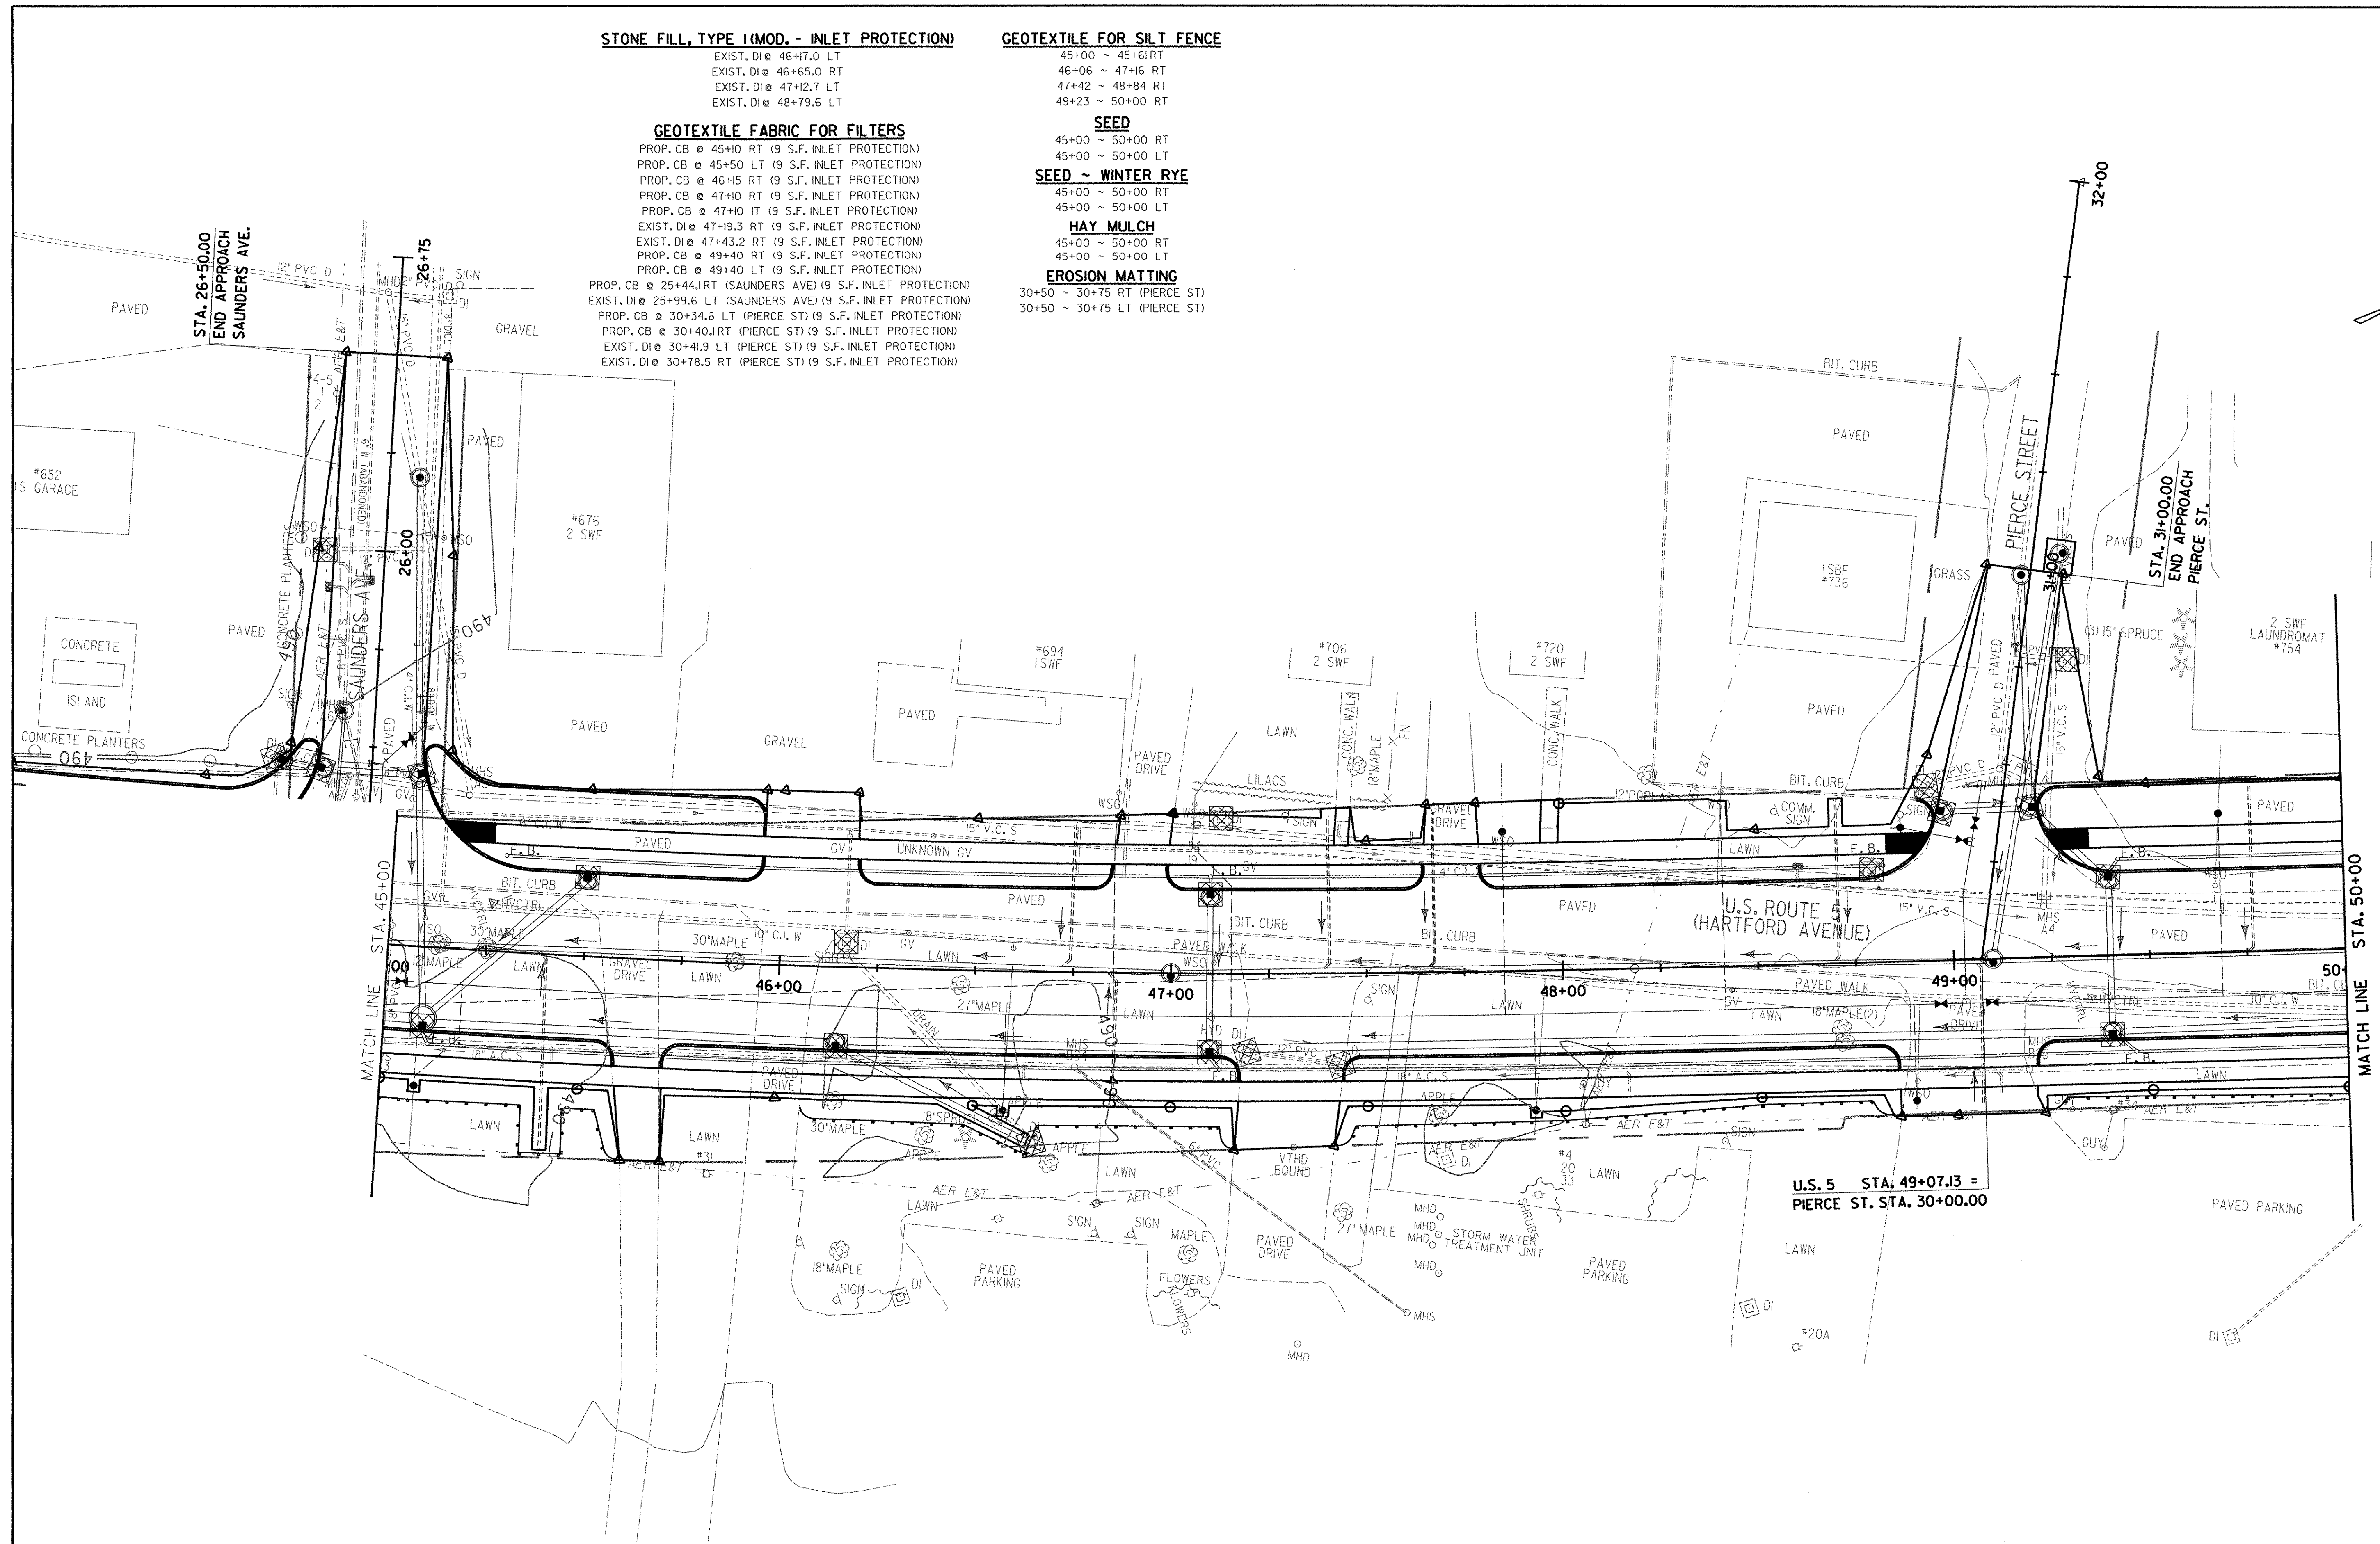


**CONSTRUCTION & STABILIZATION PLAN SHEET 6**

**EROSION CONTROL LEGEND**

	INLET PROTECTION (SEE DETAIL SHEETS FOR APPROPRIATE METHOD)		STABILIZED CONST. ENTRANCE
	TEMPORARY STONE CHECK DAM		SILT FENCE
	STONE DITCH		PROJECT DEMARCATION FENCING (LIMIT OF DISTURBANCE)
			FILTER CURTAIN

**DATUM**  
 VERTICAL NGVD 1929  
 HORIZONTAL N/A

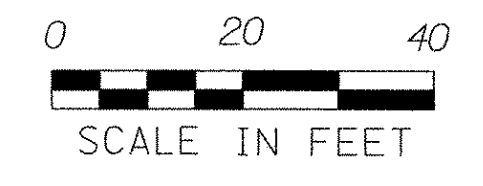

PROJECT: <b>HARTFORD</b>	PROJECT NO. : RS 0113(40)
DESIGN FILE NAME: z86c027er0sldr.DGN	PLOT DATE: 1/31/2007
IPARM FILE NAME:	SURVEY DATE: 1/87
SURVEYED BY: FANTONI	DRAWN BY: E. ATKINS
SQUAD LEADER: KEN UPMAL	SHEET: 139 OF 239