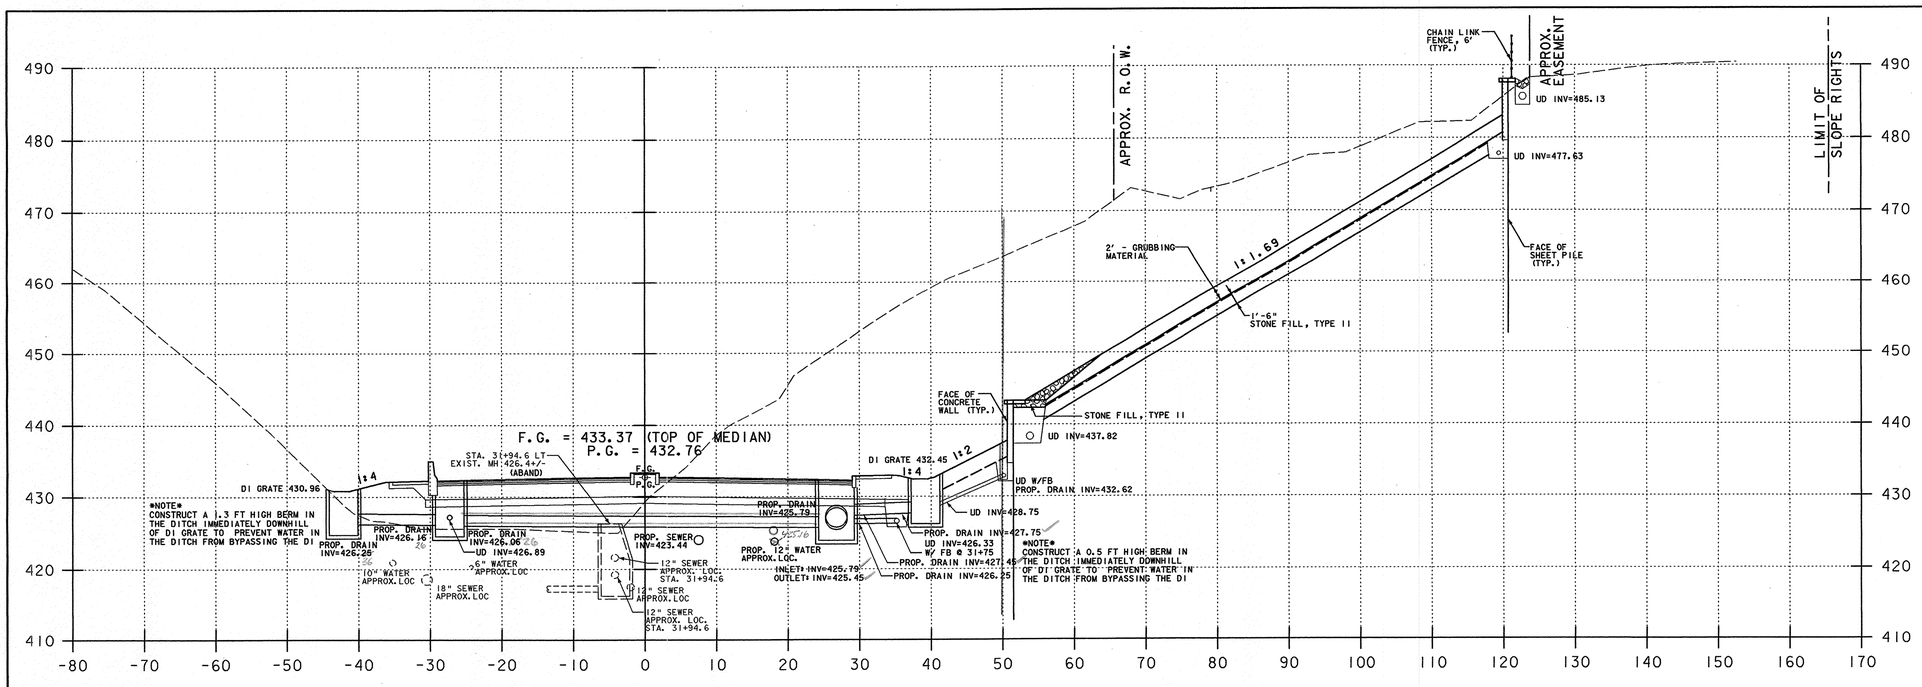

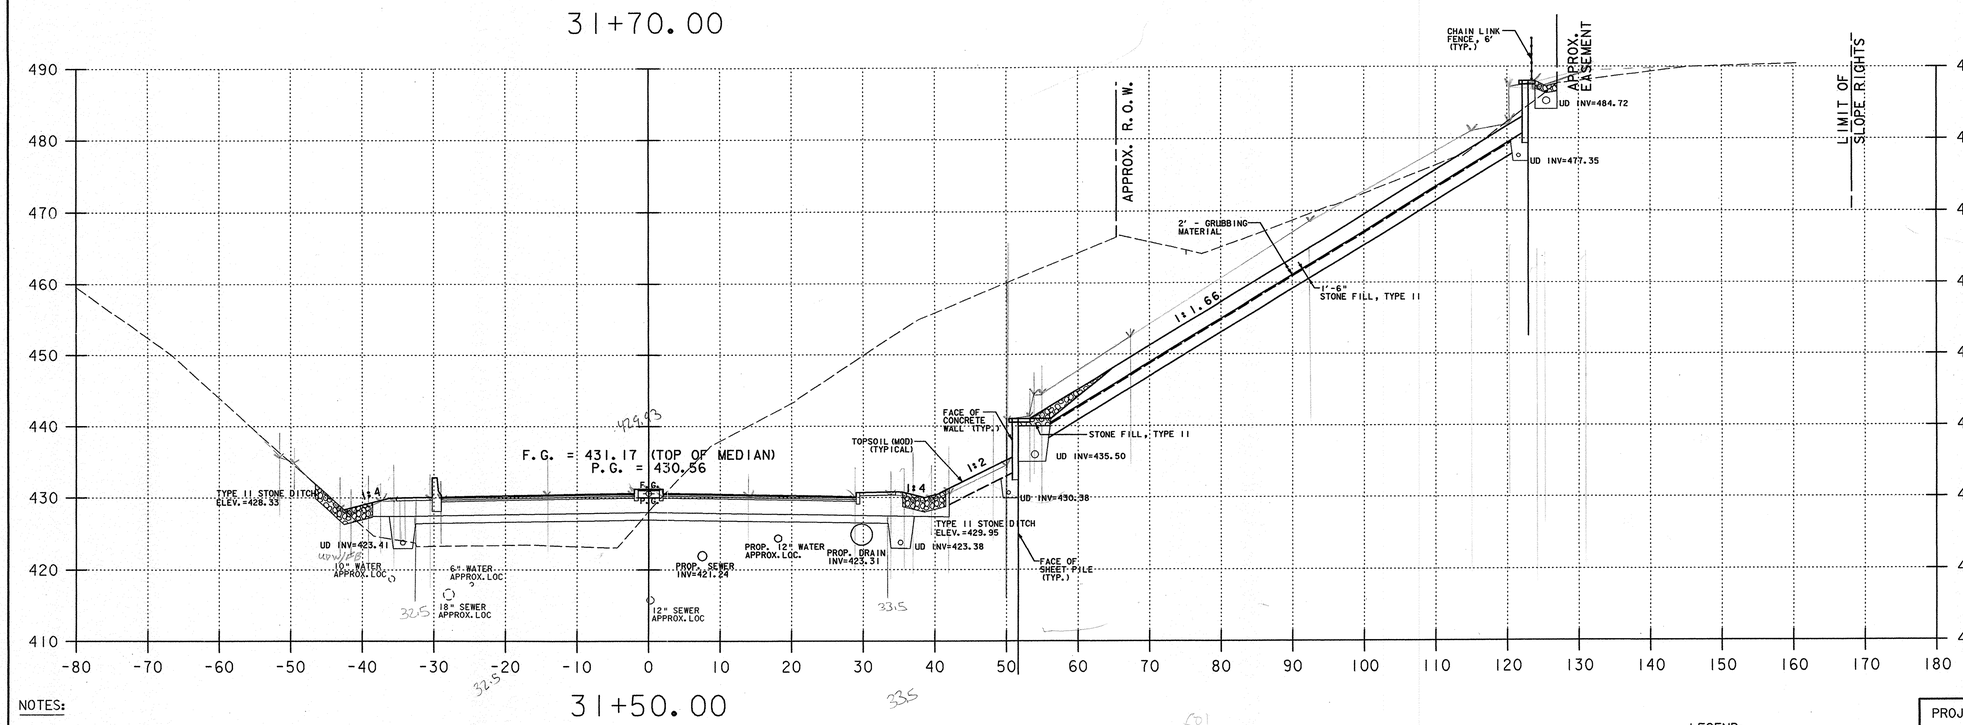

COMMON EXCAVATION
ROADWAY 50X115= 922.25 S.F.
DITCH LT 8'X2.16 S.F.
LANDSCAPE RT 1'X115=17.25 S.F.
COMMON = 938.25
BL 3/23/10
RCD 1/10/11

SAND 66.0 S.F.
SUBBASE ~~17.33~~ 157.6
F.G. = 80.5 LF
BL 3/23/10
RCD 1/10/11
CB 01/10/11
RCD 1/24/11
CB 01/25/11

U.S. ROUTE 5
HARTFORD AVENUE

NOTES:

1) REFER TO ROADWAY LAYOUT AND UTILITY LAYOUT SHEETS FOR PROPOSED ABANDONMENT, REMOVAL, OR PROTECTION REQUIREMENTS OF EXISTING UTILITIES IN CONFLICT WITH PROPOSED WORK.
2) THE WALL SHOWN ON THE SECTIONS IS FOR PRESENTATION ONLY. SEE U.S. RTE. 5 SHEET PILE WALL PLAN AND PROFILE SHEETS AND DETAIL SHEETS FOR CONSTRUCTION REQUIREMENTS.

LEGEND:

F.G. FINISHED GRADE

P.G. PROFILE GRADE

PROJECT NAME: HARTFORD	
PROJECT NUMBER: RS 0113(40)	
FILE NAME: ...z86c027xsl.DGN	PLOT DATE: 3/13/2008
PROJECT LEADER:	DRAWN BY: T. DUGUAY
DESIGNED BY: D. HOWEY	CHECKED BY: D. WOTRING
	SHEET 5 OF 14

REVISED 179 OF 239