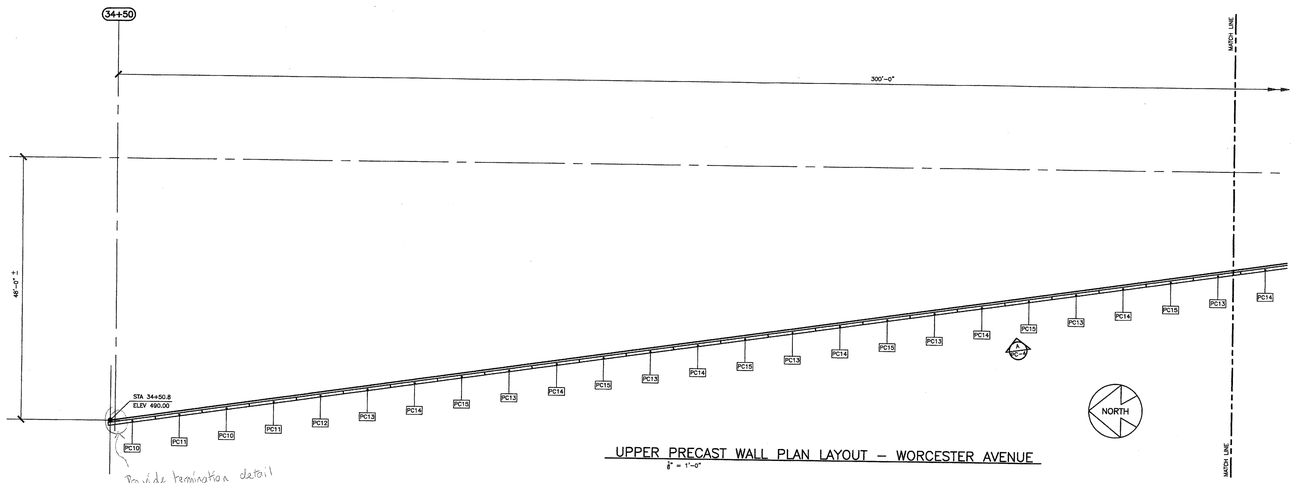

UPPER PRECAST WALL PLAN LAYOUT – WORCESTER AVENUE
3/8" = 1'-0"

1. WORK POINTS FROM SHEET 2 OF 14 BY VTRANS.
   - ASSUME STATION IS AT CENTERLINE OF ROADWAY AND HORIZONTAL DIMENSIONS PERPENDICULAR TO ROADWAY.
   - ELEVATION IS TO TOP OF CONCRETE COPING.
   - HORIZONTAL DIMENSION IS TO FACE OF SHEET PILE.

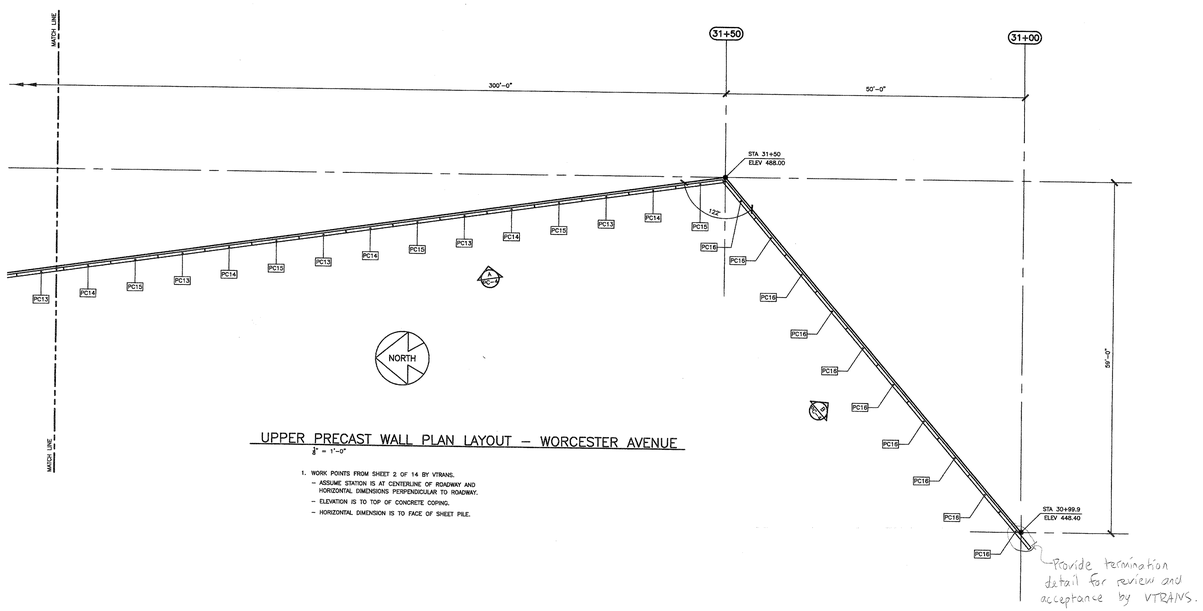

UPPER PRECAST WALL PLAN LAYOUT – WORCESTER AVENUE
3/8" = 1'-0"

1. WORK POINTS FROM SHEET 2 OF 14 BY VTRANS.
   - ASSUME STATION IS AT CENTERLINE OF ROADWAY AND HORIZONTAL DIMENSIONS PERPENDICULAR TO ROADWAY.
   - ELEVATION IS TO TOP OF CONCRETE COPING.
   - HORIZONTAL DIMENSION IS TO FACE OF SHEET PILE.

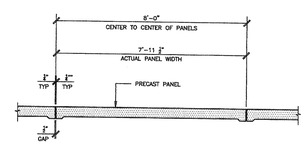

TYP. PANEL JOINT DETAIL
1/2" = 1'-0"

S.T. Griswold & Co. Inc.
183 Industrial Ave
PO Box 849
Williston, VT 05495
Ph: 802-878-0800
Fax: 802-658-2669
Architectural Precast Division

NPCA CERTIFIED PLANT

NOTE:

This shop drawing represents ST Griswold's interpretation of the architectural plans and specifications and our contract requirements for this project.

Prior to manufacture of product from this drawing, all dimensions, method of construction, and existing conditions must be checked, revised and approved by ST Griswold client.

GENERAL NOTES:

1) All mortar and control joints are assumed to be 3/8".
2) All lengths stated are actual lengths.
3) All anchorage to be provided & field by others:
   –Not responsibility of ST Griswold
4) All load anchorage to be supplied by others:
   –Not responsibility of ST Griswold

Approval Stamp:

The undersigned has reviewed this drawing and is returning it to ST Griswold with the following approval for fabrication and shipment.

- [ ] Approved
- [x] Approved as Noted
- [ ] Approved as Noted (Resubmit for record)
- [ ] Review and Resubmit

By: [signature] (Signature) Date: 7/21/08

By: Daniel Hoolay (Please Print)

Company: GrenDesign Inc.

* Please make note that revisions may affect pricing and lead times

No.	DATE	REVISION

McFarland Johnson
40 FARRELL STREET SOUTH BURLINGTON, VT 05403
Tel: (802) 862-9381 Fax: (802) 862-7450

TOWN OF HART FORD
COUNTY OF WINDSOR
U.S. ROUTE 5 (MAJOR COLLECTOR)
HARTFORD VERMONT

PRECAST WALL PANELS – BARRIER

DRAWN	APPROVED	PROJ. No.
GAB		17185.00
CHECKED	SCALE	DATE
RED	AS NOTED	6/03/08

PC-3

COPYRIGHT © 2008 McFarland-Johnson, Inc.

S:\Proj\Schmidt\17185\00 Hartford 5" Retaining Wall\PRE PC-3.1.dwg, 6/7/2008 11:15:18 AM