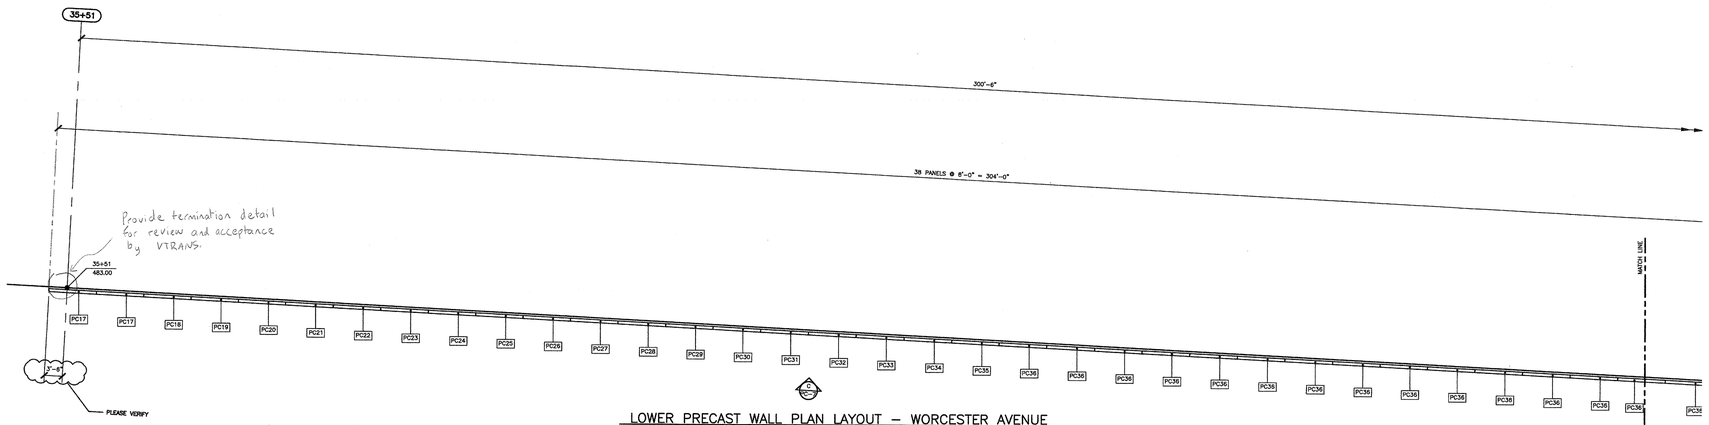
35+51
300'-6"
38 PANELS @ 8'-0" = 304'-0"
Provide termination detail for review and acceptance by VTRANS.
35+51
483.00
PC17
PC18
PC19
PC20
PC21
PC22
PC23
PC24
PC25
PC26
PC27
PC28
PC29
PC30
PC31
PC32
PC33
PC34
PC35
PC36
PC36
PC36