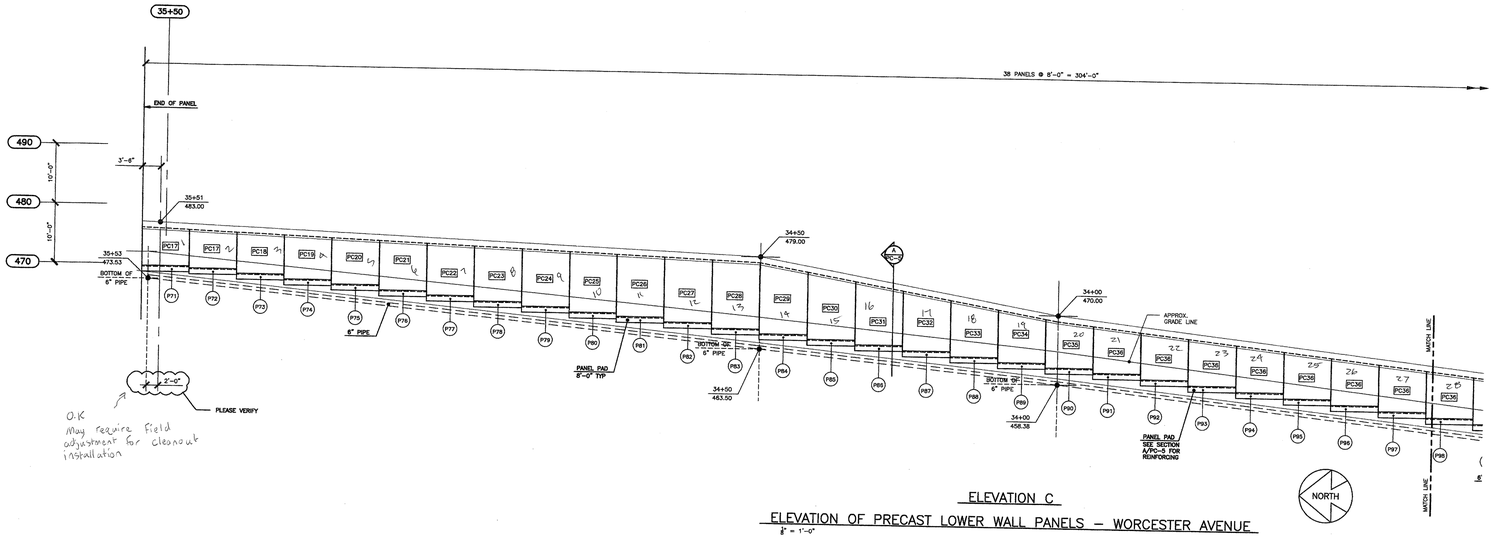

ELEVATION C

ELEVATION OF PRECAST LOWER WALL PANELS – WORCESTER AVENUE

1/8" = 1'-0"

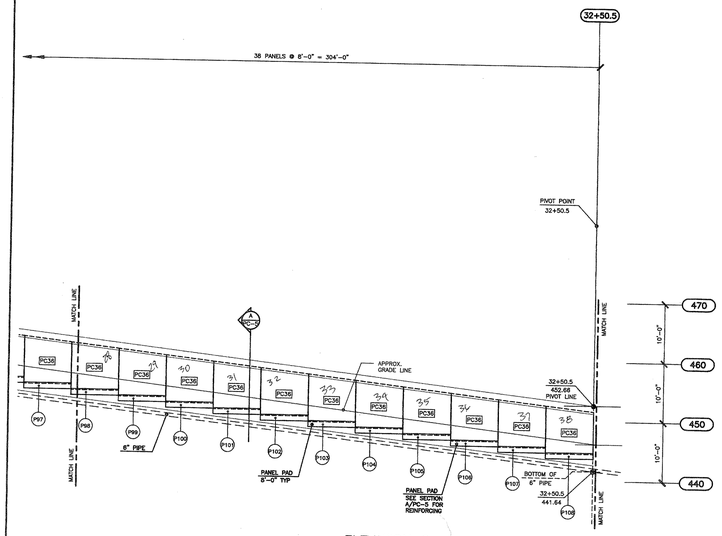

ELEVATION C

ELEVATION OF PRECAST LOWER WALL PANELS – WORCESTER AVENUE

1/8" = 1'-0"

ELEVATIONS FOR PAD AT PRECAST CONCRETE PANELS

PAD MARK	ELEV. TOP OF PAD	PAD MARK	ELEV. TOP OF PAD	PAD MARK	ELEV. TOP OF PAD	PAD MARK	ELEV. TOP OF PAD	PAD MARK	ELEV. TOP OF PAD
1 P71	475.68	P79 9	469.96	P87 17	463.67	P95 25	456.77	P103 33	449.37
2 P72	475.36	P80 10	469.13	P88 18	462.81	P96 26	455.85	P104 34	448.45
3 P73	474.61	P81 11	468.54	P89 19	461.98	P97 27	454.92	P105 35	447.52
4 P74	473.81	P82 12	467.77	P90 20	461.23	P98 28	453.99	P106 36	446.59
5 P75	473.10	P83 13	466.86	P91 21	460.47	P99 29	453.07	P107 37	445.67
6 P76	472.24	P84 14	466.08	P92 22	459.55	P100 30	452.15	P108 38	444.74
7 P77	471.55	P85 15	465.31	P93 23	458.63	P101 31	451.22		
8 P78	470.69	P86 16	464.54	P94 24	457.70	P102 32	450.30		

GRISWOLD
S.T. Griswold & Co. Inc.
103 Industrial Ave
PO Box 187
Greenville, SC 29602
Ph: 800-456-0201
Fax: 800-456-0888
Architectural Precast Division
NPCA CERTIFIED PLANT

NOTE:

This shop drawing represents ST Griswold's interpretation of the architectural plans and specifications and our contract requirement for this project.

Prior to manufacture of product from this drawing, all dimensions, method of construction, and existing conditions must be checked, revised and approved by ST Griswold, Client.

GENERAL NOTES:

1) All mortar and sealant joints are assumed to be 3/8".
2) All angles shown are assumed to be 90°.
3) All heights stated to be verified in field by others.
4) All field responsibility of ST Griswold.
All field responsibility of others by others:
–Not responsibility of ST Griswold.

Approval Stamp:

The undersigned has reviewed this drawing and is returning it to you approved with the following approval for fabrication and shipment:

- [ ] Approved
- [x] Approved as Noted
- [ ] Approved as Noted (Resubmit for record)
- [ ] Revise and Resubmit

By: _____ Date: 7/21/08
Signature
By: Daniel Hawley
Please Print
Company: Geo Design Inc.

* Please make note that revisions may affect pricing and lead times

No.	DATE	REVISION

McFarland Johnson
40 FARRELL STREET SOUTH BURLINGTON, VT 05403
Tel: (802) 862-9381 Fax: (802) 862-7450

TOWN OF HART FORD
COUNTY OF WINDSOR
U.S. ROUTE 5 (MAJOR COLLECTOR)
HARTFORD VERMONT

PRECAST WALL PANELS – BARRIER

DRAWN	APPROVED	PROJ. No.
GAB		17185.00
CHECKED	SCALE	DATE
RED	AS NOTED	6/03/08

PC-7

COPYRIGHT © 2008 McFarland-Johnson, Inc.