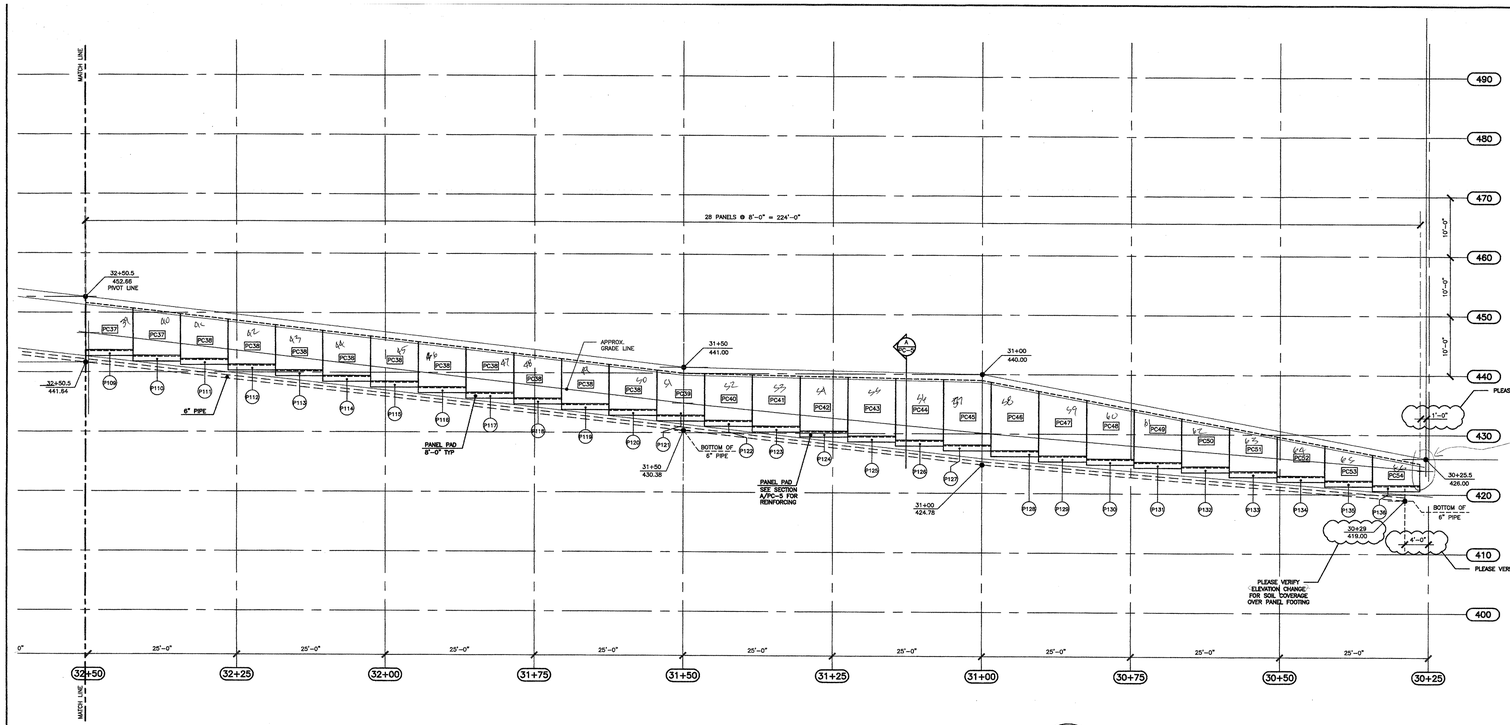

ELEVATION D

ELEVATION OF PRECAST LOWER WALL PANELS – WORCESTER AVENUE

1/4" = 1'-0"

NORTH

ELEVATIONS FOR PAD AT PRECAST CONCRETE PANELS							
PAD MARK	ELEV. TOP OF PAD	PAD MARK	ELEV. TOP OF PAD	PAD MARK	ELEV. TOP OF PAD	PAD MARK	ELEV. TOP OF PAD
P109	443.90	P117	436.64	P125	429.59	P133	423.84
P110	442.98	P118	435.73	P126	428.93	P134	423.09
P111	442.14	P119	434.81	P127	428.16	P135	422.34
P112	441.23	P120	433.89	P128	427.21	P136	421.58
P113	440.31	P121	432.97	P129	426.58		
P114	439.39	P122	432.12	P130	425.96		
P115	438.48	P123	431.20	P131	425.34		
P116	437.56	P124	430.40	P132	424.58		

224
304
528

Provide termination detail for review and acceptance by VTRANS.

O.K. by GeoDesign
-may require field adjustment for cleanout installation.

GRISWOLD

S.T. Griswold & Co. Inc.
183 Industrial Ave
PO Box 849
Williston, VT 05495
Ph: 802-658-0220
Fax: 802-658-6669

Architectural Precast Division

NPCA CERTIFIED PLANT

NOTE:

This shop drawing represents ST Griswold's interpretation of the architectural plans and specifications and our contract requirements for this project.

Prior to manufacture of product from this drawing, all dimensions, method of construction, and existing conditions must be checked, revised and approved by ST Griswold& client.

GENERAL NOTES:

1) All mortar and control joints are assumed to be 3/8".
2) All lengths stated are actual lengths.
3) All heights noted to be verified in field by others:
   -Not responsibility of ST Griswold.
4) All box anchorage to be supplied by others:
   -Not responsibility of ST Griswold.

Approval Stamp:

The undersigned has reviewed this drawing and is returning it to ST Griswold with the following approval for fabrication and shipment.

- [ ] Approved
- [X] Approved as Noted
- [ ] Approved as Noted (Resubmit for record)
- [ ] Revise and Resubmit

By: _____ (Signature) Date: 7/21/08

By: Daniel Hawley (Please Print)

Company: GeoDesign, Inc.

* Please make note that revisions may effect pricing and lead times

No.	DATE	REVISION

McFarland Johnson
40 FARRELL STREET SOUTH BURLINGTON, VT 05403
Tel: (802) 862-9381 Fax: (802) 862-7450

TOWN OF HART FORD
COUNTY OF WINDSOR
U.S. ROUTE 5 (MAJOR COLLECTOR)
HARTFORD VERMONT

PRECAST WALL PANELS – BARRIER

DRAWN	APPROVED	PROJ. No.
GAB		17185.00
CHECKED	SCALE	DATE
RED	AS NOTED	6/03/08

PC-8

COPYRIGHT © 2008 McFarland-Johnson, Inc.

W:\Drawings\17185\00 Barrier\4 Drawing Sheets\PC-8.dwg, 6/3/2008 11:09:11 AM