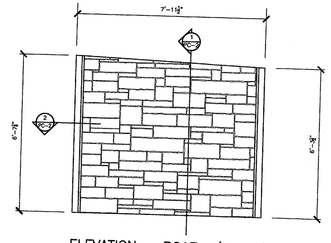

ELEVATION PC17 (2 pcs)
3/8" = 1'-0"

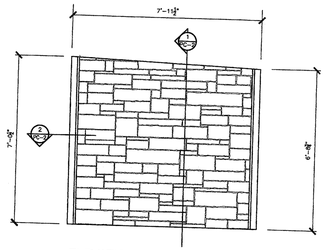

ELEVATION PC18 (1 pc)
3/8" = 1'-0"

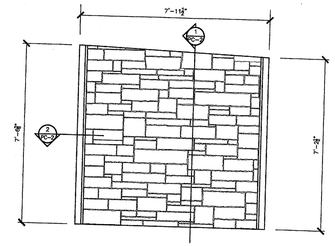

ELEVATION PC19 (1 pc)
3/8" = 1'-0"

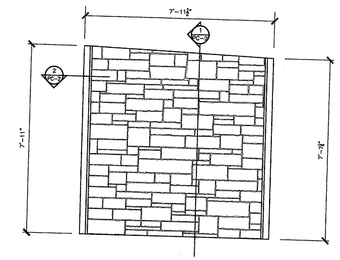

ELEVATION PC20 (1 pc)
3/8" = 1'-0"

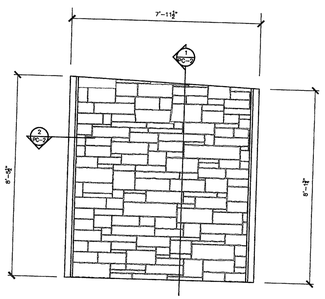

ELEVATION PC21 (1 pc)
3/8" = 1'-0"

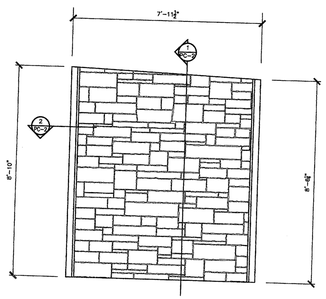

ELEVATION PC22 (1 pc)
3/8" = 1'-0"

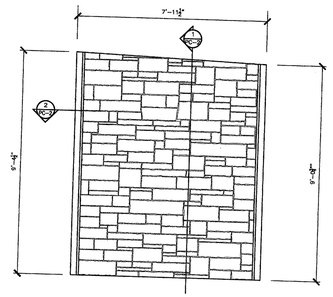

ELEVATION PC23 (1 pc)
3/8" = 1'-0"

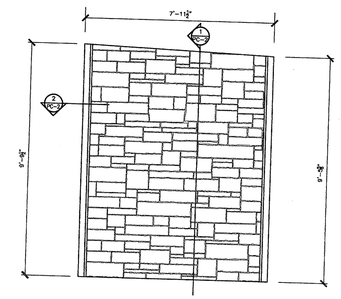

ELEVATION PC24 (1 pc)
3/8" = 1'-0"

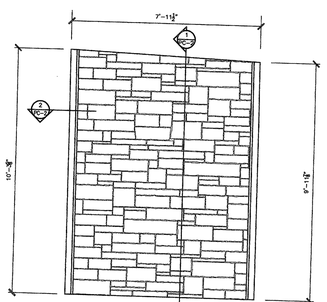

ELEVATION PC25 (1 pc)
3/8" = 1'-0"

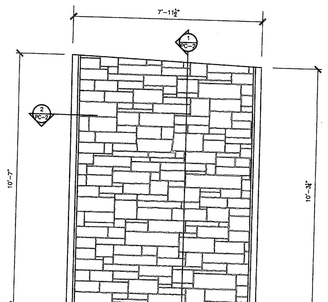

ELEVATION PC26 (1 pc)
3/8" = 1'-0"

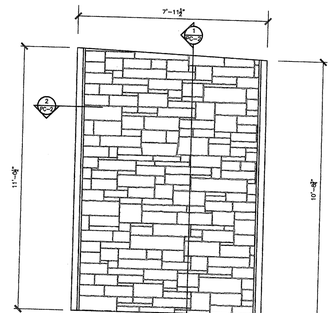

ELEVATION PC27 (1 pc)
3/8" = 1'-0"

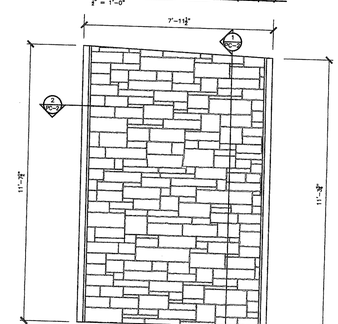

ELEVATION PC28 (1 pc)
3/8" = 1'-0"

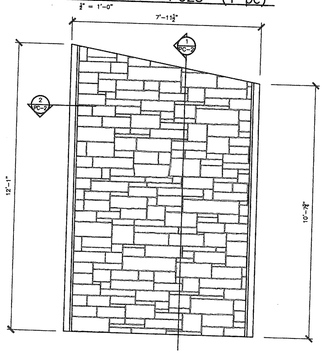

ELEVATION PC29 (1 pc)
3/8" = 1'-0"

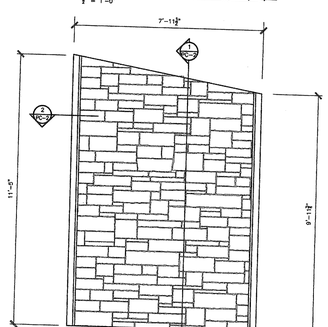

ELEVATION PC30 (1 pc)
3/8" = 1'-0"

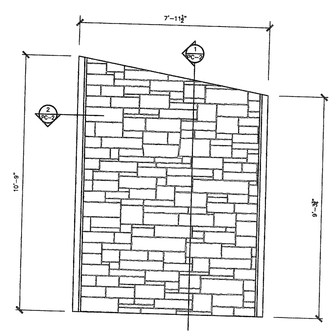

ELEVATION PC31 (1 pc)
3/8" = 1'-0"

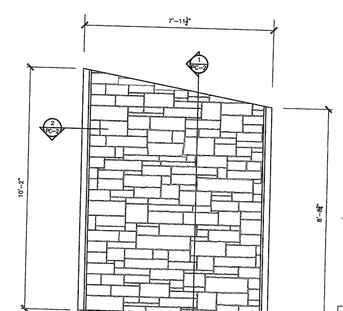

ELEVATION PC32 (1 pc)
3/8" = 1'-0"

* contractor to verify dimensions

NOTE:
SEE SHEET PC-5 FOR PANEL REINFORCING, DETAILS AND NOTES.

COPYRIGHT © 2008 McFarland-Johnson, Inc.

GRISWOLD
S.T. Griswold & Co. Inc.
153 Industrial Ave
PO Box 187
Williston, VT 05495
Ph: 802-658-0001
Fax: 802-658-5889
Architectural Precast Division

NPCA CERTIFIED PLANT

NOTE:

This shop drawing represents ST Griswold's interpretation of the contractual plans and specifications and our contract requirements for this project.

Prior to manufacture of product from this drawing, all dimension method of construction, and additional information must be checked reviewed and approved by ST Griswold staff.

GENERAL NOTES:

1) All mortar and control joints are assumed to be 3/8".
2) All lengths stated are actual lengths.
3) All lengths stated to be verified in field by others:
   *Not responsibility of ST Griswold.
4) All load embeds to be shown by others:
   *Not responsibility of ST Griswold.

Approval Stamp:

The undersigned has reviewed this drawing and is returning it to ST Griswold with the following approval for fabrication and shipment:

- [ ] Approved
- [x] Approved as Noted
- [ ] Approved as Noted (Resubmit for record)
- [ ] Revise and Resubmit

By: (Signature) Date: 7/21/08

By: (Print Name) Daniel Hively

Company: GEO Design, Inc.

* Please make note that revisions may effect pricing and lead times

No.	DATE	REVISION

McFarland Johnson
40 FARRELL STREET SOUTH BURLINGTON, VT 05403
Tel: (802) 862-9381 Fax: (802) 862-7450

TOWN OF HART FORD
COUNTY OF WINDSOR
U.S. ROUTE 5 (MAJOR COLLECTOR)
HARTFORD VERMONT

PRECAST ELEVATIONS

DRAWN	APPROVED	PROJ. No.
GAB		17185.00
CHECKED	SCALE	DATE
RED	AS NOTED	6/03/08

PC-9