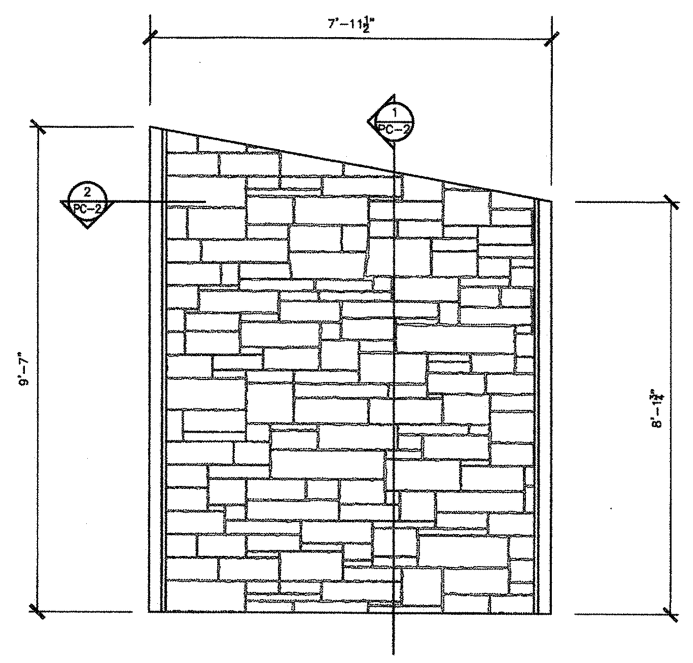

ELEVATION PC33 (1 pc)
3/4" = 1'-0"

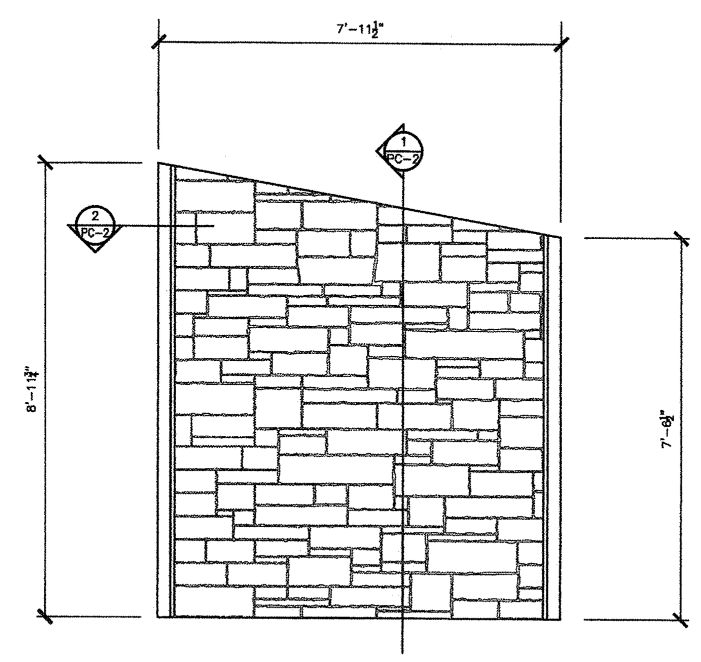

ELEVATION PC34 (1 pc)
3/4" = 1'-0"

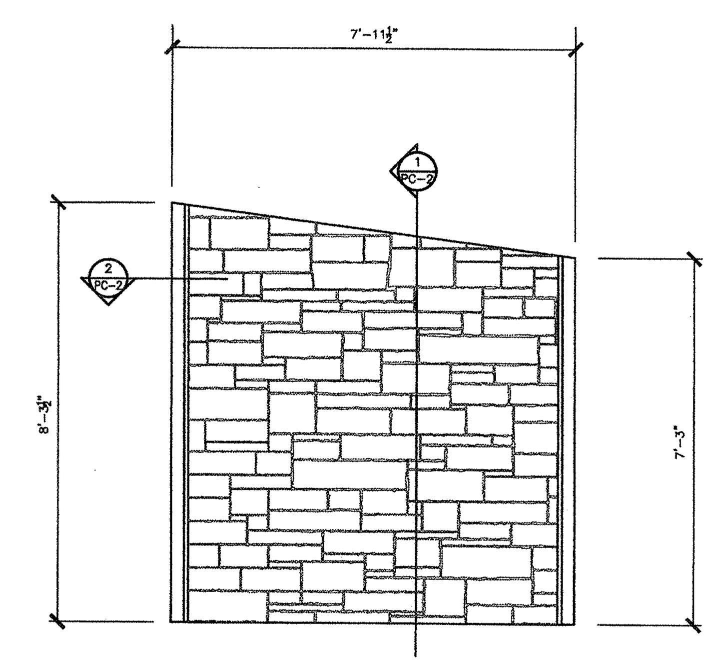

ELEVATION PC35 (1 pc)
3/4" = 1'-0"

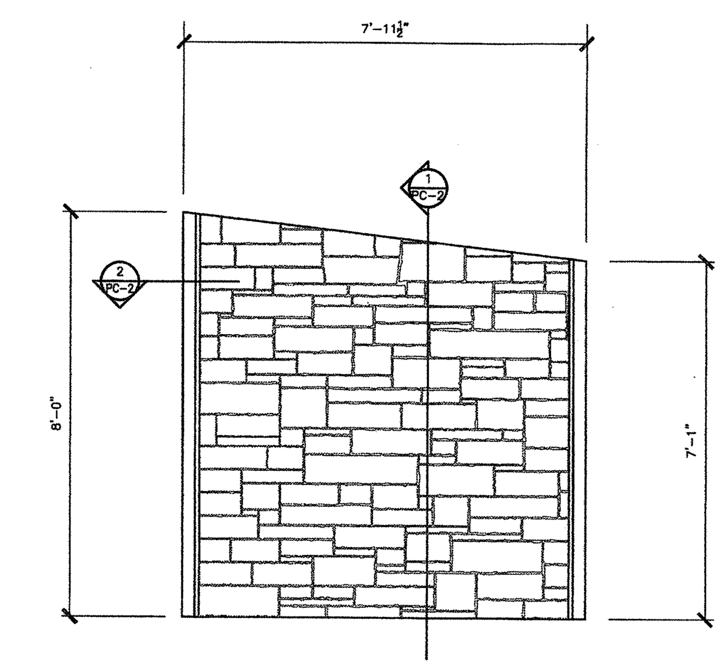

ELEVATION PC36 (18 pcs)
3/4" = 1'-0"

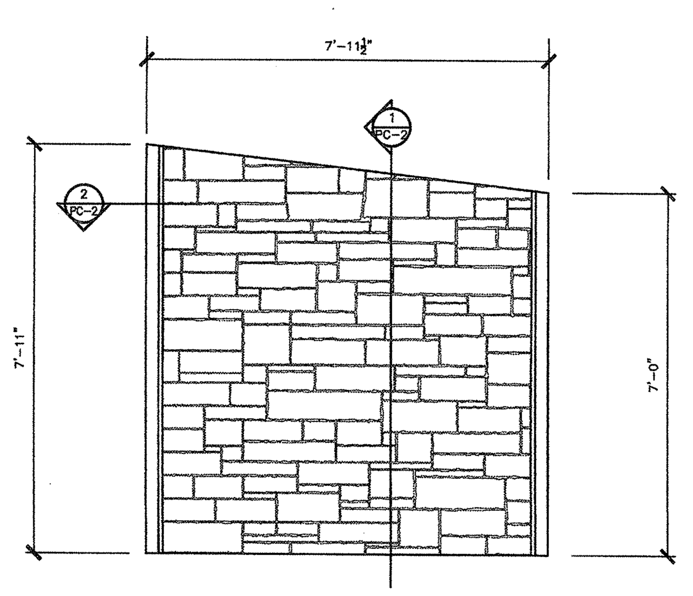

ELEVATION PC37 (2 pcs)
3/4" = 1'-0"

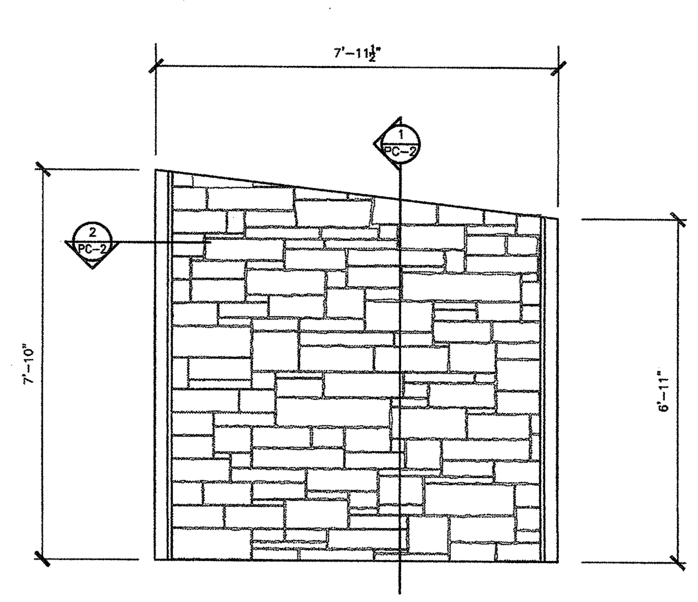

ELEVATION PC38 (10 pcs)
3/4" = 1'-0"

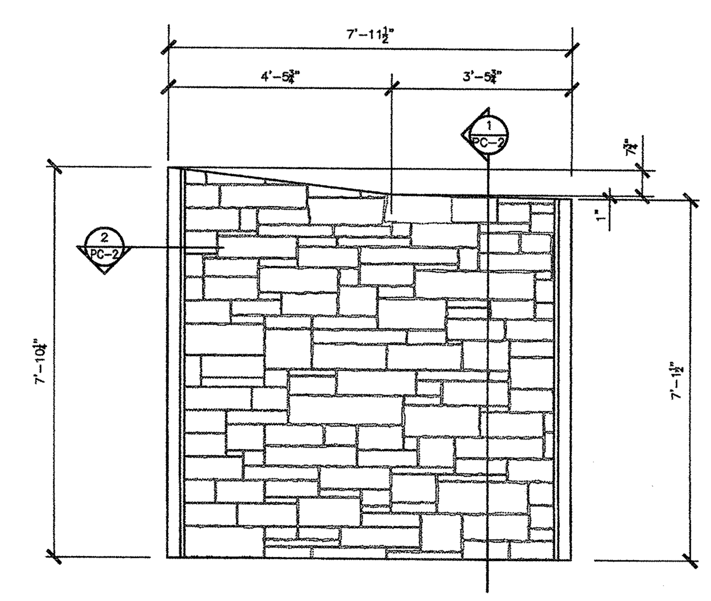

ELEVATION PC39 (1 pc)
3/4" = 1'-0"

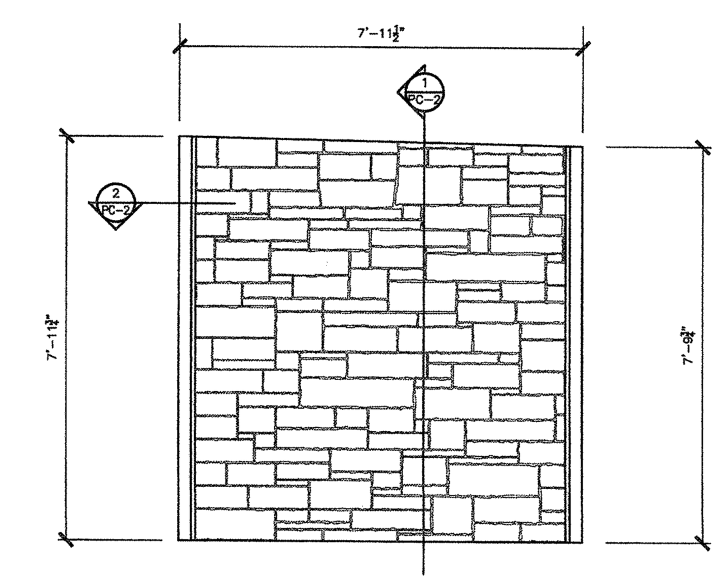

ELEVATION PC40 (1 pc)
3/4" = 1'-0"

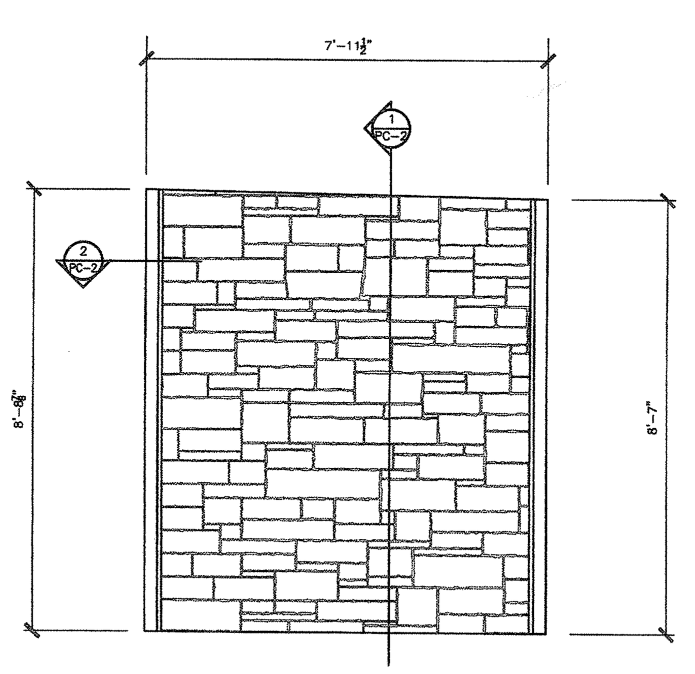

ELEVATION PC41 (1 pc)
3/4" = 1'-0"

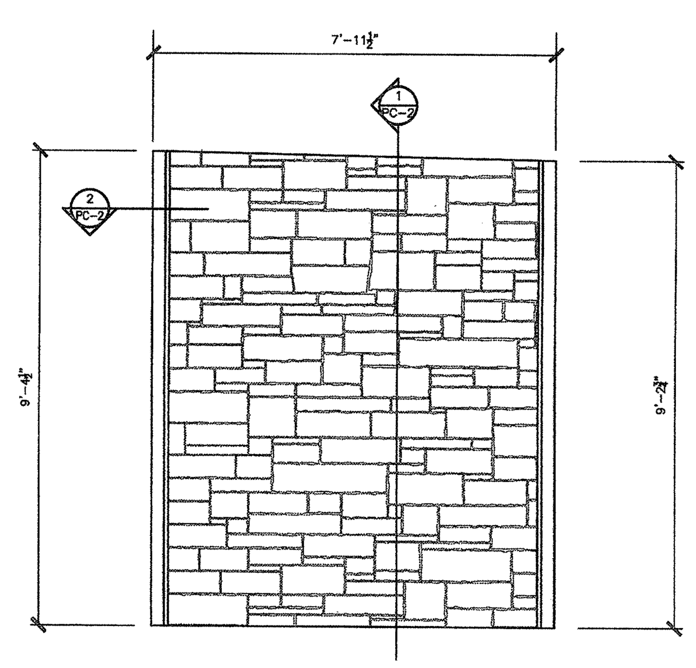

ELEVATION PC42 (1 pc)
3/4" = 1'-0"

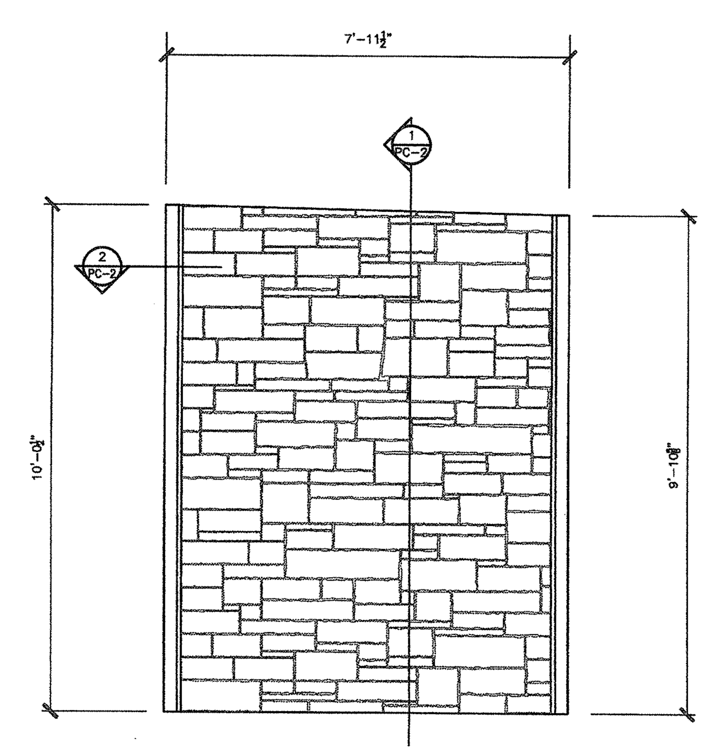

ELEVATION PC43 (1 pc)
3/4" = 1'-0"

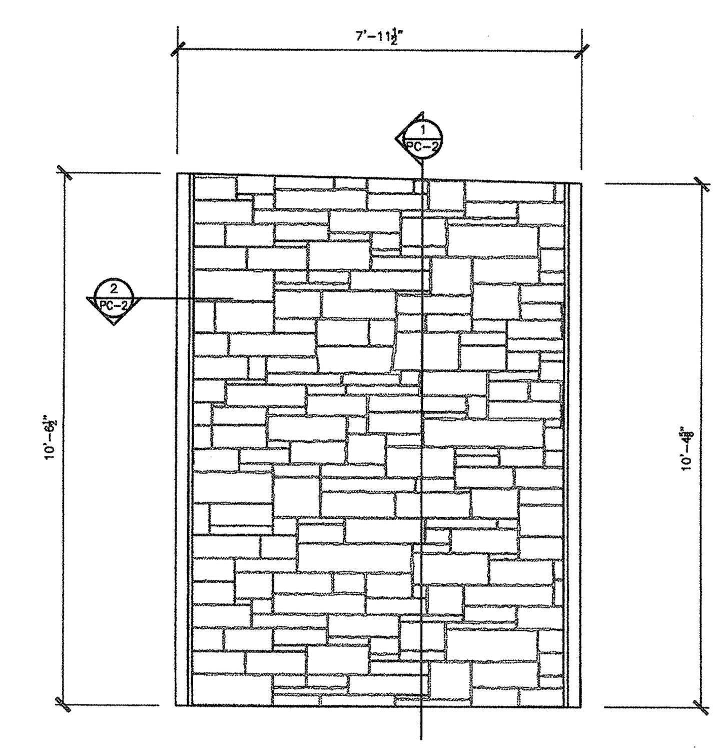

ELEVATION PC44 (1 pc)
3/4" = 1'-0"

* contractor to verify dimensions

NOTE:
SEE SHEET PC-5 FOR PANEL REINFORCING, DETAILS AND NOTES.

GRISWOLD
S.T. Griswold & Co. Inc.
193 Industrial Ave
PO Box 849
Williston, VT 05495
Ph: 802-658-0201
Fax: 802-658-5869
Architectural Precast Division

NPCA CERTIFIED PLANT

NOTE:

This shop drawing represents ST Griswold's interpretation of the architectural plans and specifications and our contract requirements for this project.

Prior to manufacture of product from this drawing, all dimensions, method of construction, and existing conditions must be checked, revised and approved by ST Griswolds client.

GENERAL NOTES:

1) All mortar and control joints are assumed to be 3/8".
2) All lengths stated are actual lengths.
3) All lengths stated to be verified in field by others:
—Not responsibility of ST Griswold.
4) All loos anchorage to be supplied by others:
—Not responsibility of ST Griswold.

Approval Stamp:

The undersigned has reviewed this drawing and is returning it to ST Griswold with the following approval for fabrication and shipment.

- [ ] Approved
- [x] Approved as Noted
- [ ] Approved as Noted (Resubmit for record)
- [ ] Revise and Resubmit

By: [signature] (Signature) Date: 7/21/08
By: Daniel Howey (Please Print)
Company: Geo Design, Inc.

* Please make note that revisions may effect pricing and lead times

No.	DATE	REVISION

McFarland Johnson
40 FARRELL STREET SOUTH BURLINGTON, VT 05403
Tel: (802) 862-9381 Fax: (802) 862-7450

TOWN OF HART FORD
COUNTY OF WINDSOR
U.S. ROUTE 5 (MAJOR COLLECTOR)
HARTFORD VERMONT

PRECAST ELEVATIONS

DRAWN	APPROVED	PROJ. No.
GAB		17185.00
CHECKED	SCALE	DATE
RED	AS NOTED	6/03/08

PC-10

COPYRIGHT © 2008 McFarland-Johnson, Inc.